RASTER

PARENT PARCEL: 07-00-024-102-001, 07-00-025-108-007
CHILD PARCEL: 07-00-025-108-008, -009 07-00-024-102-049, -050
STARTING POINT: CENTERLINE OF BUTTERNUT RIDGE RD. & ST. RT. 83

NO. 01395

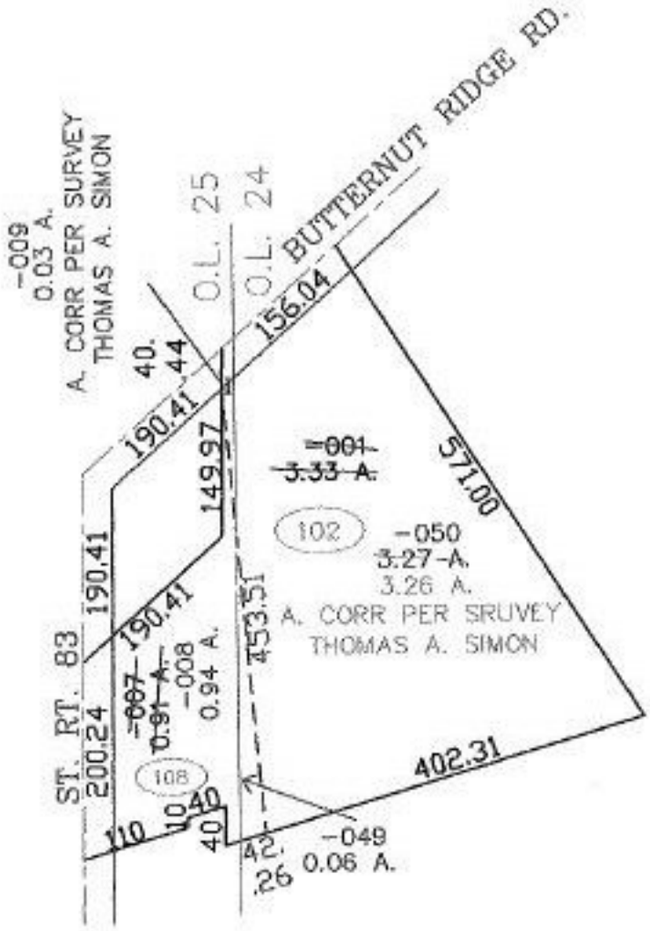

SPLITS/DEEDS PROCESSED
LORAIN COUNTY TAX MAP DEPARTMENT
226 MIDDLE AVE. ELYRIA, OHIO

SURVEYED BY: THOMAS A. SIMON
CLOSURE: 0.00 : 10,000
MAP PAGE(S): 07-00-024-C, -025-D
APPROVED BY: JAH DATE: 6-27-03
SCALE: 1"= 200 PRIOR INSTRUMENT: OR 1175/714