RASTER

PARENT PARCEL: 10-00-003-112-011, -014

CHILD PARCEL: 10-00-003-112-021 THRU -025

STARTING POINT: CENTERLINE OF OBERLIN-ELYRIA RD. & HADAWAY AVE.

NO. 01410

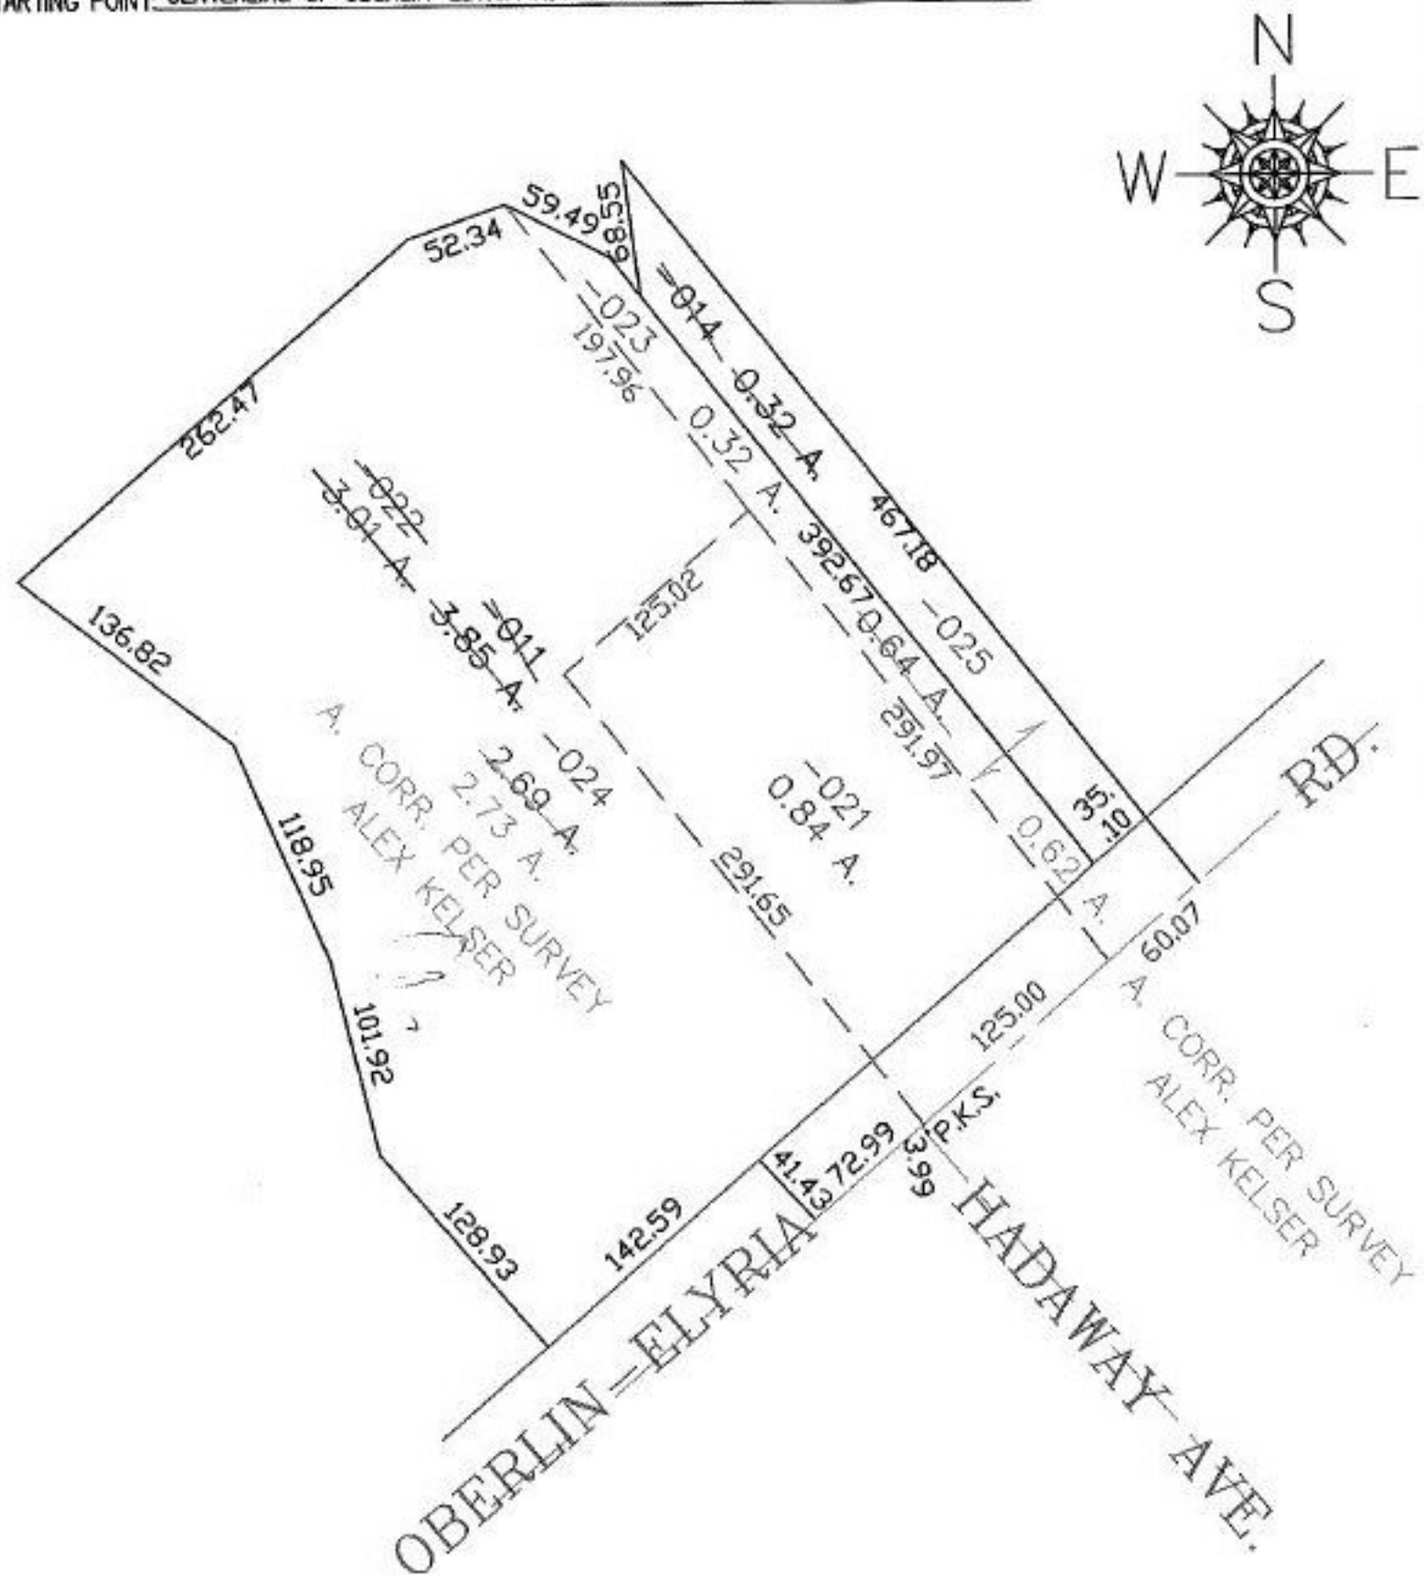

SPLITS/DEEDS PROCESSED

LORAIN COUNTY TAX MAP DEPARTMENT
226 MIDDLE AVE. ELYRIA, OHIO

SURVEYED BY: ALEX KELSER

CLOSURE: 0.00 : 10,000

MAP PAGE(S): 10-00-003-B

APPROVED BY: JAH DATE: 07-15-03

SCALE: 1" = 100 PRIOR INSTRUMENT: 20030918468