PARENT PARCEL: 04-00-002-102-030, -038

CHILD PARCEL: 04-00-002-102-124, -125

STARTING POINT: CENTERLINE OF MOON RD. & DETROIT RD.

NO. 01438

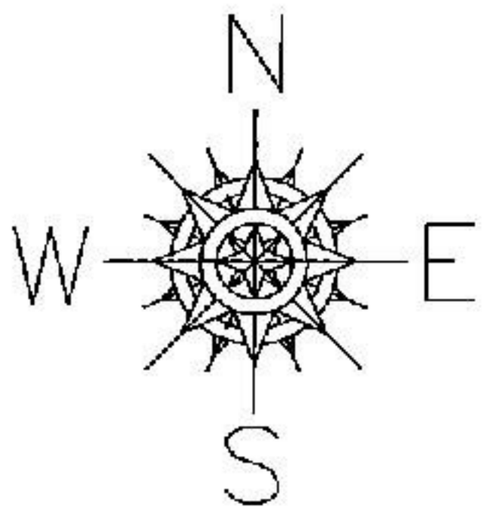

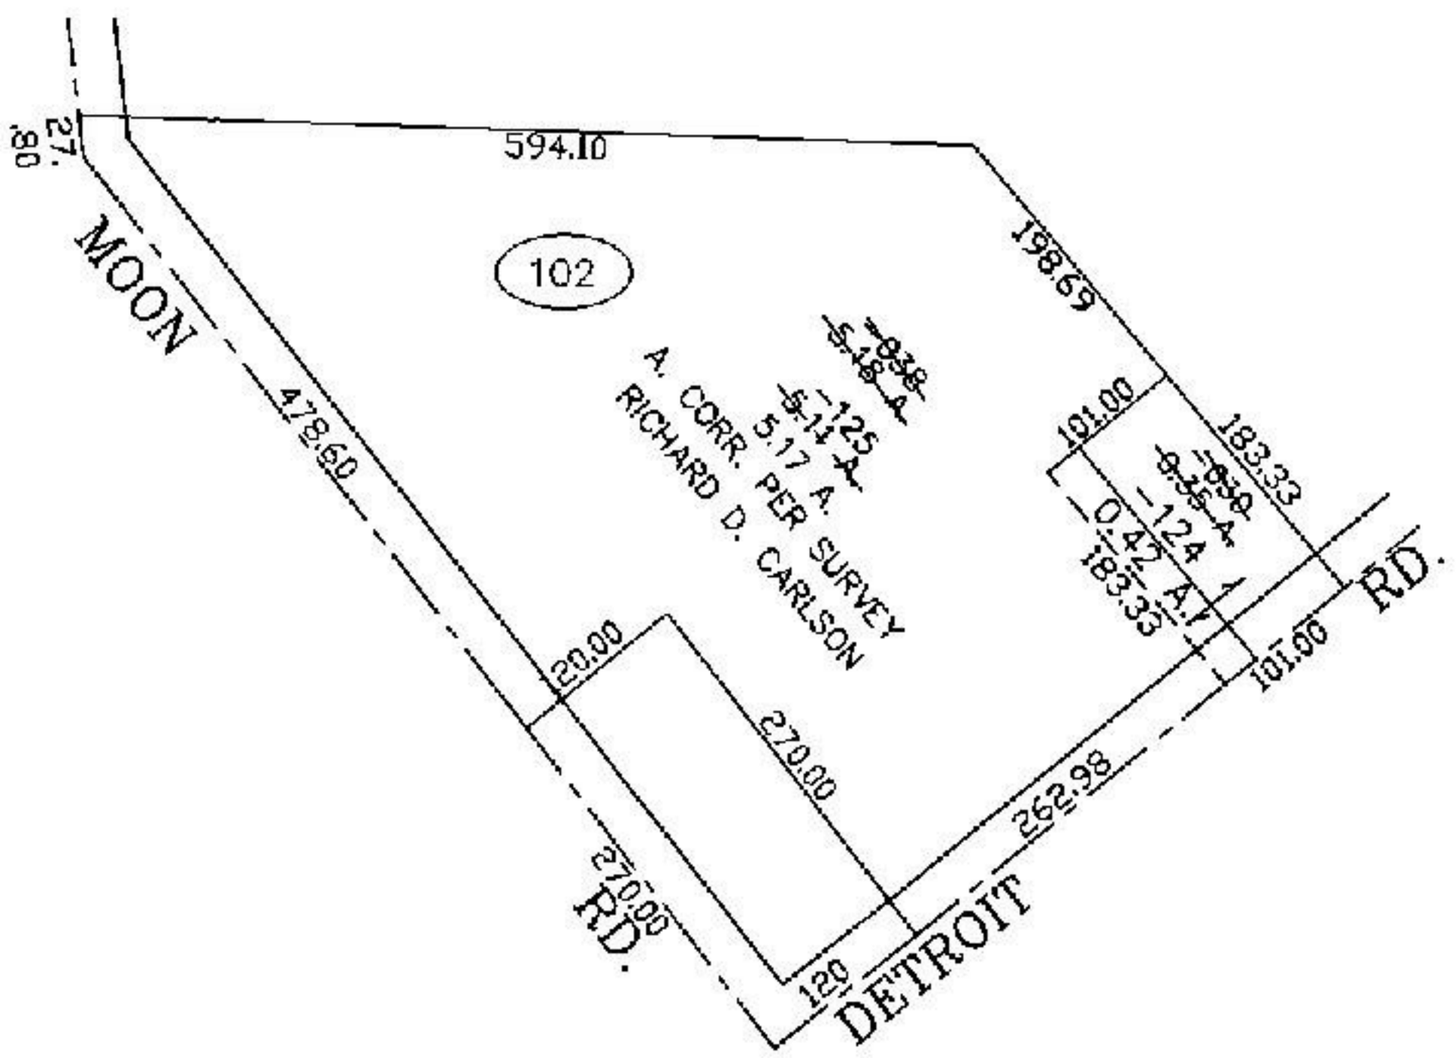

SPLITS/DEEDS PROCESSED

LORAIN COUNTY TAX MAP DEPARTMENT
226 MIDDLE AVE. ELYRIA, OHIO

SURVEYED BY: RICHARD D. CARLSON

CLOSURE: 0.00 : 10,000

MAP PAGE(S): 04-00-002-B

APPROVED BY: JAH DATE: 8-22-03

SCALE: 1"= 200 PRIOR INSTRUMENT: OR 1008/412