RASTER

PARENT PARCEL: 04-00-015-101-124, -063, -042, -044

CHILD PARCEL: 04-00-015-101-126

STARTING POINT: CENTERLINE OF GARDEN DR. & DETROIT RD.

NO. 01439-1

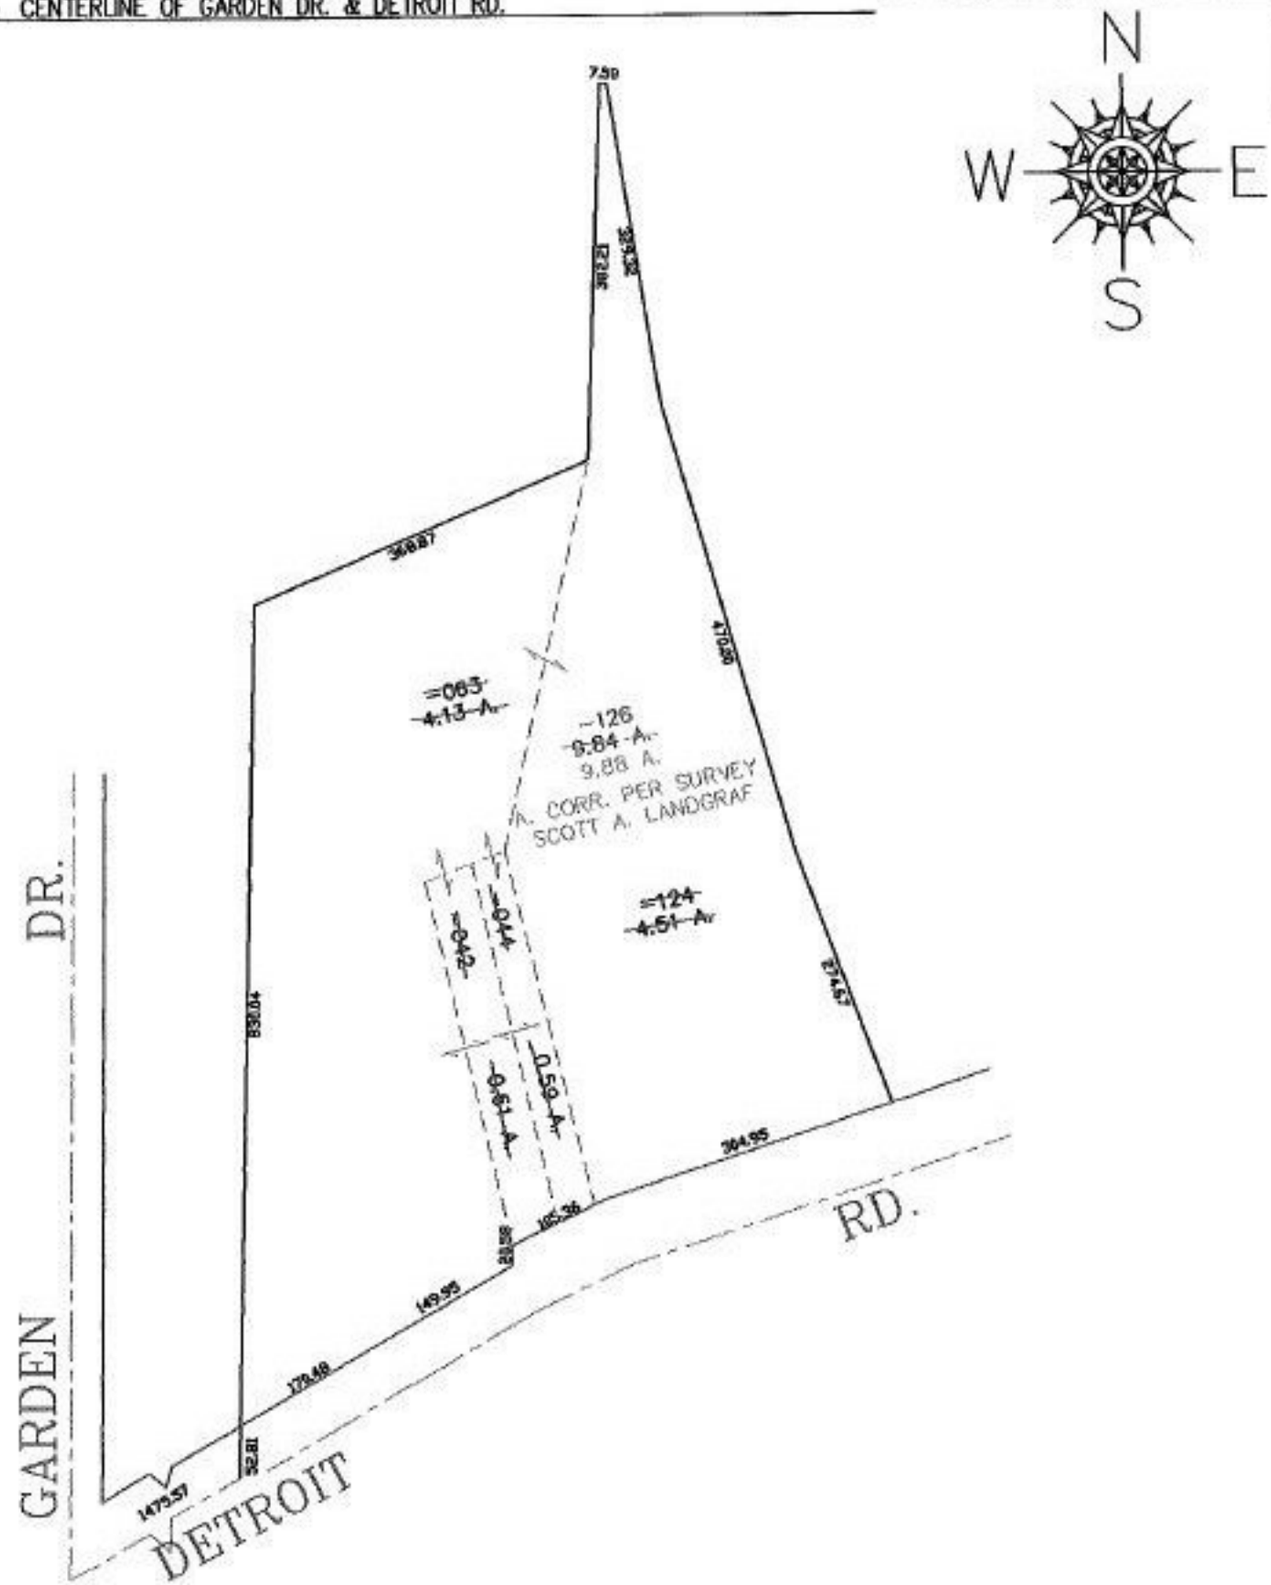

SPLITS/DEEDS PROCESSED

LORAIN COUNTY TAX MAP DEPARTMENT
226 MIDDLE AVE. ELYRIA, OHIO

SURVEYED BY: SCOTT A. LANDGRAF

CLOSURE: 0.00 : 10,000

MAP PAGE(S): 04-00-015-B

APPROVED BY: JAH DATE: 8-25-03

SCALE: 1"= 200 PRIOR INSTRUMENT: 20020854413