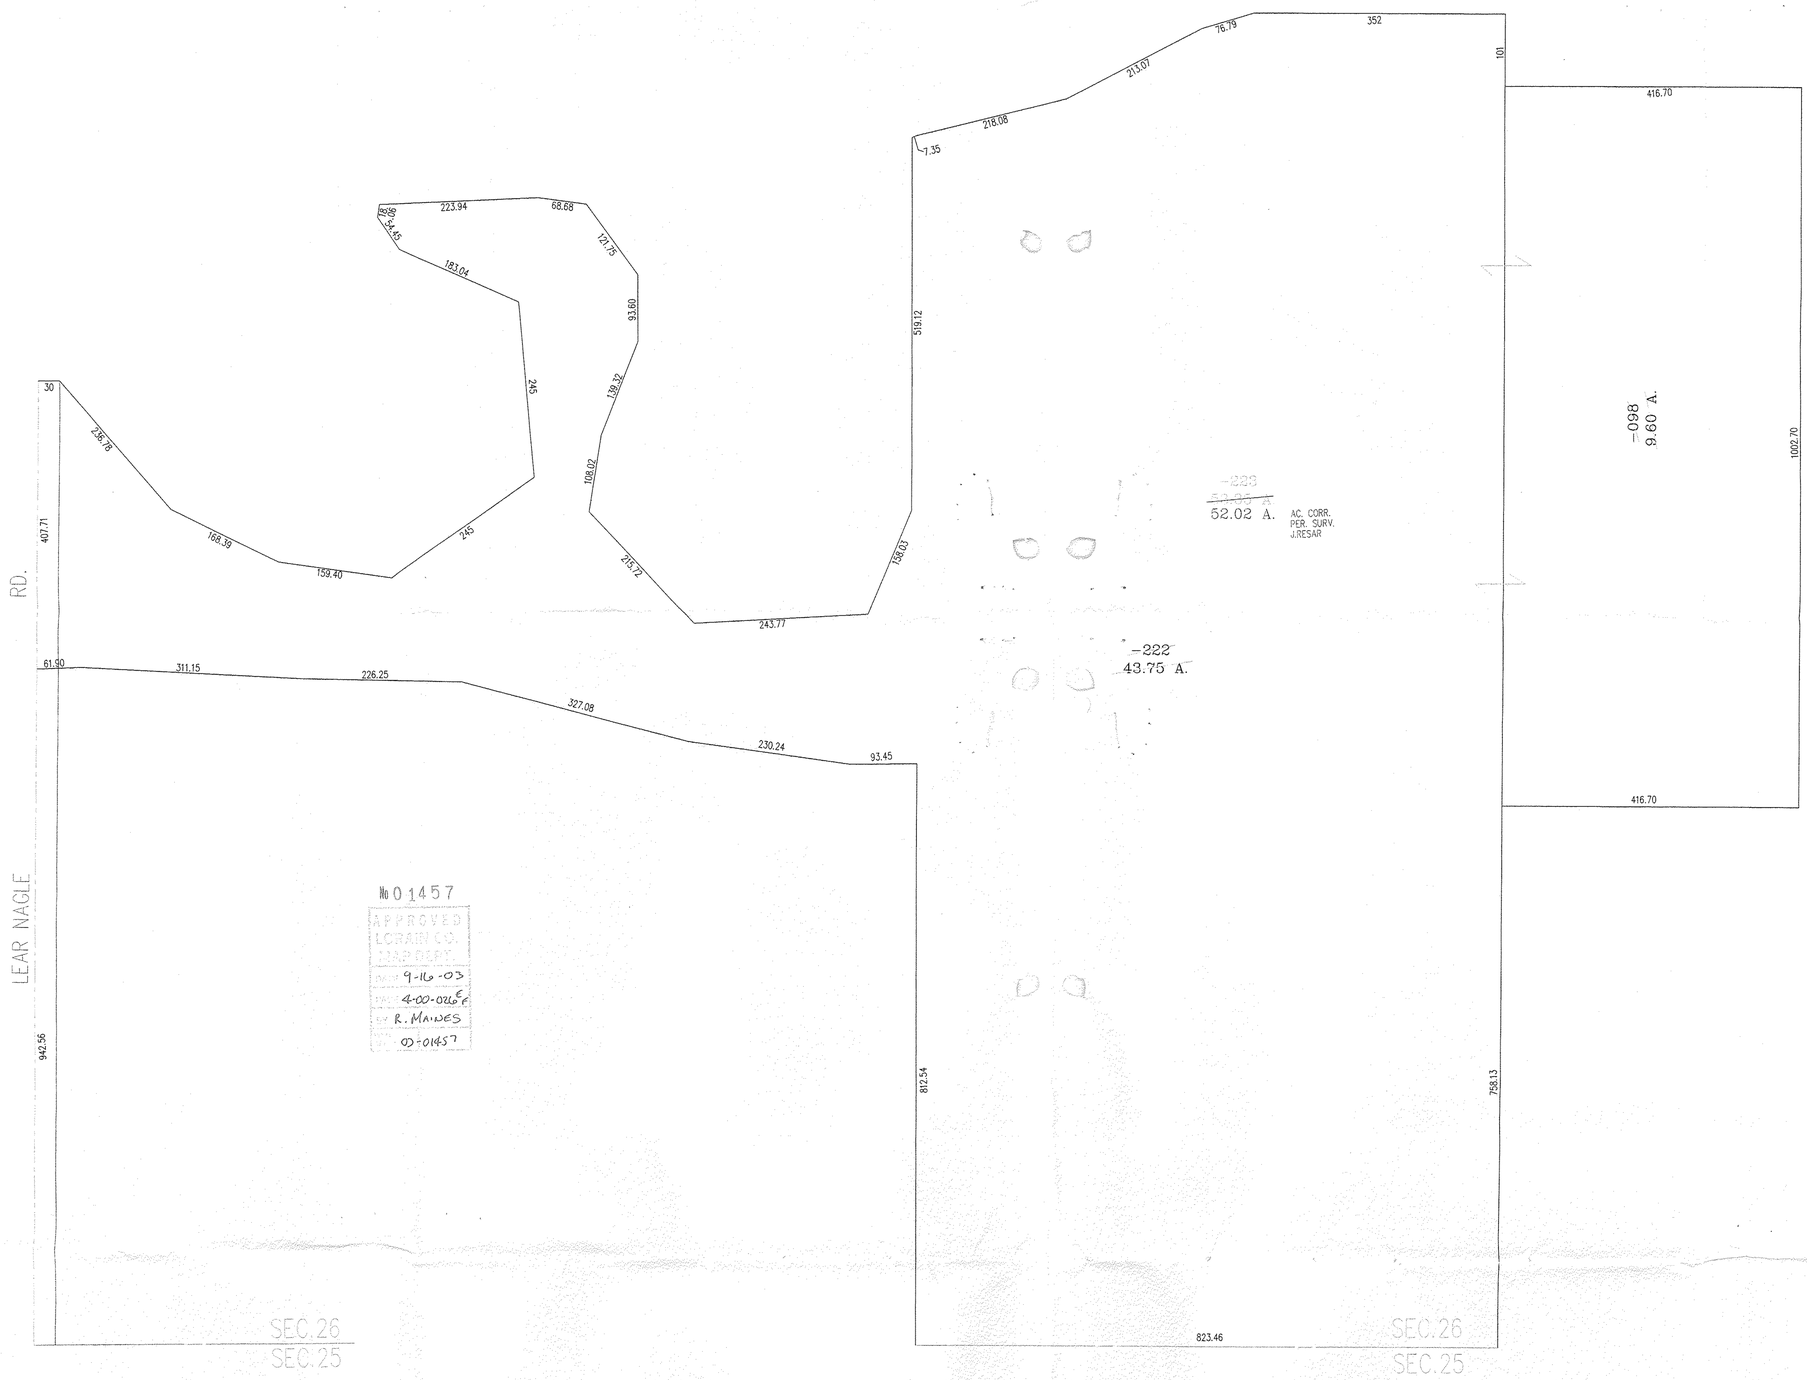
LEAR NAGLE RD.
30
407.71
61.90
311.15
226.25
327.08
230.24
93.45
942.56
812.54
823.46
758.13
416.70
416.70
1002.70
352
101
76.79
213.07
218.08
7.35
519.12
158.03
243.77
215.72
108.02
139.32
93.60
121.75
68.68
223.94
108.50
54.45
183.04
245
245
159.40
168.39
236.78
-098
9.60 A.
-223
52.02 A.
AC. CORR.
PER. SURV.
J.RESAR
-222
43.75 A.
No 01457
APPROVED
LORAIN CO.
MAP DEPT.
9-16-03
4-00-026 E
R. MANDES
03-01457
SEC.26
SEC.25
SEC.26
SEC.25