PARENT PARCEL: 03-00-012-000-175
CHILD PARCEL: 03-00-012-000-178, -179
STARTING POINT: CENTERLINE OF NORTH RIDGE RD. & O.L. 11

NO. 01468

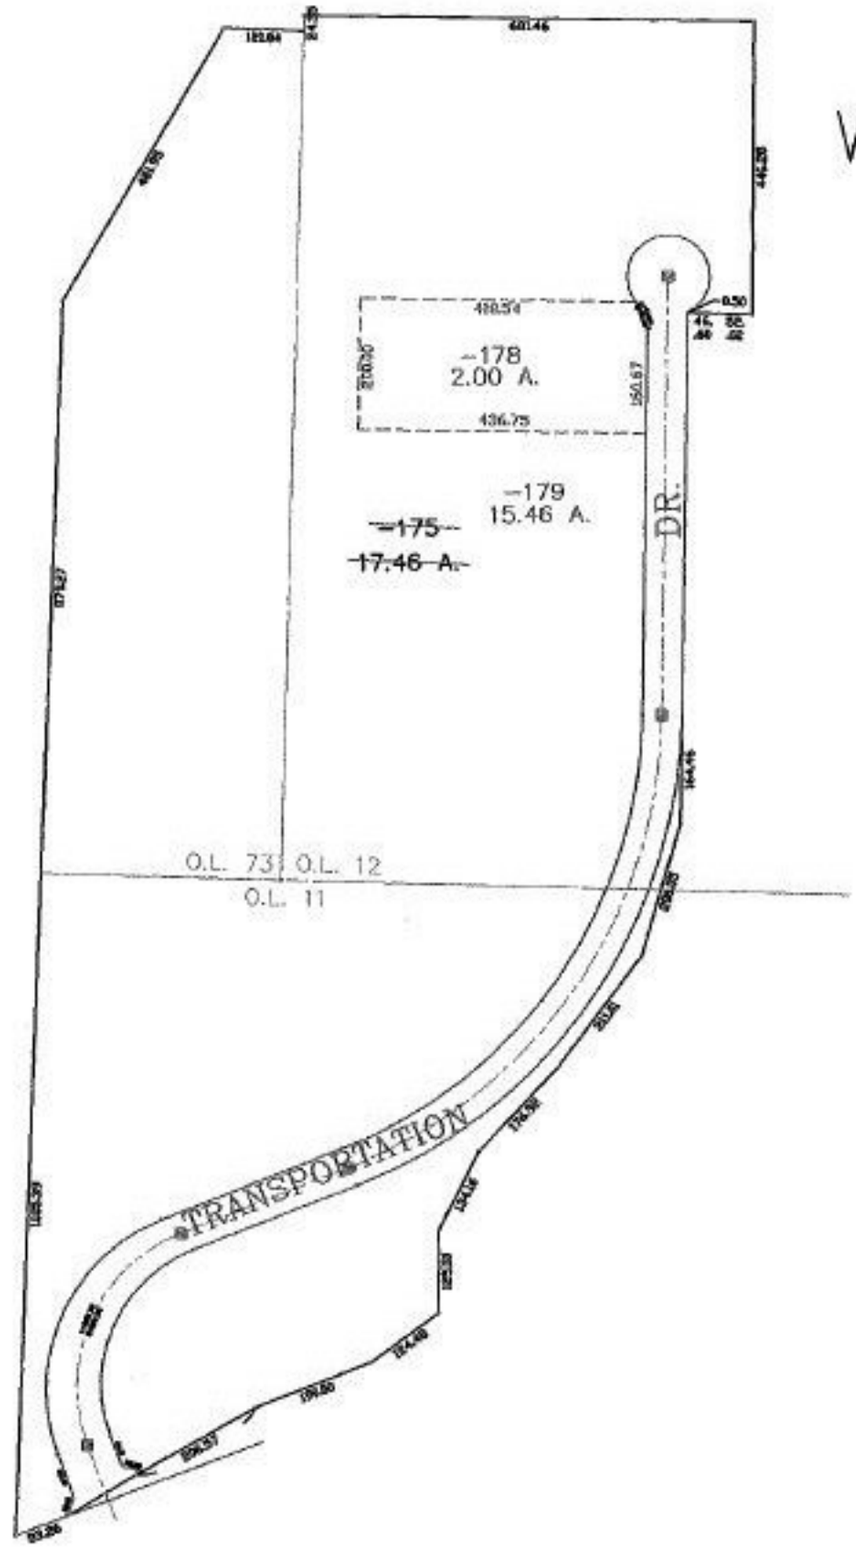

SPLITS/DEEDS PROCESSED
LORAIN COUNTY TAX MAP DEPARTMENT
226 MIDDLE AVE. ELYRIA, OHIO

SURVEYED BY: MICHAEL BRAMHALL
CLOSURE: 0.00 : 10,000
MAP PAGE(S): 3-00-012-A
APPROVED BY: JAH DATE: 10-30-03
SCALE: 1" = 300 PRIOR INSTRUMENT: 99090593447