RASTER

PARENT PARCEL: 07-00-019-000-170
CHILD PARCEL: 07-00-019-000-430,-431
STARTING POINT: INTERSECTION OF C/L OF MILLS RD. AND C/L OF S.R.83

NO. 01527

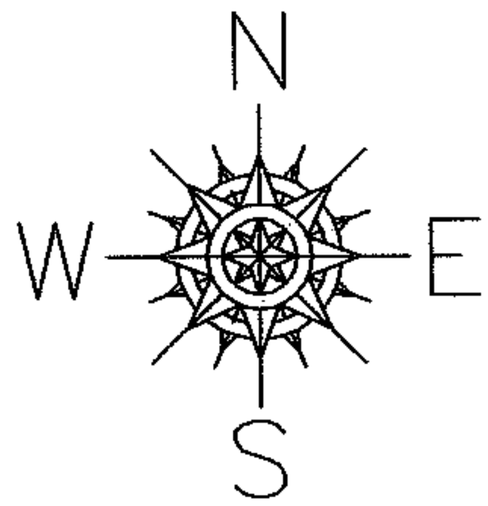

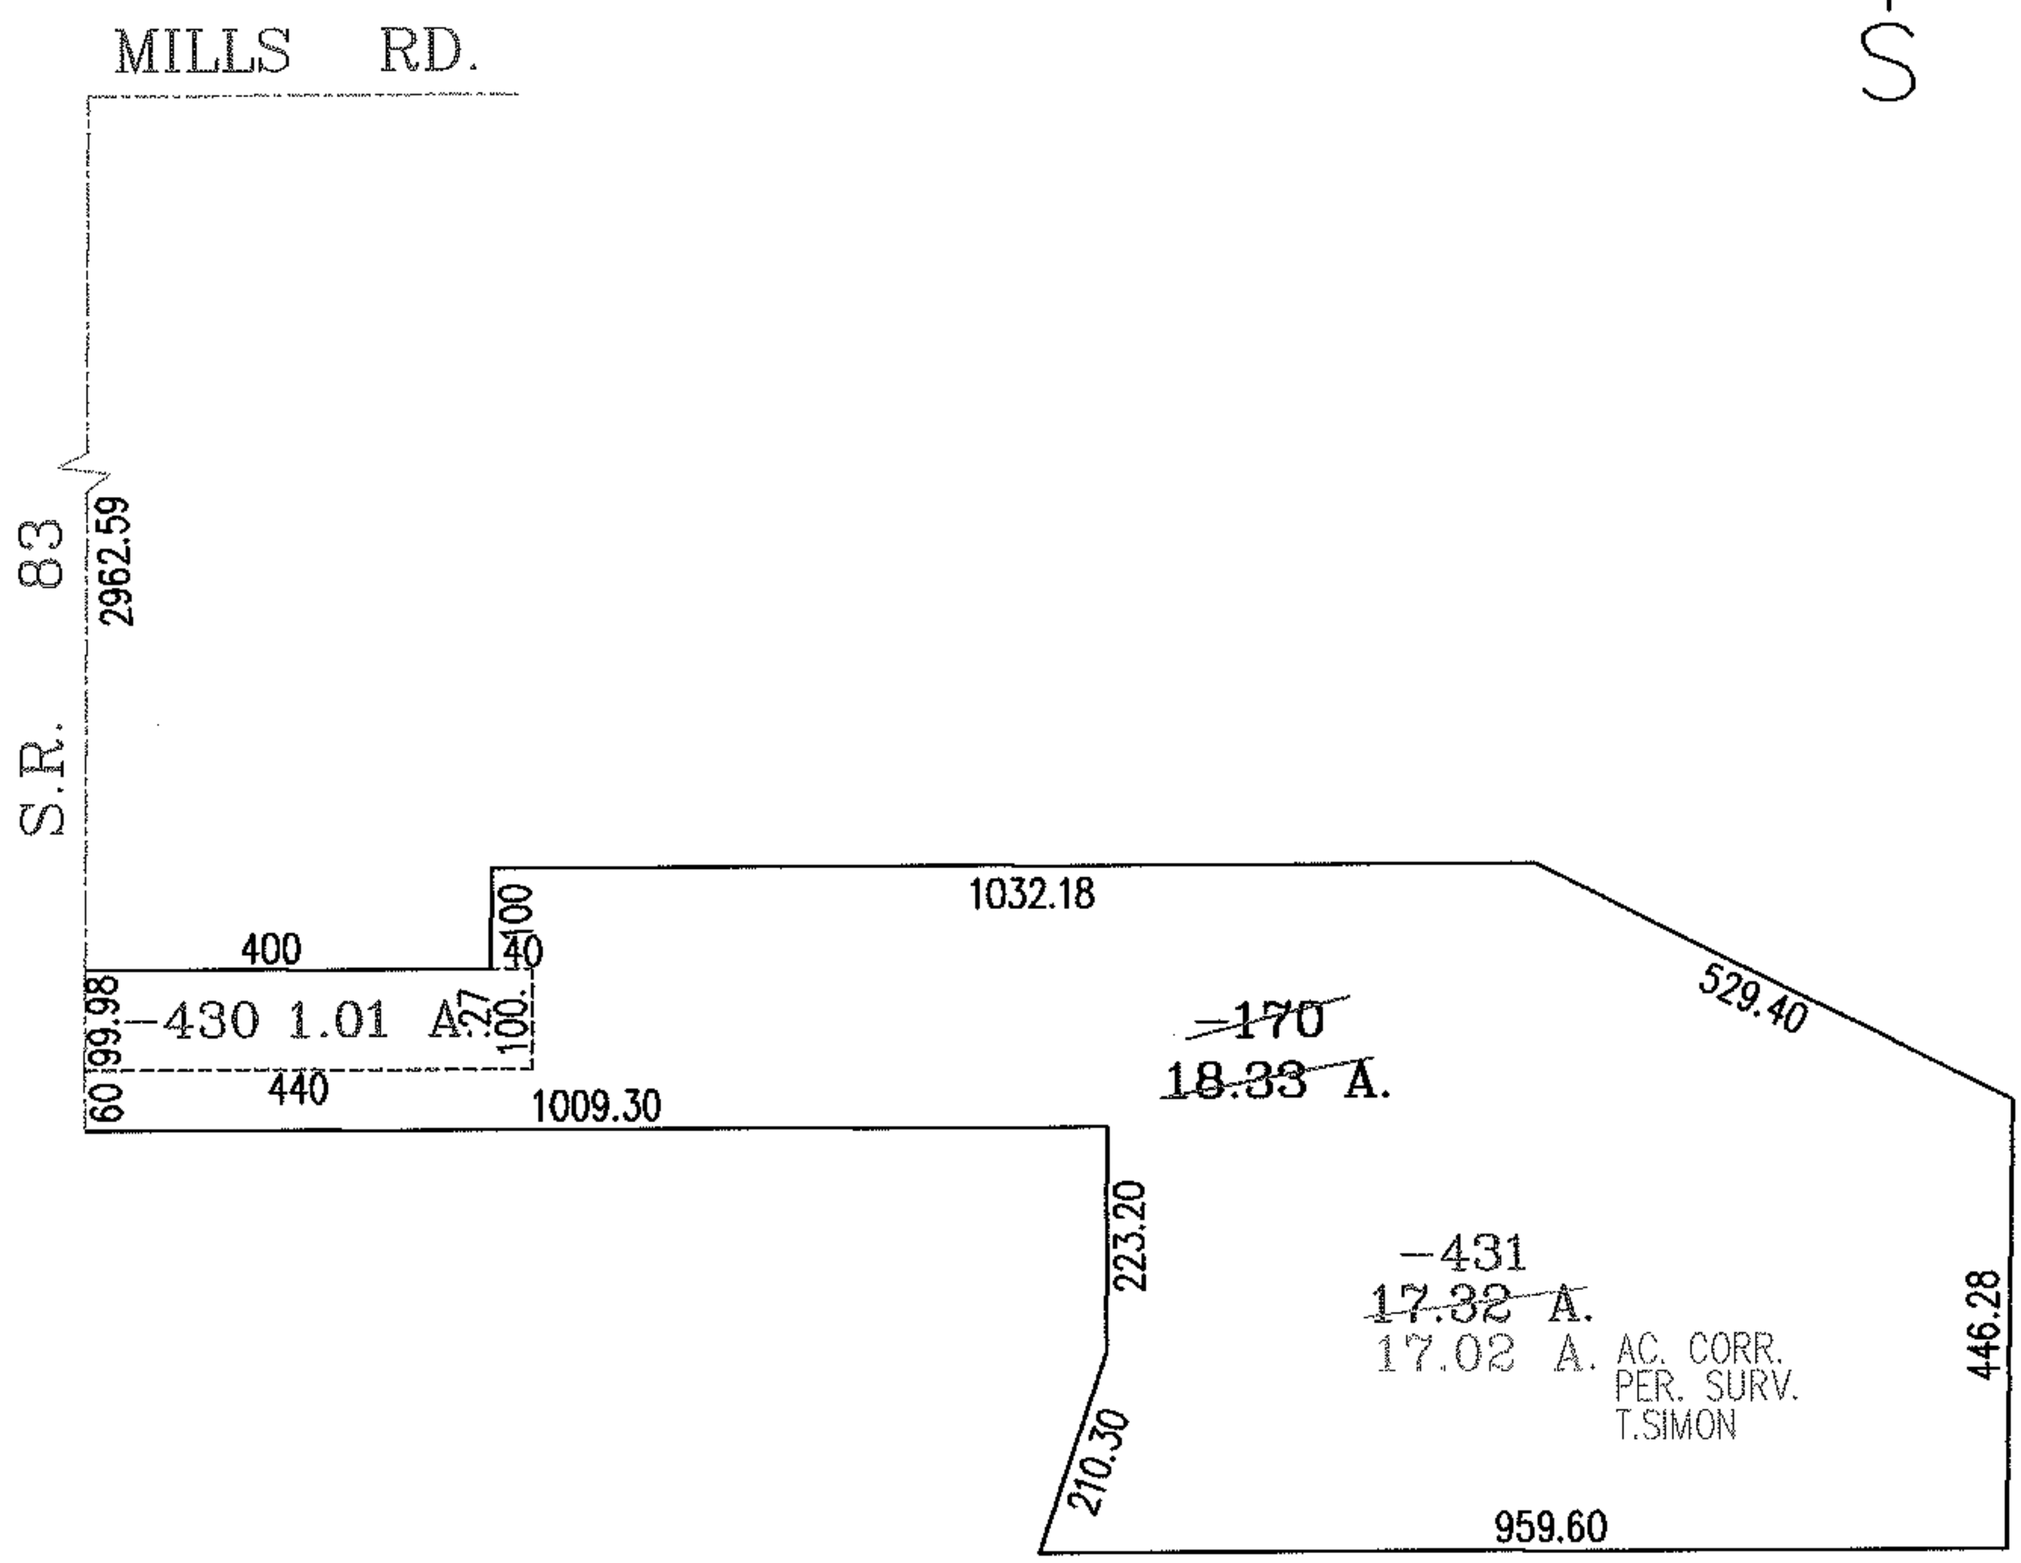

SPLITS/DEEDS PROCESSED
LORAIN COUNTY TAX MAP DEPARTMENT
226 MIDDLE AVE. ELYRIA, OHIO

SURVEYED BY: THOMAS A. SIMON
CLOSURE: .01:10,000
MAP PAGE(S): 07-00-019-C
APPROVED BY: RRM DATE: 12-2-03
SCALE: 1"= 300 PRIOR INSTRUMENT: DV 691/514