RASTER

PARENT PARCEL: 11-00-015-000-001,11-00-026-000-027,-043
CHILD PARCEL: 11-00-015-000-018,-019,11-00-026-000-045,-046
STARTING POINT: INTERSECTION OF C/L OF ISLAND RD. AND C/L OF S.R.82

NO. 01534

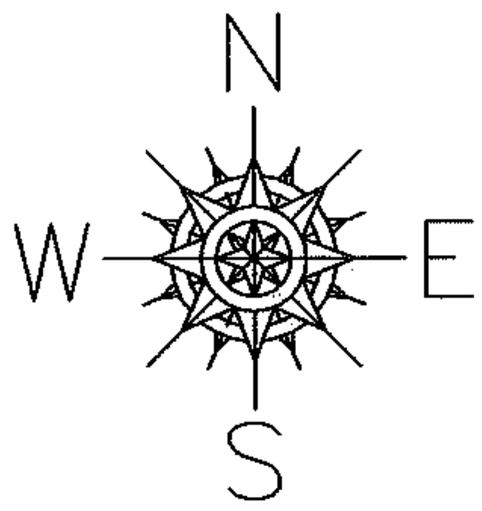

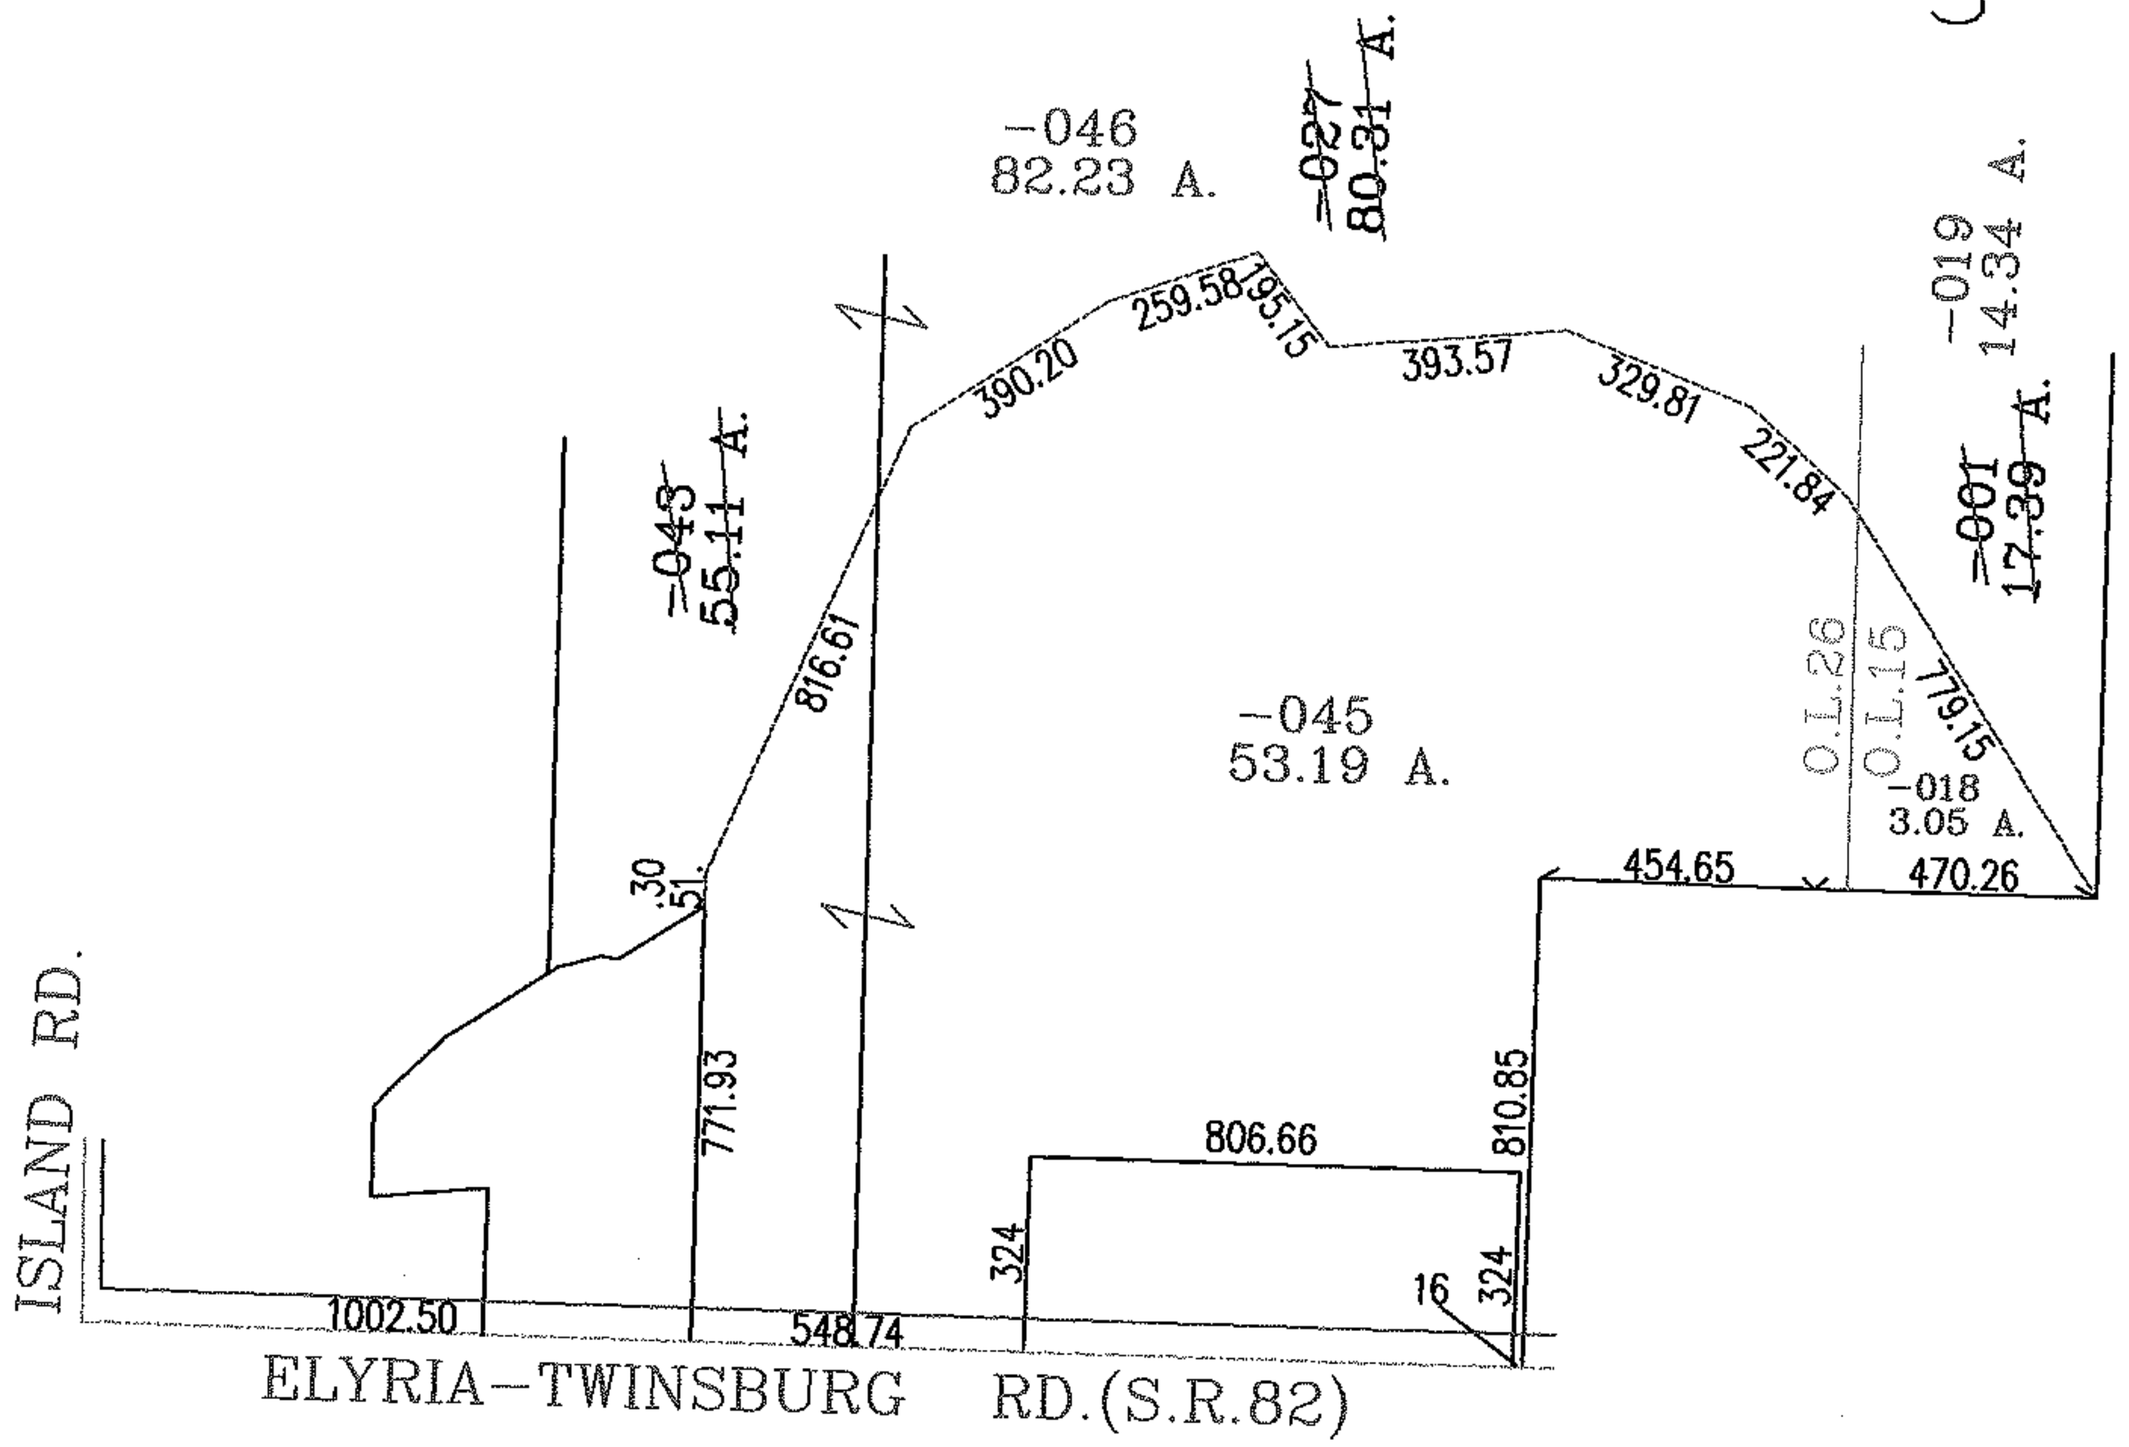

SPLITS/DEEDS PROCESSED

LORAIN COUNTY TAX MAP DEPARTMENT
226 MIDDLE AVE. ELYRIA, OHIO

SURVEYED BY: DOUGLAS M. MOSLEY
CLOSURE: .13:10,000
MAP PAGE(S): 11-00-015-A,11-00-026-B
APPROVED BY: RRM DATE: 12-5-03
SCALE: 1"= 500 PRIOR INSTRUMENT: