RASTER

PARENT PARCEL: 05-00-032-000-059
CHILD PARCEL: 05-00-032-000-110,-111
STARTING POINT: INTERSECTION OF C/L OF S.R. 58 AND THE EAST LINE OF O.L. 32

NO. 01538

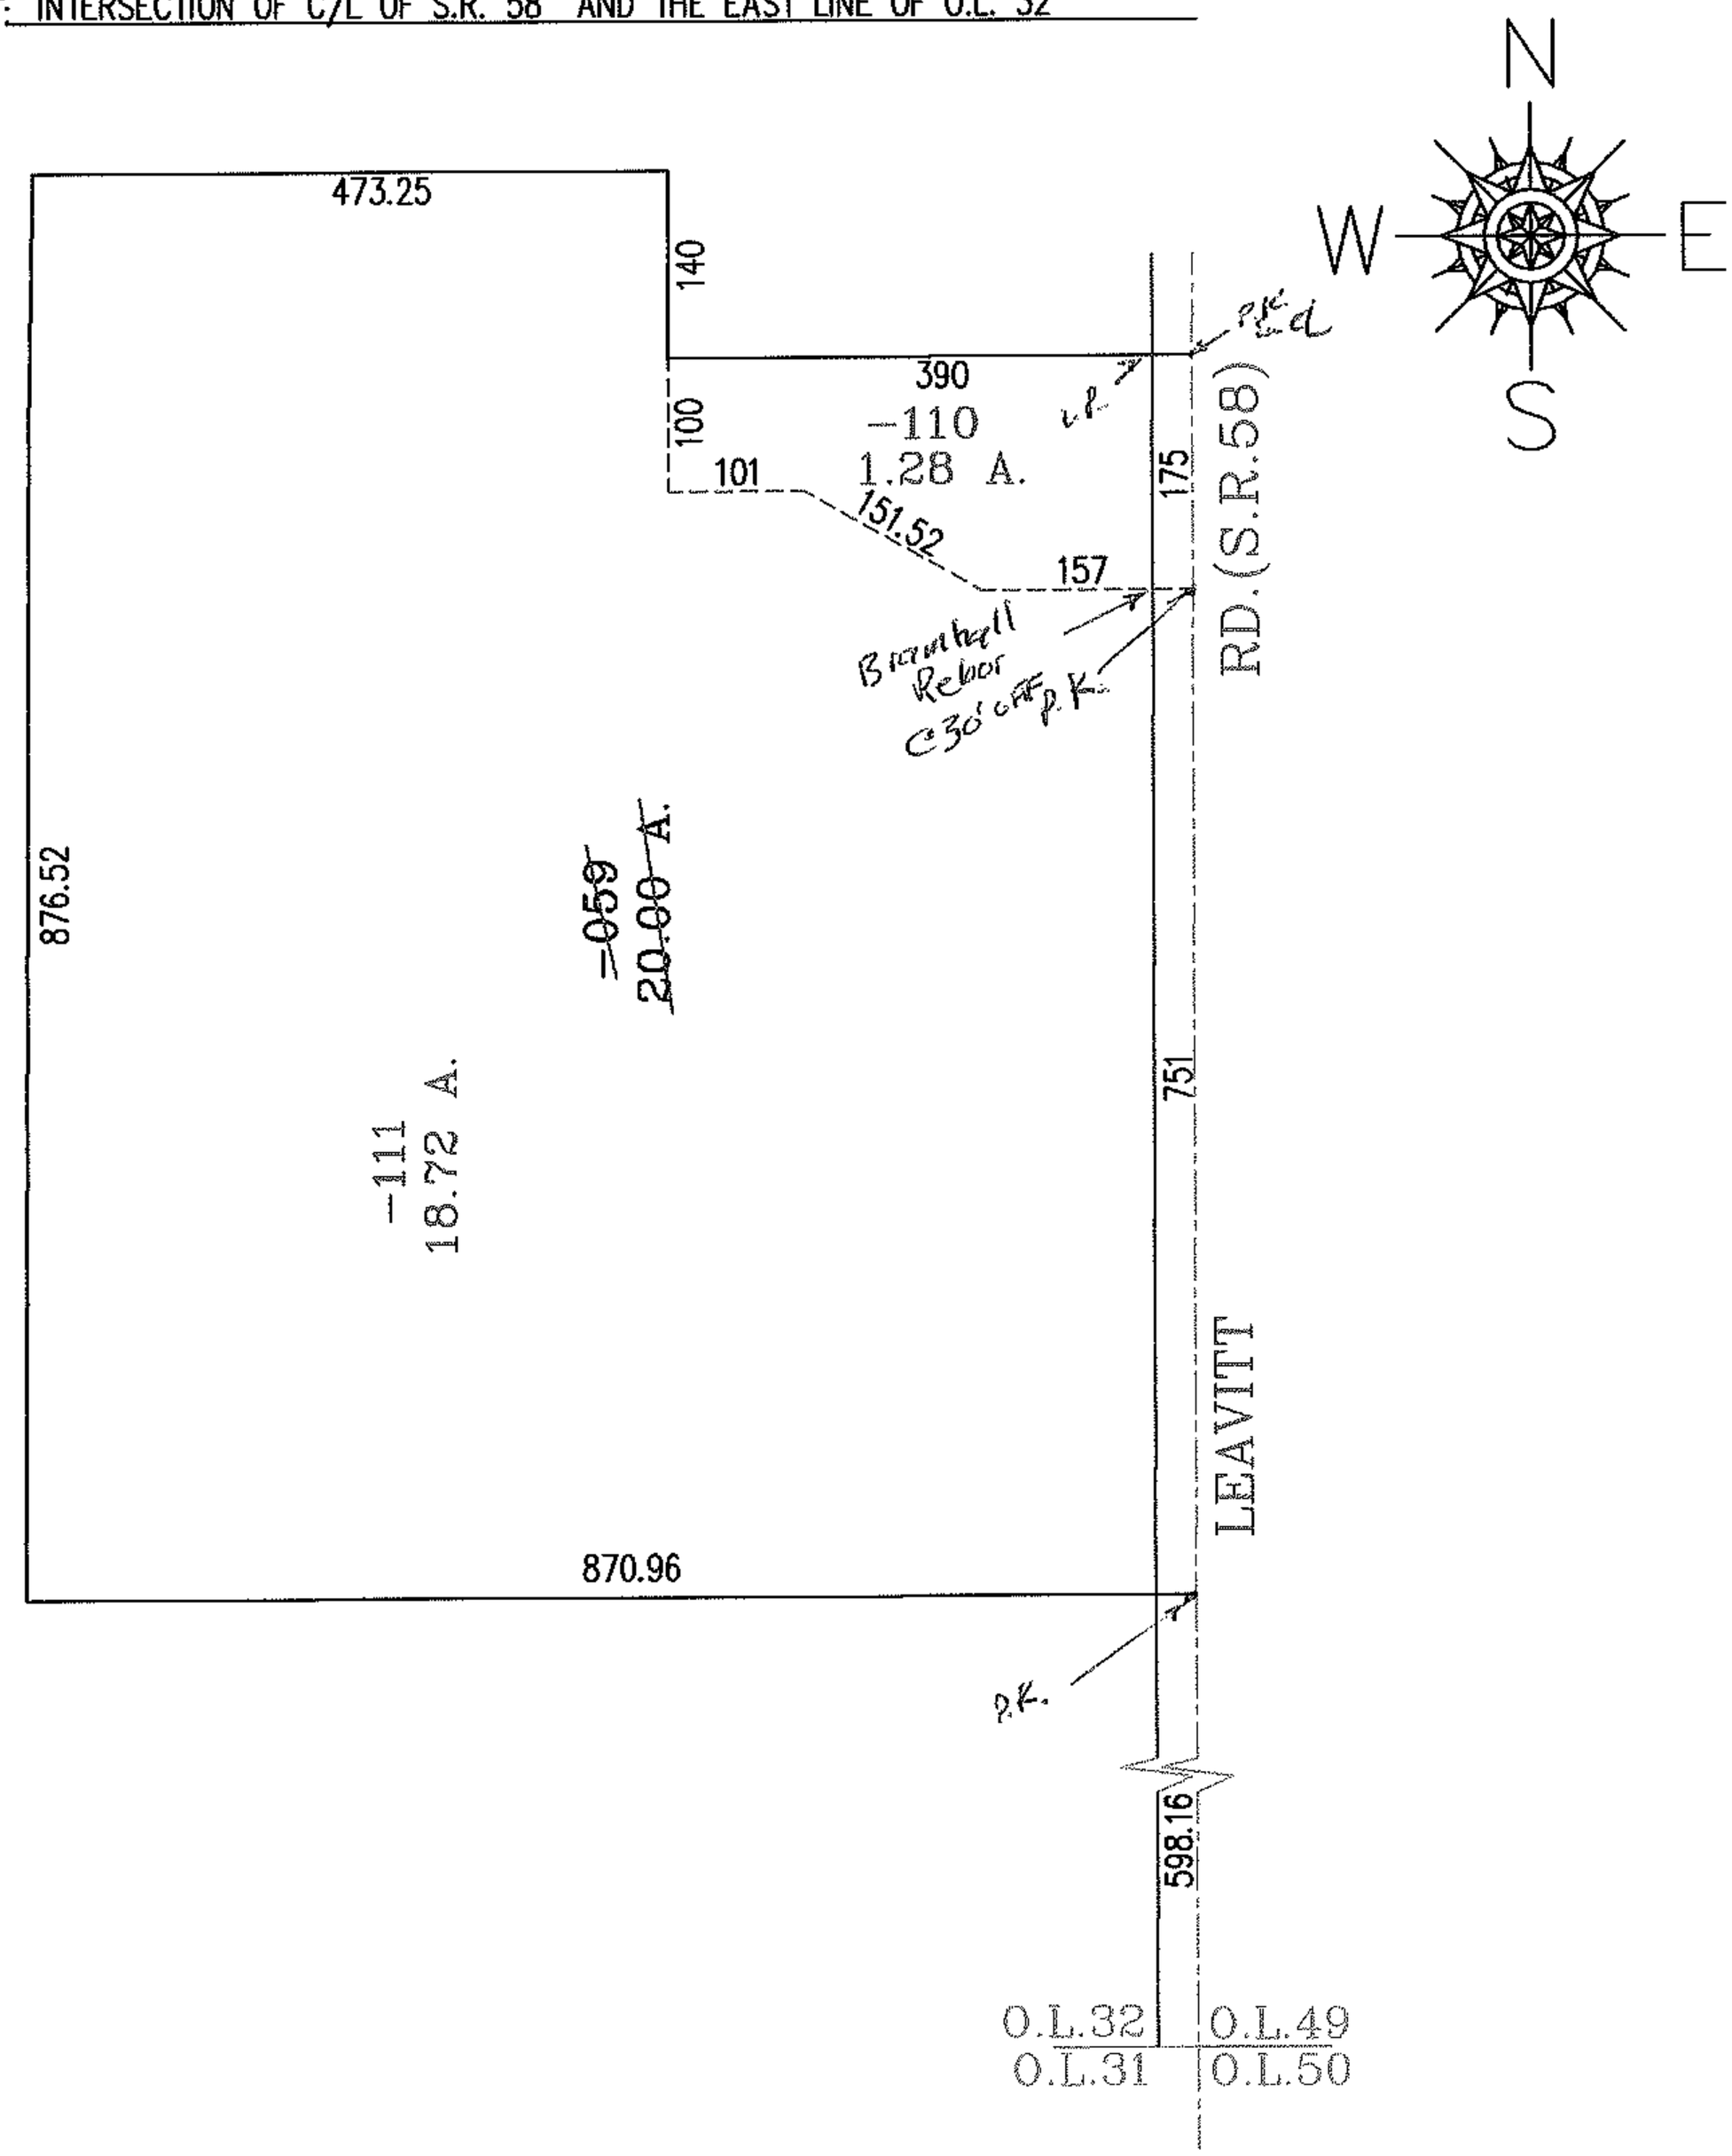

SPLITS/DEEDS PROCESSED
LORAIN COUNTY TAX MAP DEPARTMENT
226 MIDDLE AVE. ELYRIA, OHIO

SURVEYED BY: CHRISTOPHER HIRZEL
CLOSURE: .00:10.000
MAP PAGE(S): 5-00-032-B
APPROVED BY: RRM DATE: 12-5-03
SCALE: 1"= 200 PRIOR INSTRUMENT: DV 295/395