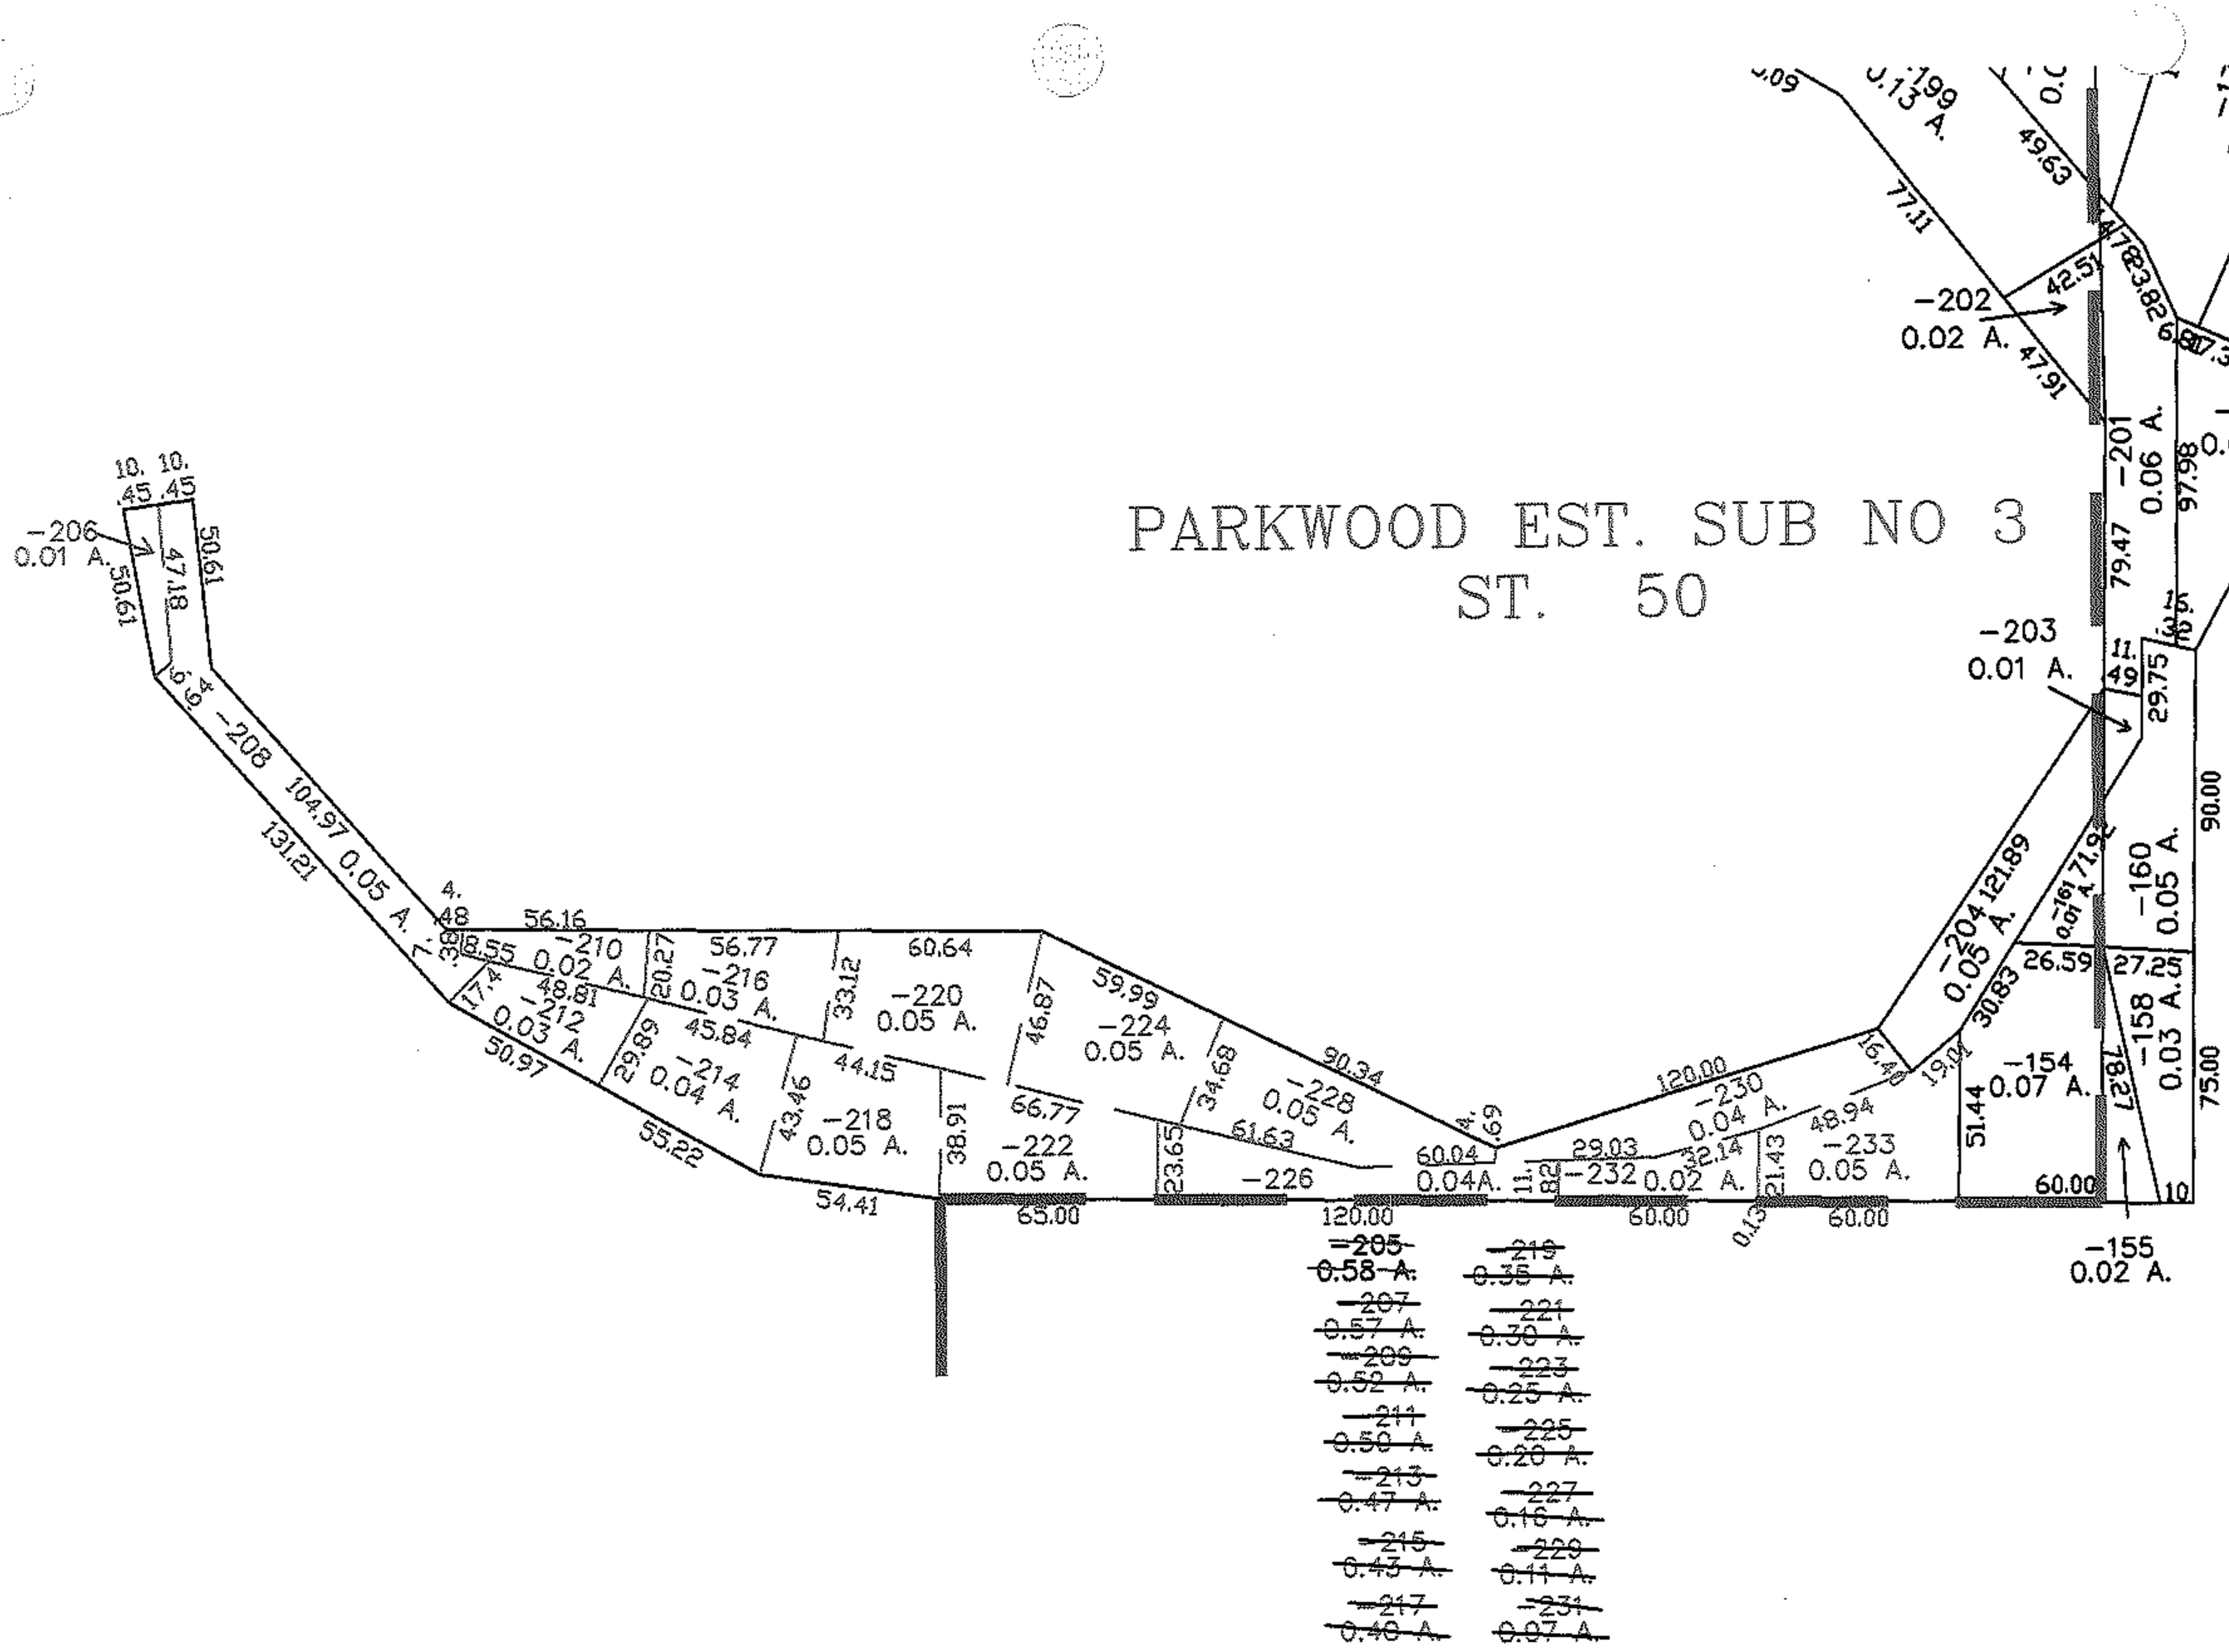
PARKWOOD EST. SUB NO 3
ST. 50
-206
0.01 A.
-208
0.05 A.
-210
0.02 A.
-212
0.03 A.
-214
0.04 A.
-216
0.03 A.
-218
0.05 A.
-220
0.05 A.
-222
0.05 A.
-224
0.05 A.
-226
0.04A.
-228
0.05 A.
-230
0.04 A.
-232
0.02 A.
-233
0.05 A.
-154
0.07 A.
-155
0.02 A.
-158
0.03 A.
-160
0.05 A.
-161
0.01 A.
-164
0.06 A.
-172
0.12 A.
-199
0.13 A.
-201
0.06 A.
-202
0.02 A.
-203
0.01 A.
-204
0.05 A.
-205
0.58 A.
-207
0.57 A.
-209
0.52 A.
-211
0.50 A.
-213
0.47 A.
-215
0.43 A.
-217
0.48 A.
-219
0.35 A.
-221
0.30 A.
-223
0.25 A.
-225
0.20 A.
-227
0.16 A.
-229
0.11 A.
-231
0.07 A.

03-01539