PARENT PARCEL: 04-00-022-102-004, -005

CHILD PARCEL: 04-00-022-102-073

STARTING POINT: CENTERLINE OF LEAR NAGLE RD & O.L. 22

12-03009

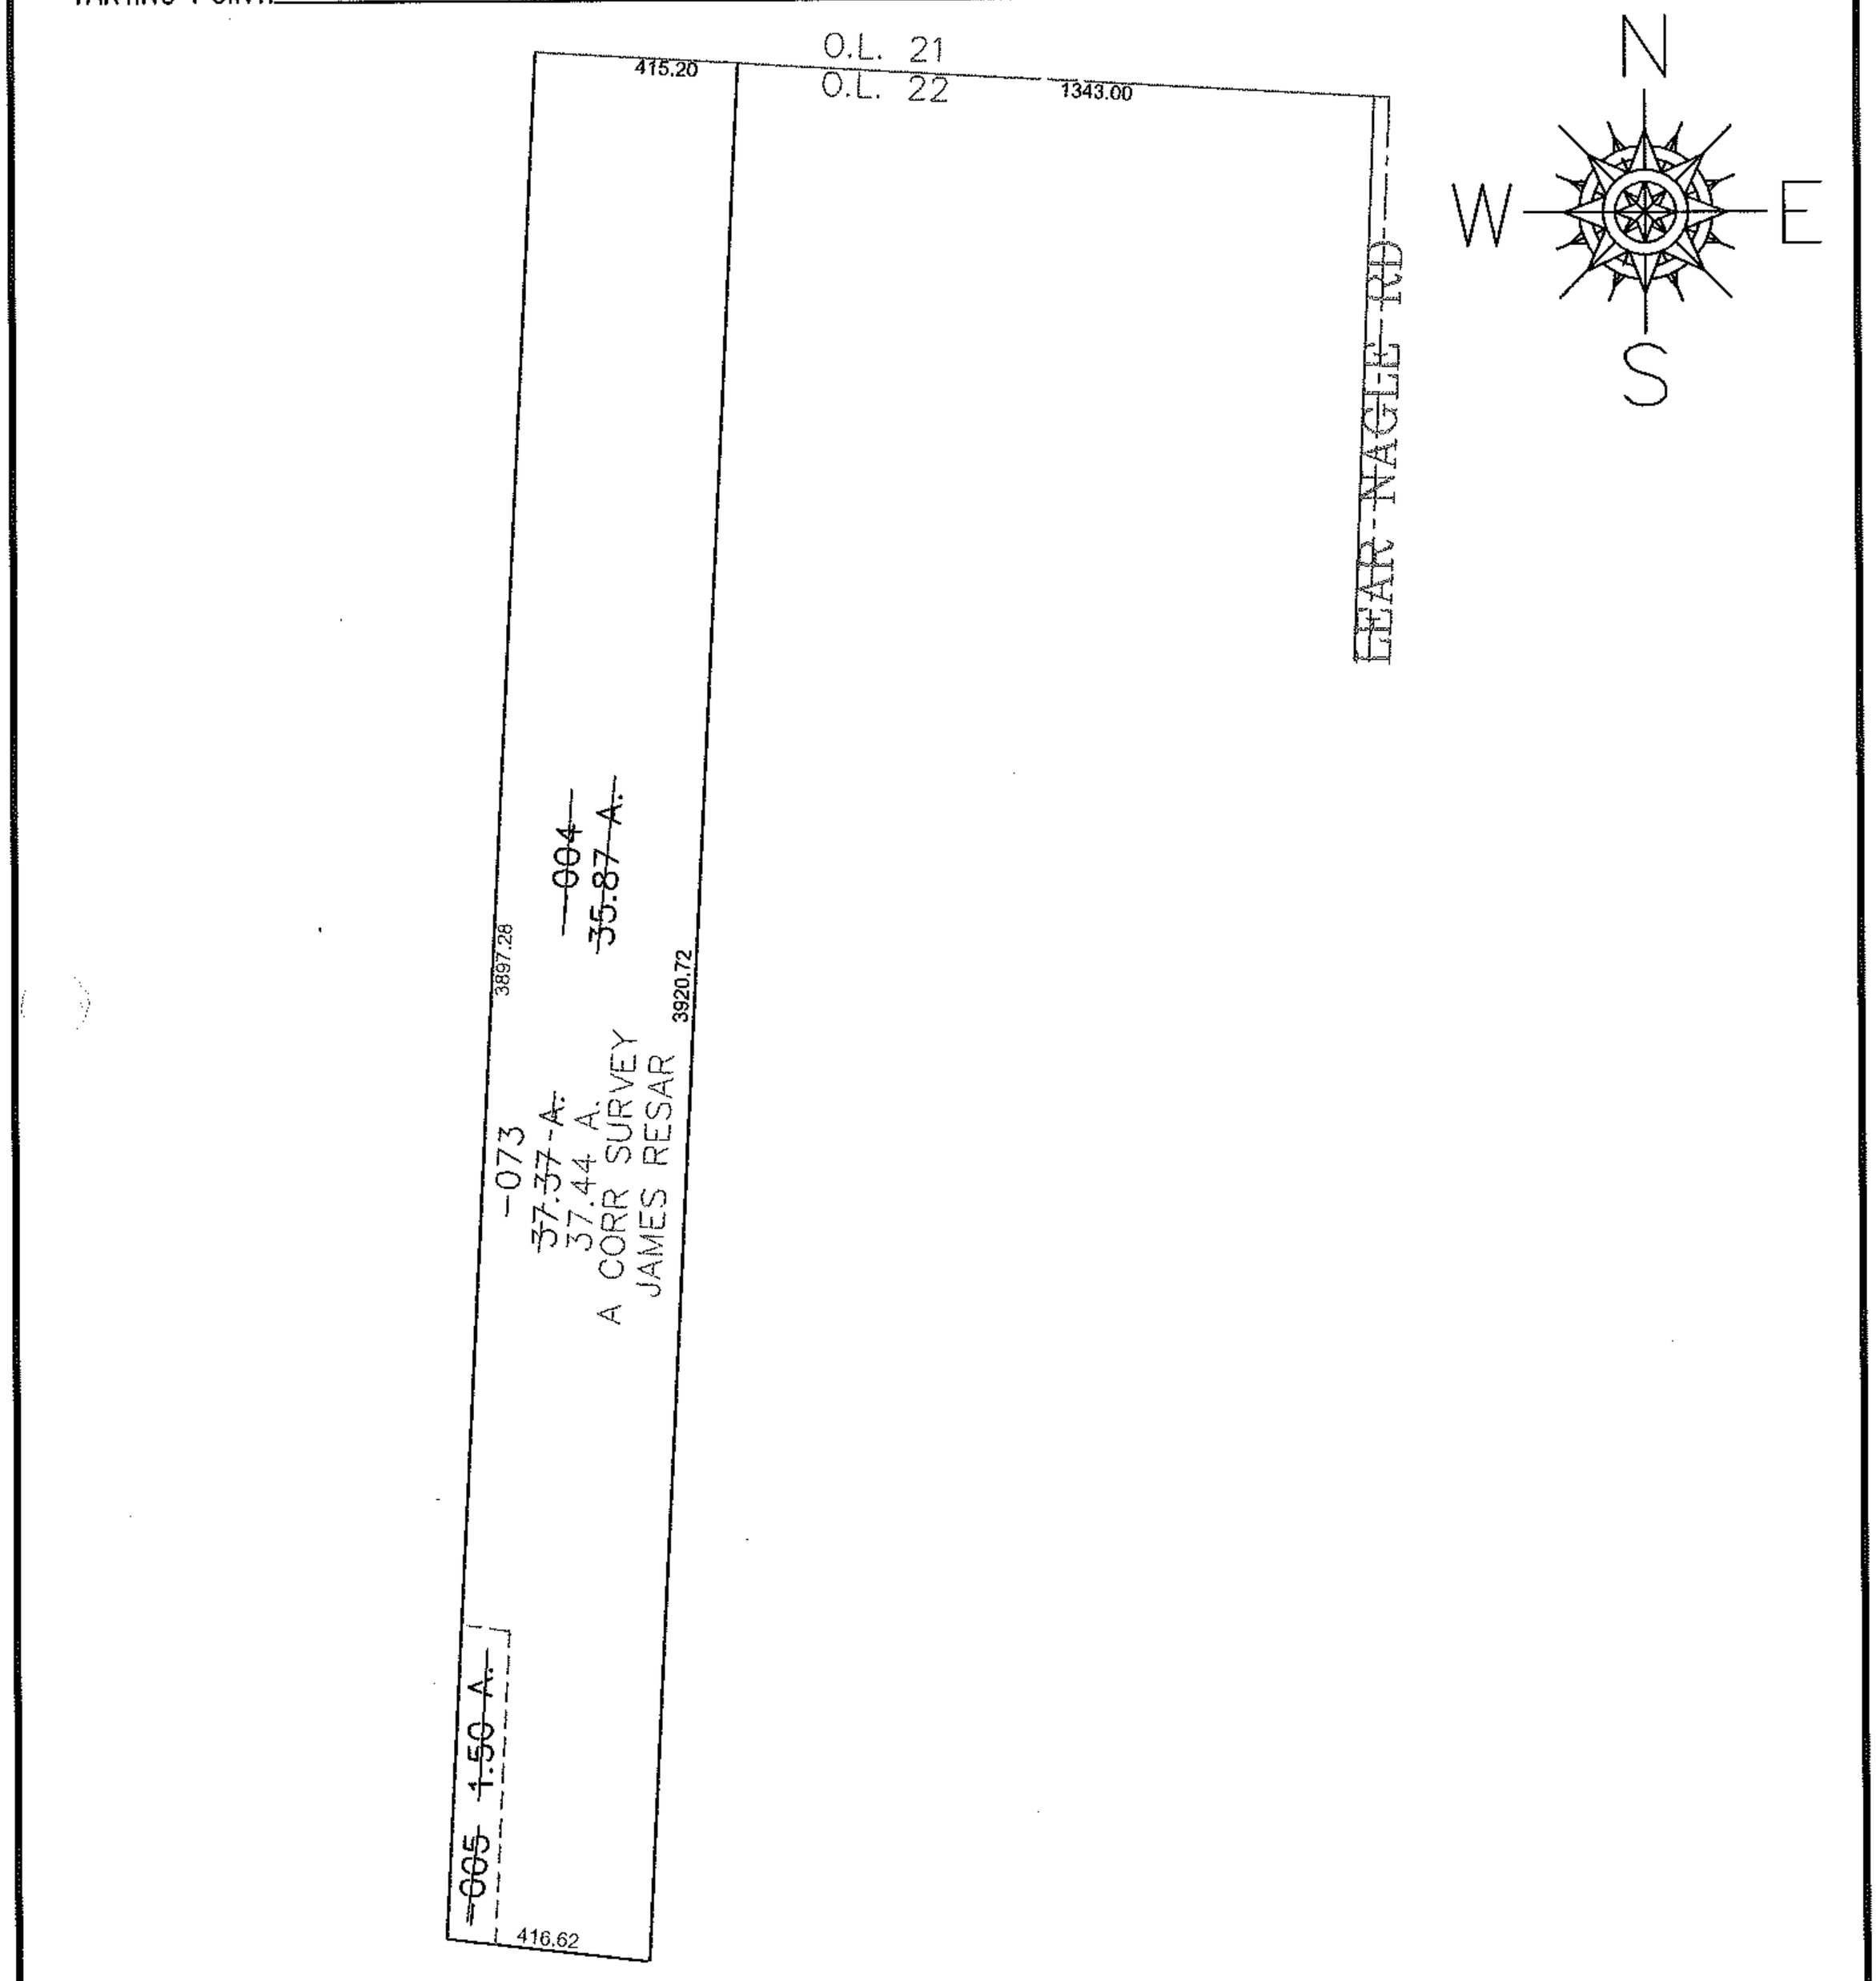

SPLITS/DEEDS PROCESSED

LORAIN COUNTY TAX MAP DEPARTMENT
226 MIDDLE AVE. ELYRIA, OHIO

SURVEYED BY: JAMES A RESAR

CLOSURE: 0.00 : 10,000

MAP PAGE(S): 04-00-022-C & G

APPROVED BY: JAH DATE: 3-26-2012

SCALE: 1"= 500 PRIOR INSTRUMENT: 20110387690