PARENT PARCEL: 05-00-075-000-013

CHILD PARCEL: 05-00-075-000-015, -016

STARTING POINT: CENTERLINE OF MILAN-ELYRIA RD & BECHTEL RD

14-03019-U

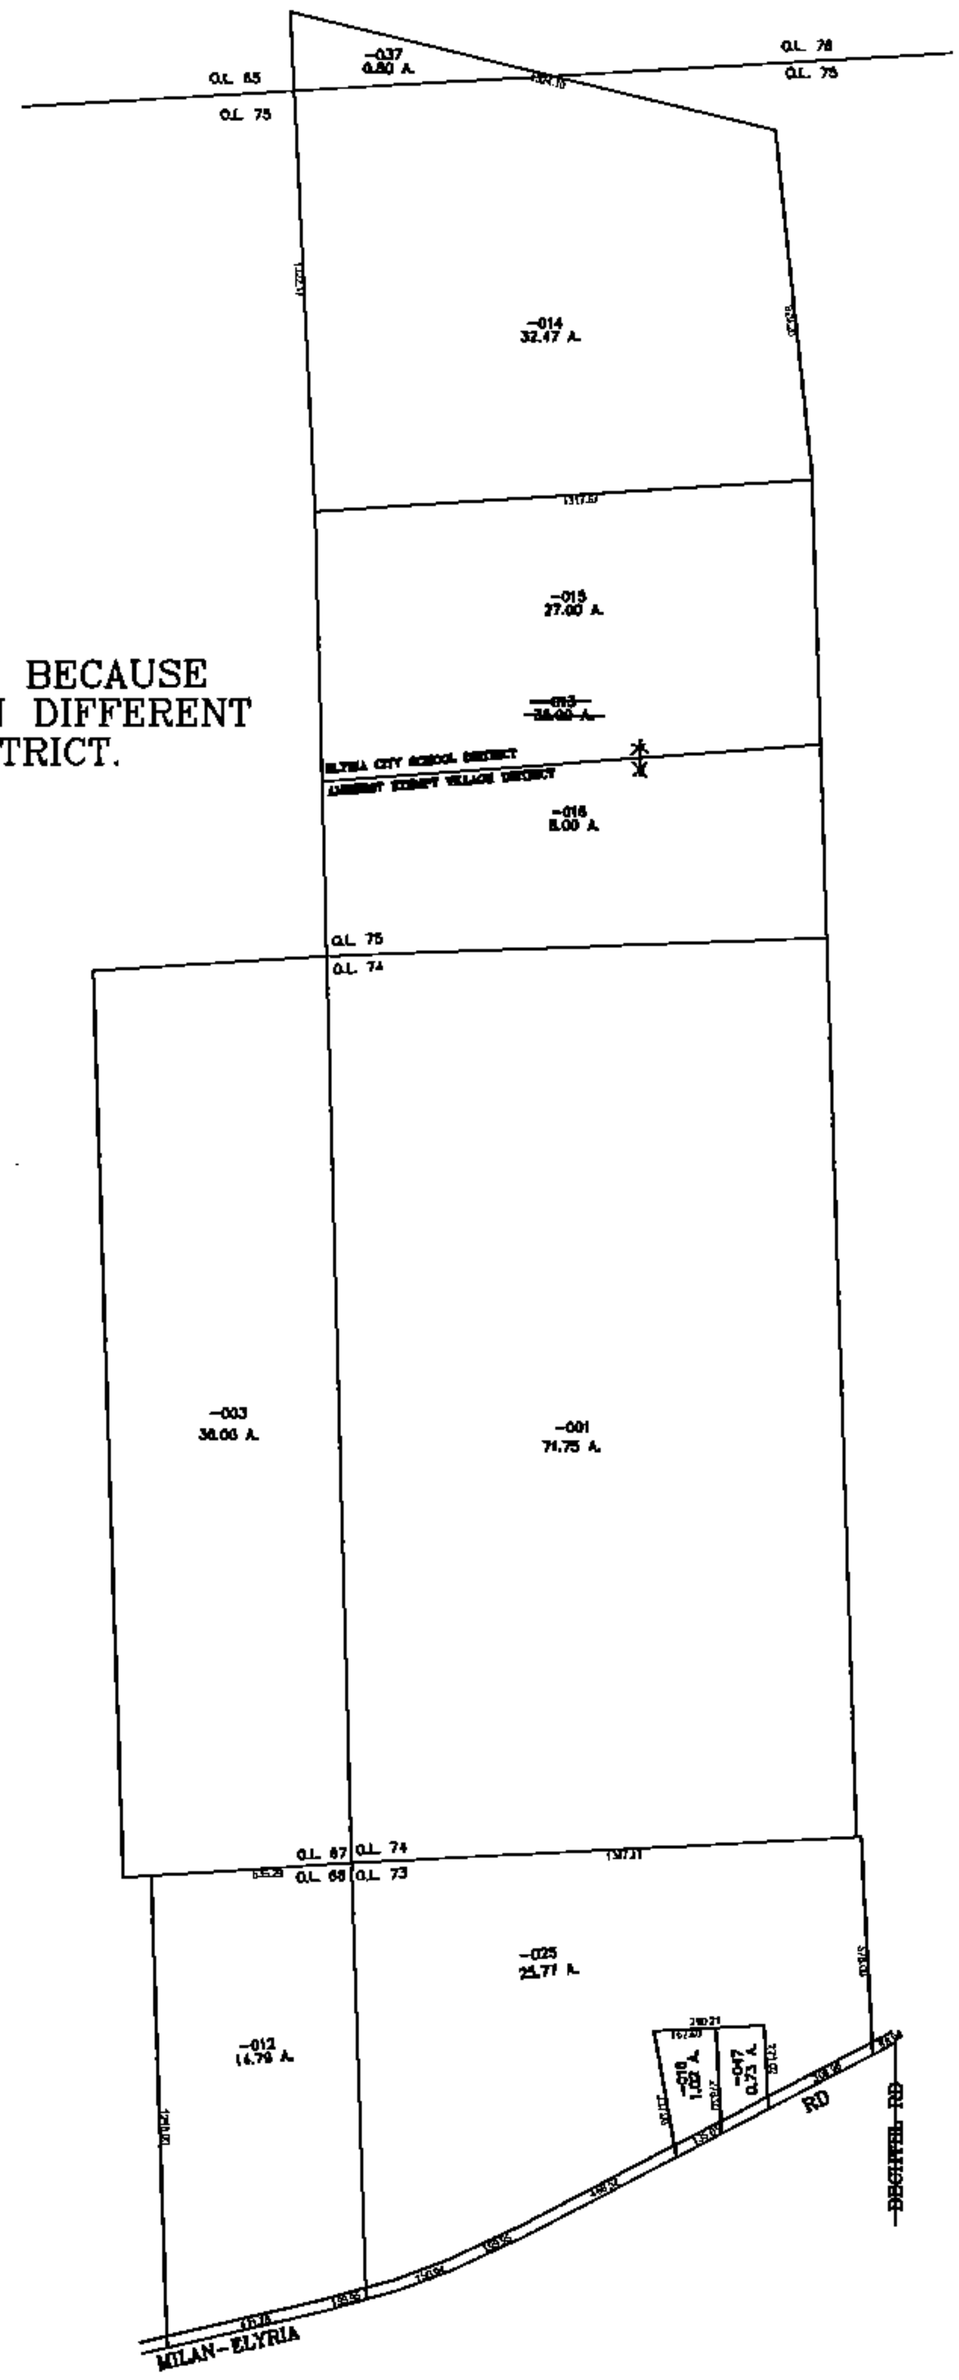

UNCOMBINATION BECAUSE EACH PIECE IS IN DIFFERENT SCHOOL DISTRICT.

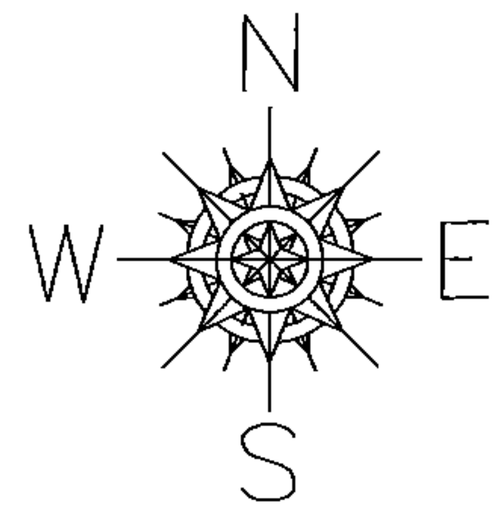

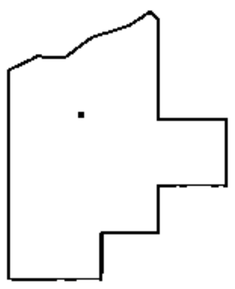

SPLITS/DEEDS PROCESSED

LORAIN COUNTY TAX MAP DEPARTMENT
226 MIDDLE AVE. ELYRIA, OHIO

SURVEYED BY: THOMAS SIMON

CLOSURE: 0.00 : 10,000

MAP PAGE(S): 5-H

APPROVED BY: JAH DATE: 9/12/2014

SCALE: 1"= 800 PRIOR INSTRUMENT: 20140515580