PARENT PARCEL: 10-00-003-120-005 & -006

CHILD PARCEL: 10-00-003-120-051

RTING POINT: CL OF WEST AVE. & CL OF OBERLIN - ELYRIA RD.

12-03023

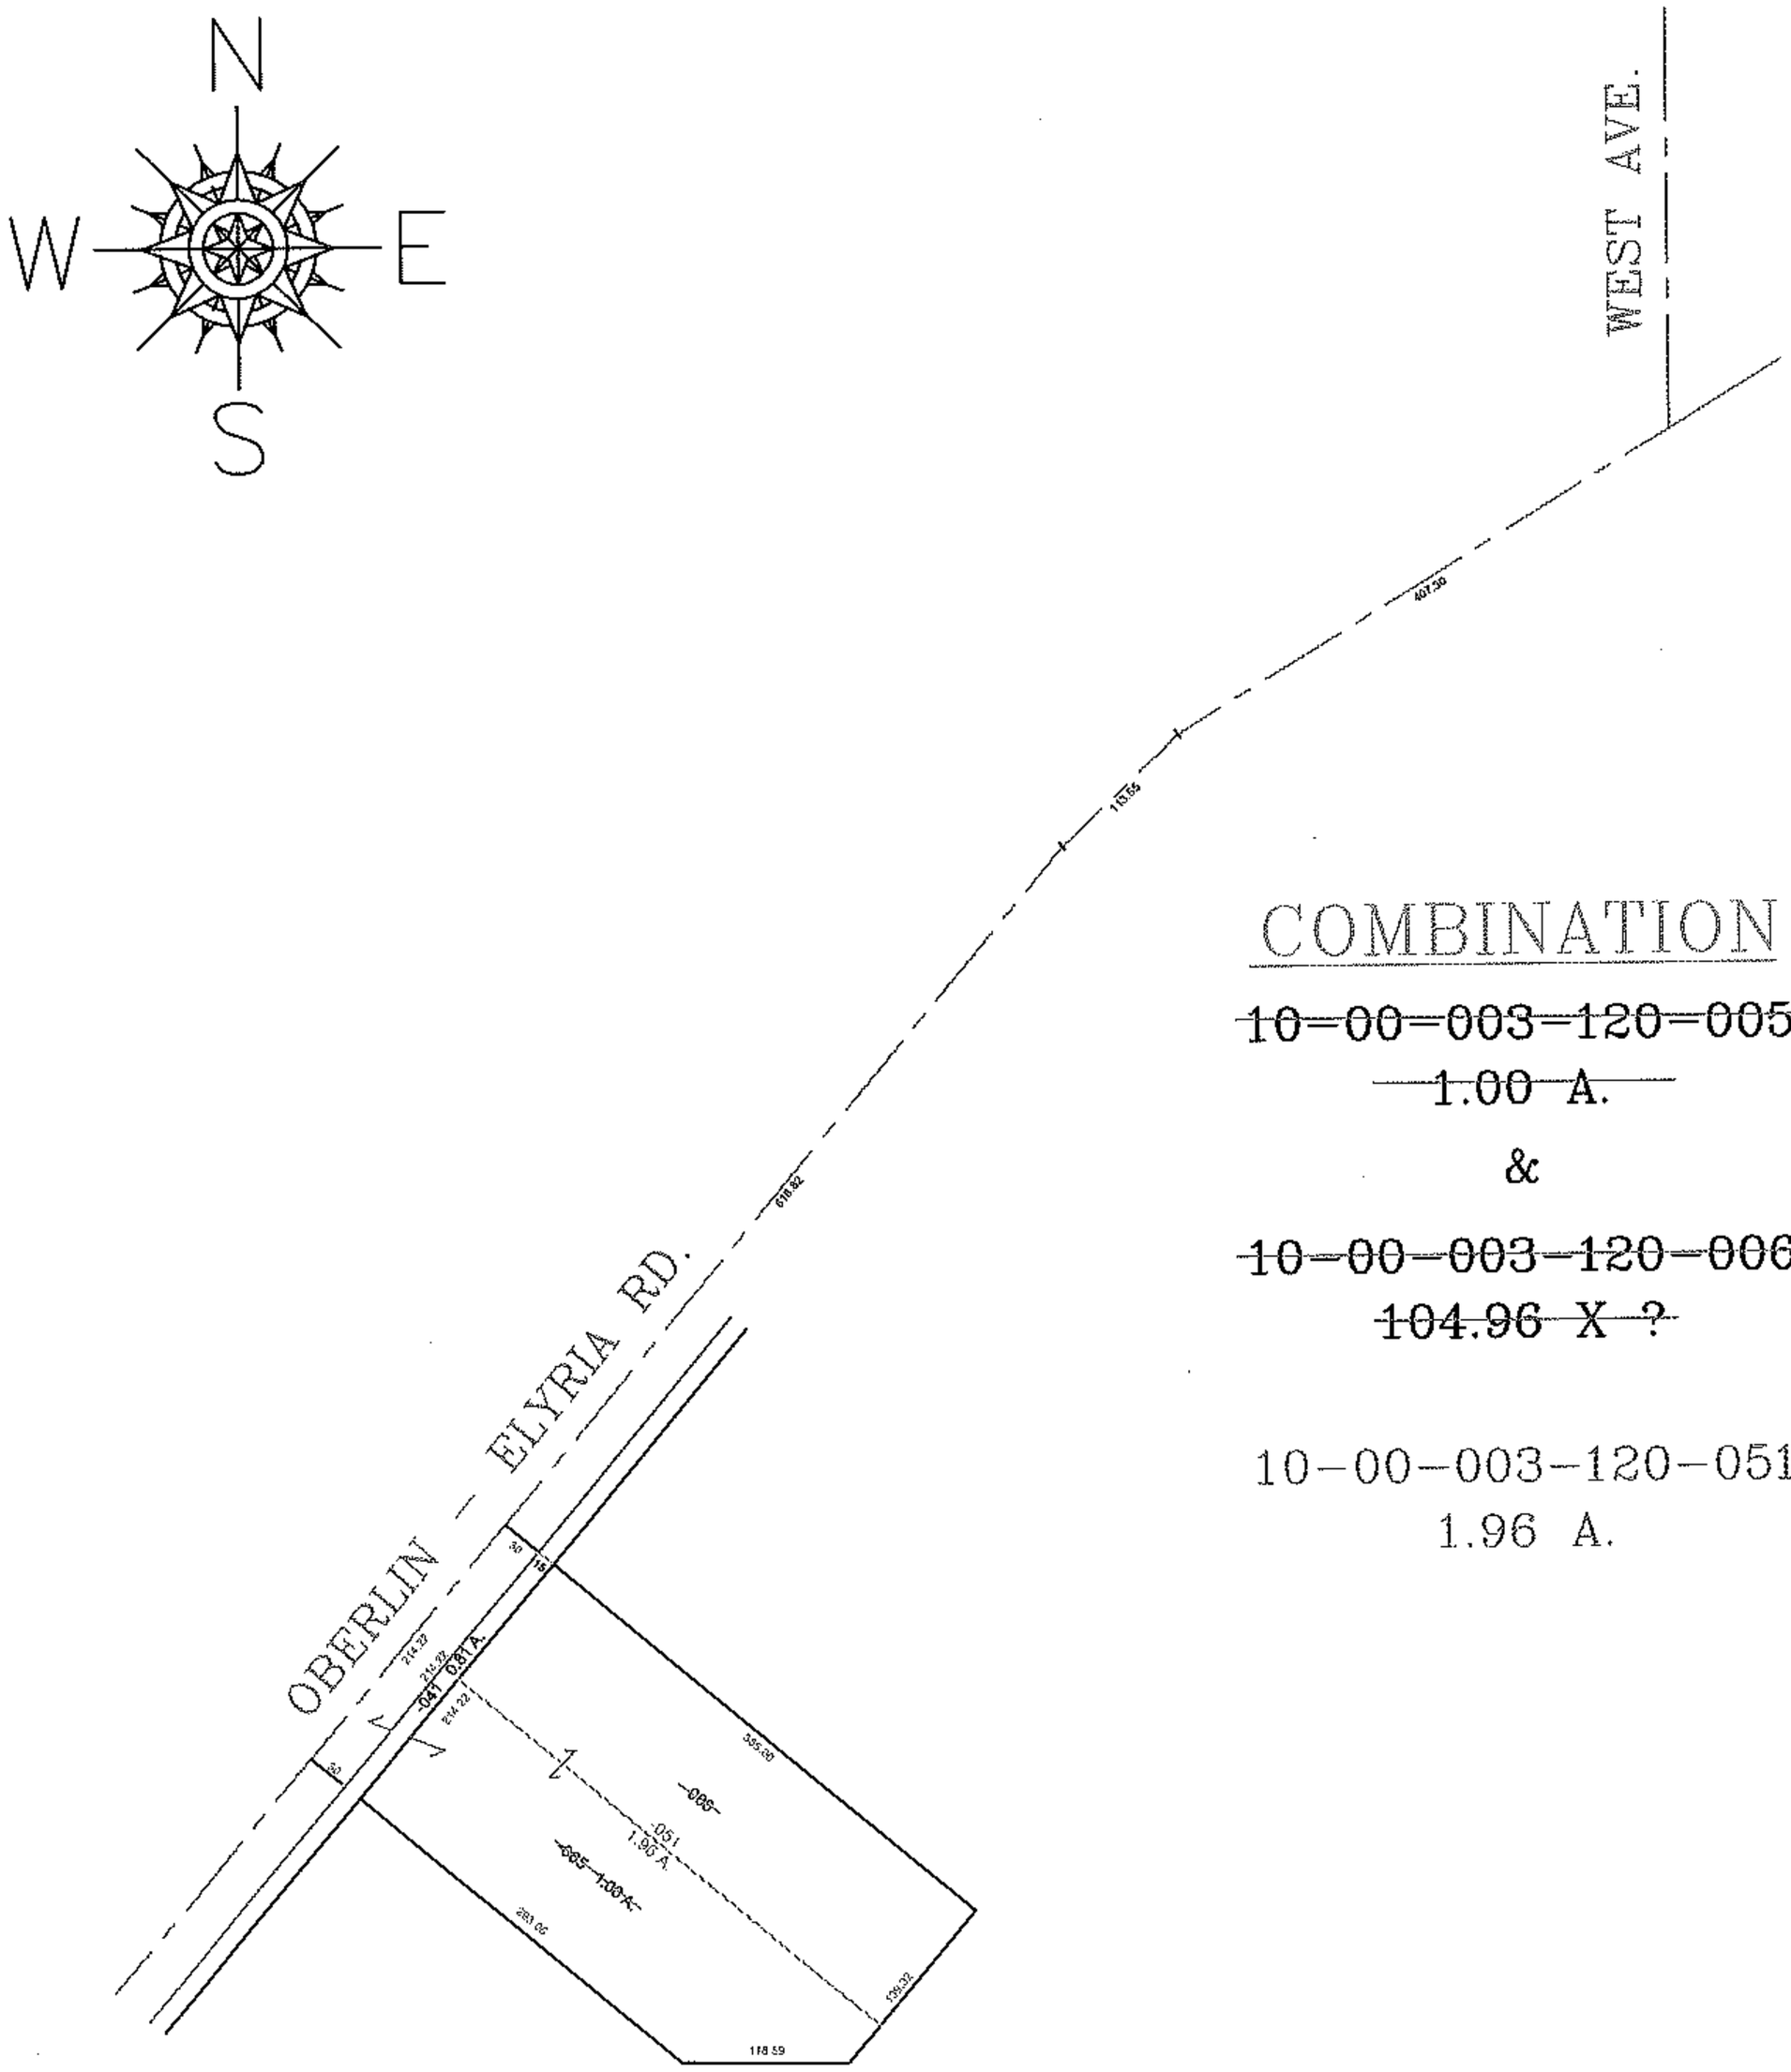

COMBINATION

~~10-00-003-120-005~~
~~1.00 A.~~

&

~~10-00-003-120-006~~
~~104.96 X ?~~

10-00-003-120-051
1.96 A.

SPLITS/DEEDS PROCESSED

LORAIN COUNTY TAX MAP DEPARTMENT
226 MIDDLE AVE. ELYRIA, OHIO

SURVEYED BY: NICK E. NIGH

CLOSURE: 0.01 : 10,000

MAP PAGE(S): 10-00-003-d

APPROVED BY: TJS DATE: 5/4/12

SCALE: 1"= 200 PRIOR INST.: 20120398740