PARENT PARCEL: 07-00-028-102-016, -021

CHILD PARCEL: 07-00-028-102-115 THRU -117

STARTING POINT: CENTERLINE OF AVON BELDEN RD & O.L. 28

12-03029

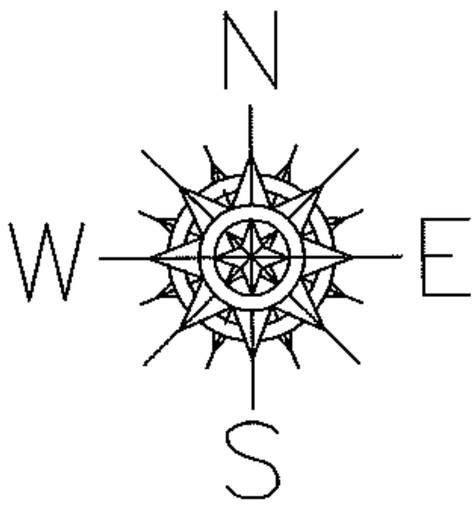

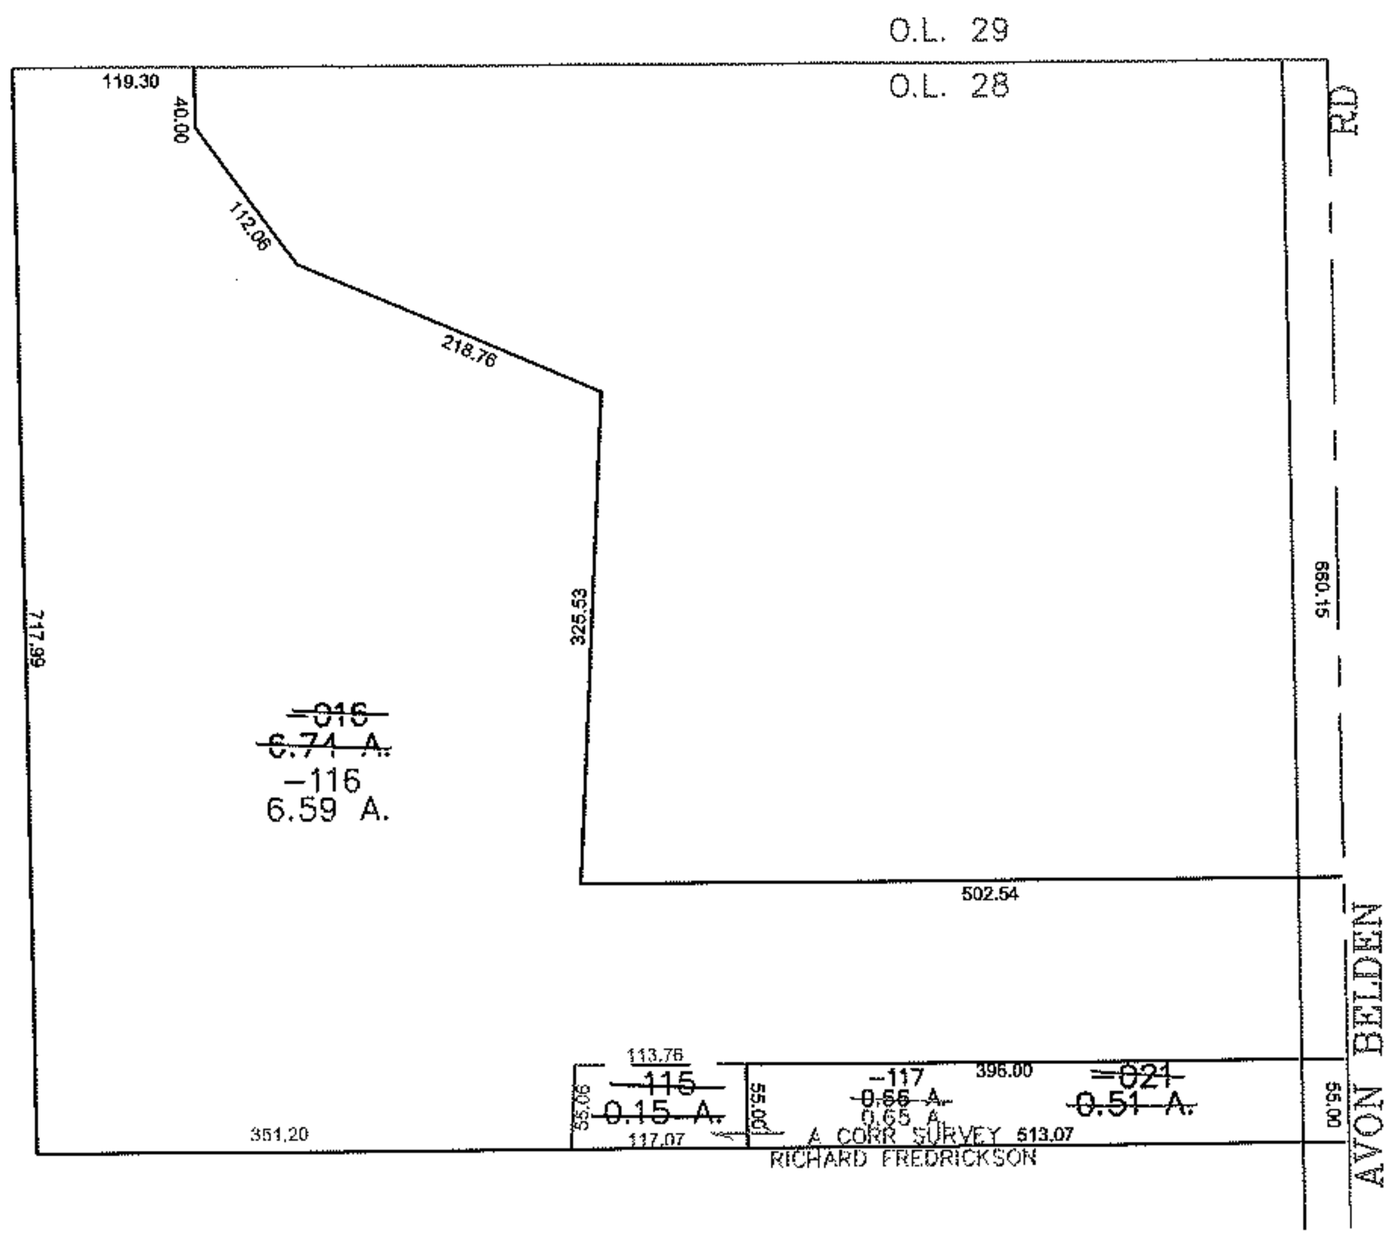

SPLITS/DEEDS PROCESSED

LORAIN COUNTY TAX MAP DEPARTMENT
226 MIDDLE AVE. ELYRIA, OHIO

SURVEYED BY: RICHARD FREDRICKSON

CLOSURE: 0.00 : 10,000

MAP PAGE(S): 07-00-028-A

APPROVED BY: JAH DATE: 5-22-2012

SCALE: 1"= 200 PRIOR INSTRUMENT: 19990592946