RASTER

PARENT PARCEL: 03-00-047-101-012, -013, -014, -015, -016

CHILD PARCEL: 03-00-047-101-027 THRU -029

STARTING POINT: MON BOX, CL OF ROOT RD. & CL OF EAST ERIE AVE.

12-03030

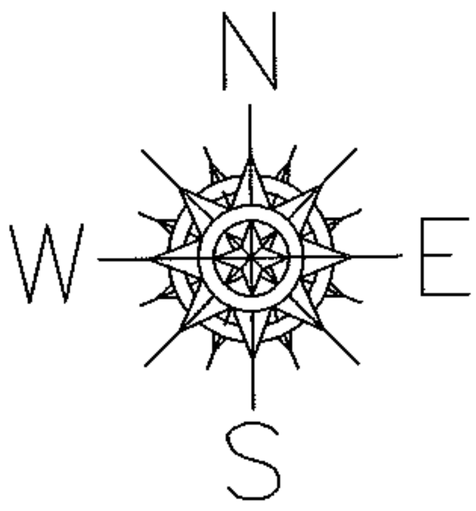

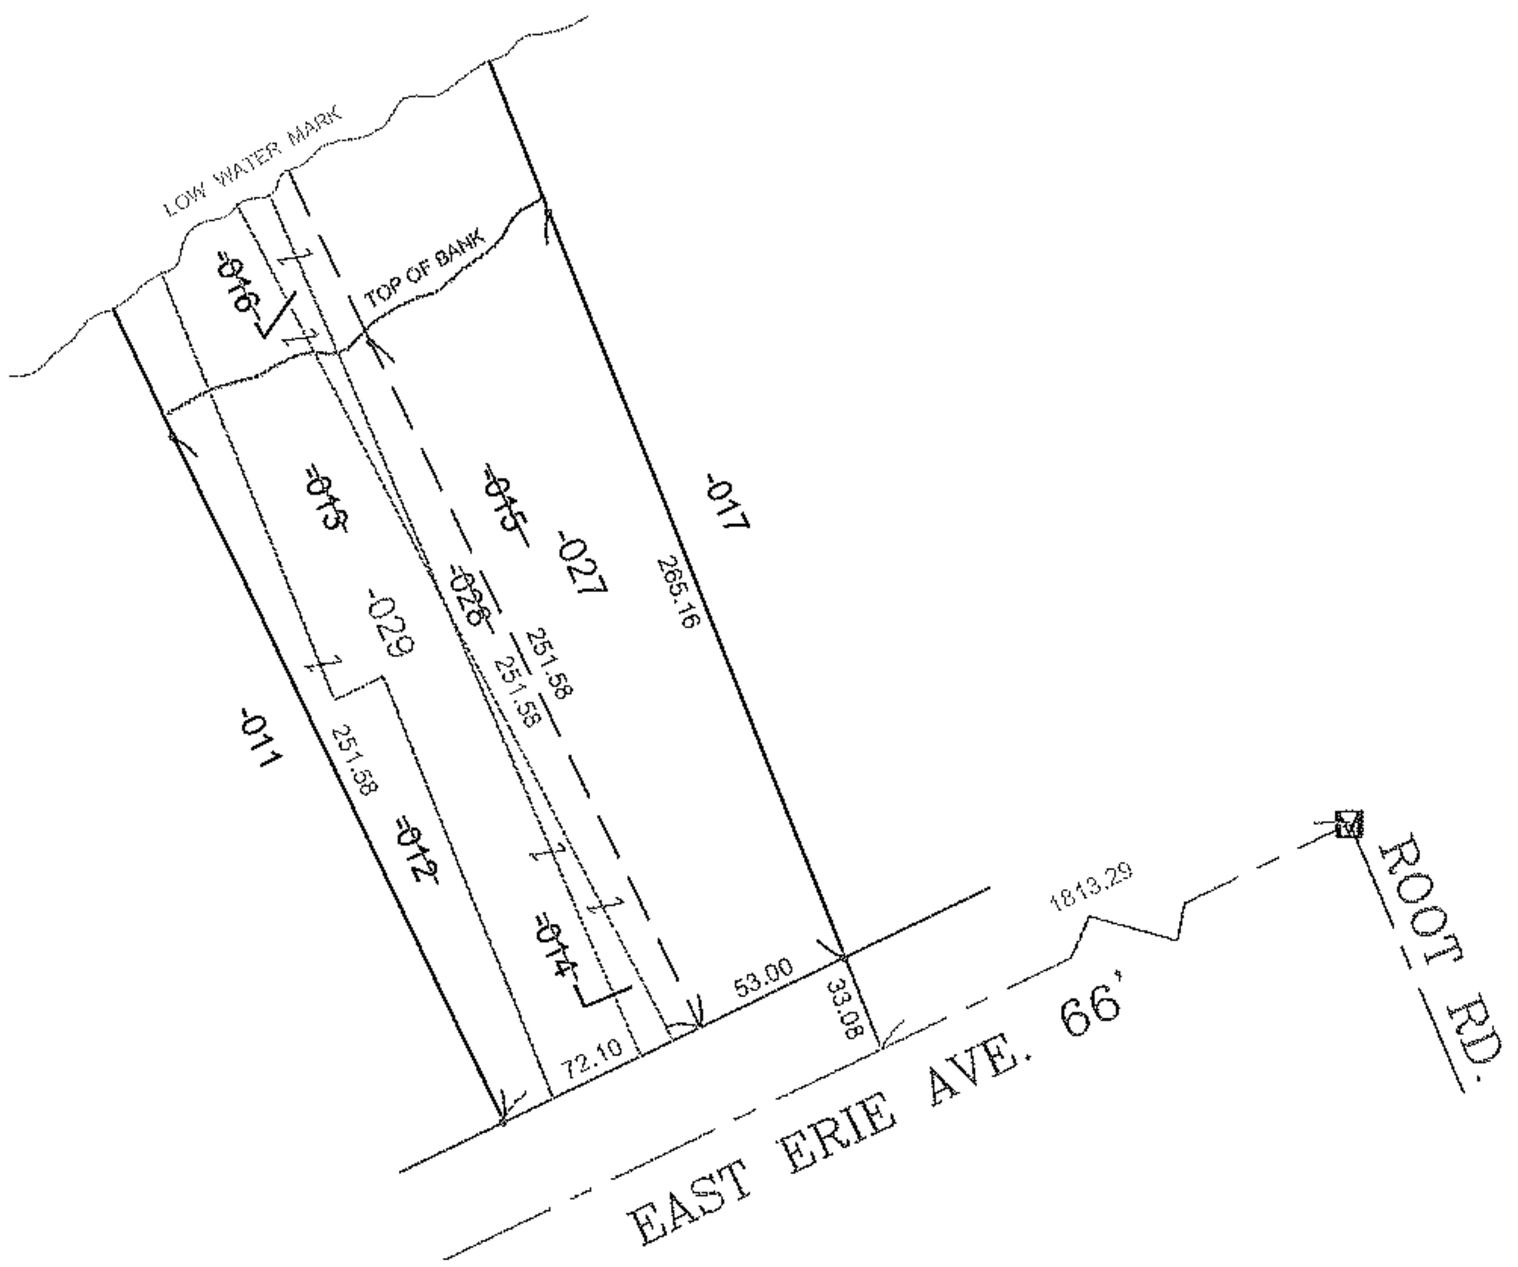

SPLITS/DEEDS PROCESSED

LORAIN COUNTY TAX MAP DEPARTMENT
226 MIDDLE AVE. ELYRIA, OHIO

SURVEYED BY: WILFREDO BARBOSA

CLOSURE: NA - LOW WATER MARK

MAP PAGE(S): 03-00-047-A

APPROVED BY: TJS DATE: 5/24/12

SCALE: 1"= 100 PRIOR INSTRUMENT: 20110367144