MASTER

PARENT PARCEL: 02-02-001-103-004, 02-02-001-104-079, -082, -081

CHILD PARCEL: 02-02-001-103-005 THRU -010

RTING POINT: EASTERLY LINE OF O.L. 1 TRACT 2 & WESTERLY LINE OF MEADOWVIEW

12-03041

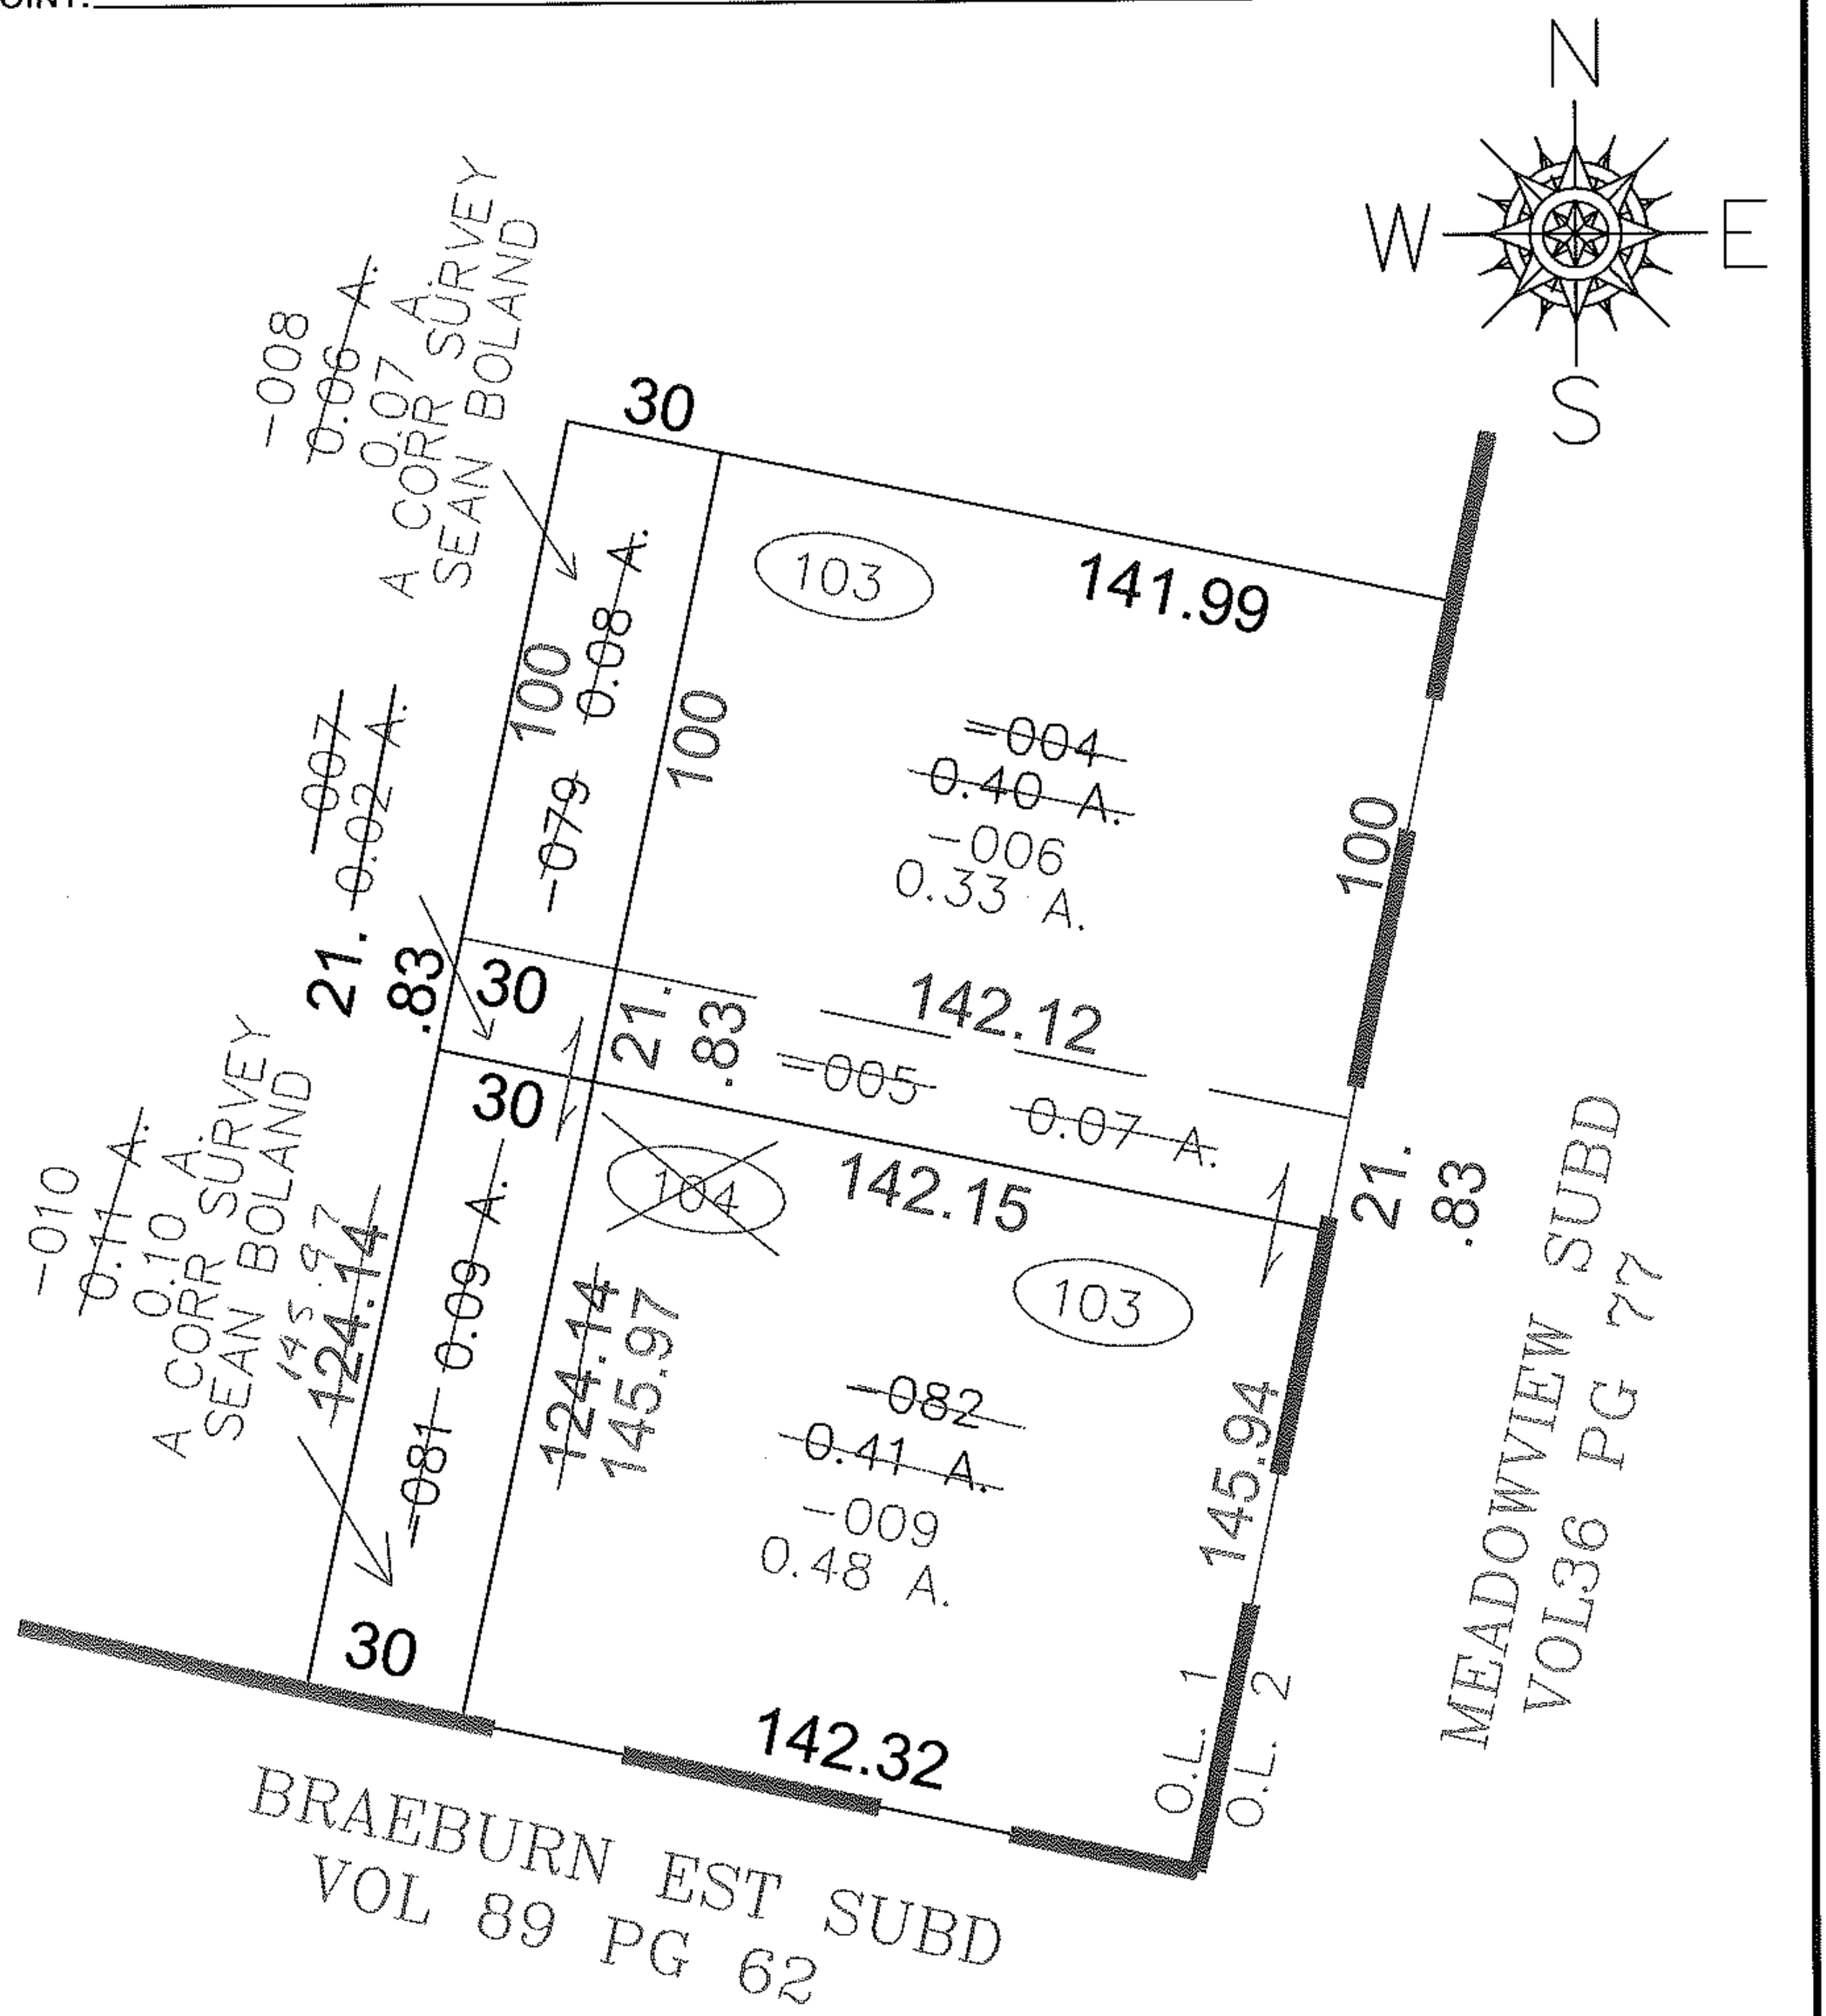

SPLITS/DEEDS PROCESSED

LORAIN COUNTY TAX MAP DEPARTMENT
226 MIDDLE AVE. ELYRIA, OHIO

SURVEYED BY: SEAN BOLAND
CLOSURE: 0.00 : 10,000
MAP PAGE(S): 02-02-001-B
APPROVED BY: JAH DATE: 6-22-2012
SCALE: 1"= 50' PRIOR INST.: 20050066627