PARENT PARCEL: 16-00-091-000-001

CHILD PARCEL: 16-00-091-000-064

STARTING POINT: N.W. CORNER OF O.L. 91

14-03057-D

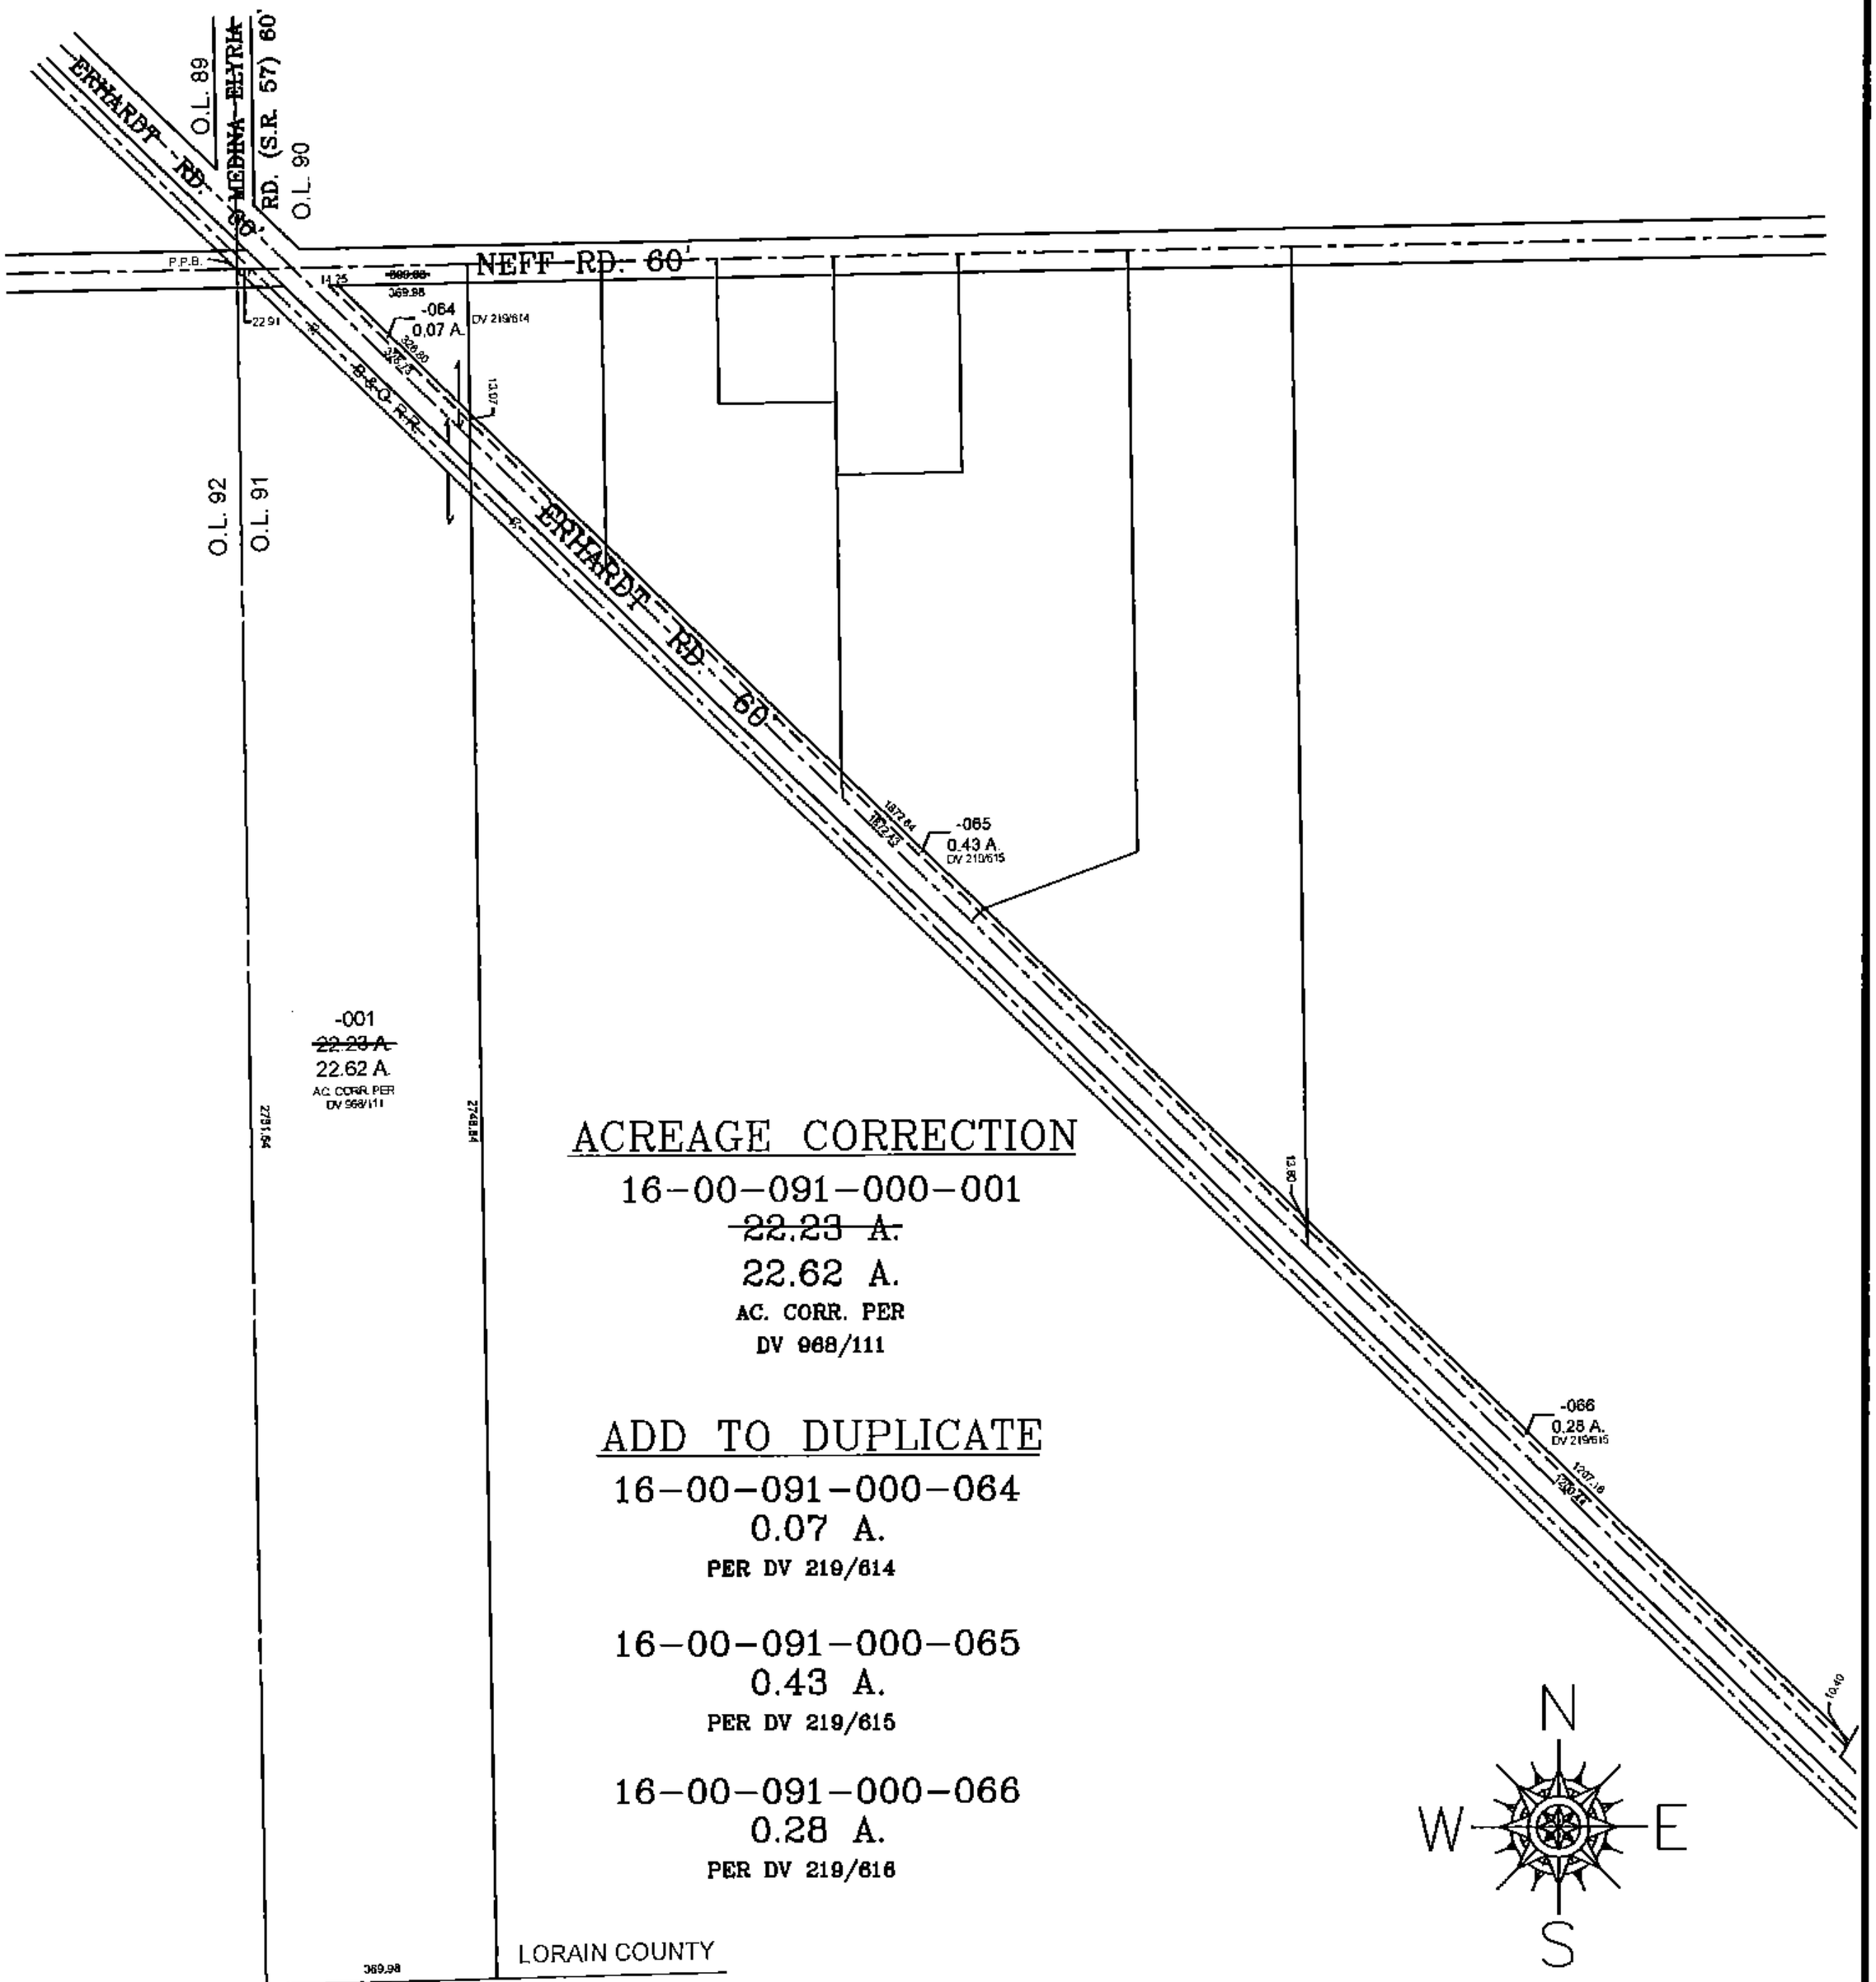

ACREAGE CORRECTION

16-00-091-000-001

~~22.23 A.~~

22.62 A.

AC. CORR. PER

DV 968/111

ADD TO DUPLICATE

16-00-091-000-064

0.07 A.

PER DV 219/614

16-00-091-000-065

0.43 A.

PER DV 219/615

16-00-091-000-066

0.28 A.

PER DV 219/616

SPLITS/DEEDS PROCESSED

LORAIN COUNTY TAX MAP DEPARTMENT

226 MIDDLE AVE. ELYRIA, OHIO

SURVEYED BY: NA

CLOSURE: 0.01 : 10,000

MAP PAGE(S): 16-00-091

APPROVED BY: TJS DATE: 11/13/14

SCALE: 1"= 400 PRIOR INSTRUMENT: