PARENT PARCEL: 01-00-022-104-011, -043, -044

CHILD PARCEL: 01-00-022-104-047

STARTING POINT: CENTERLINE OF CLAUS RD REFERENCING O.L. 21

12-03063

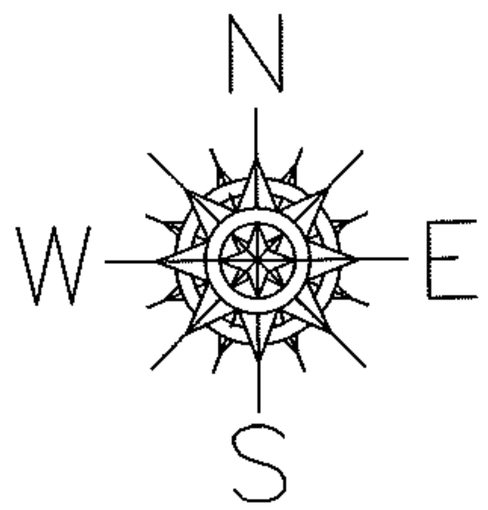

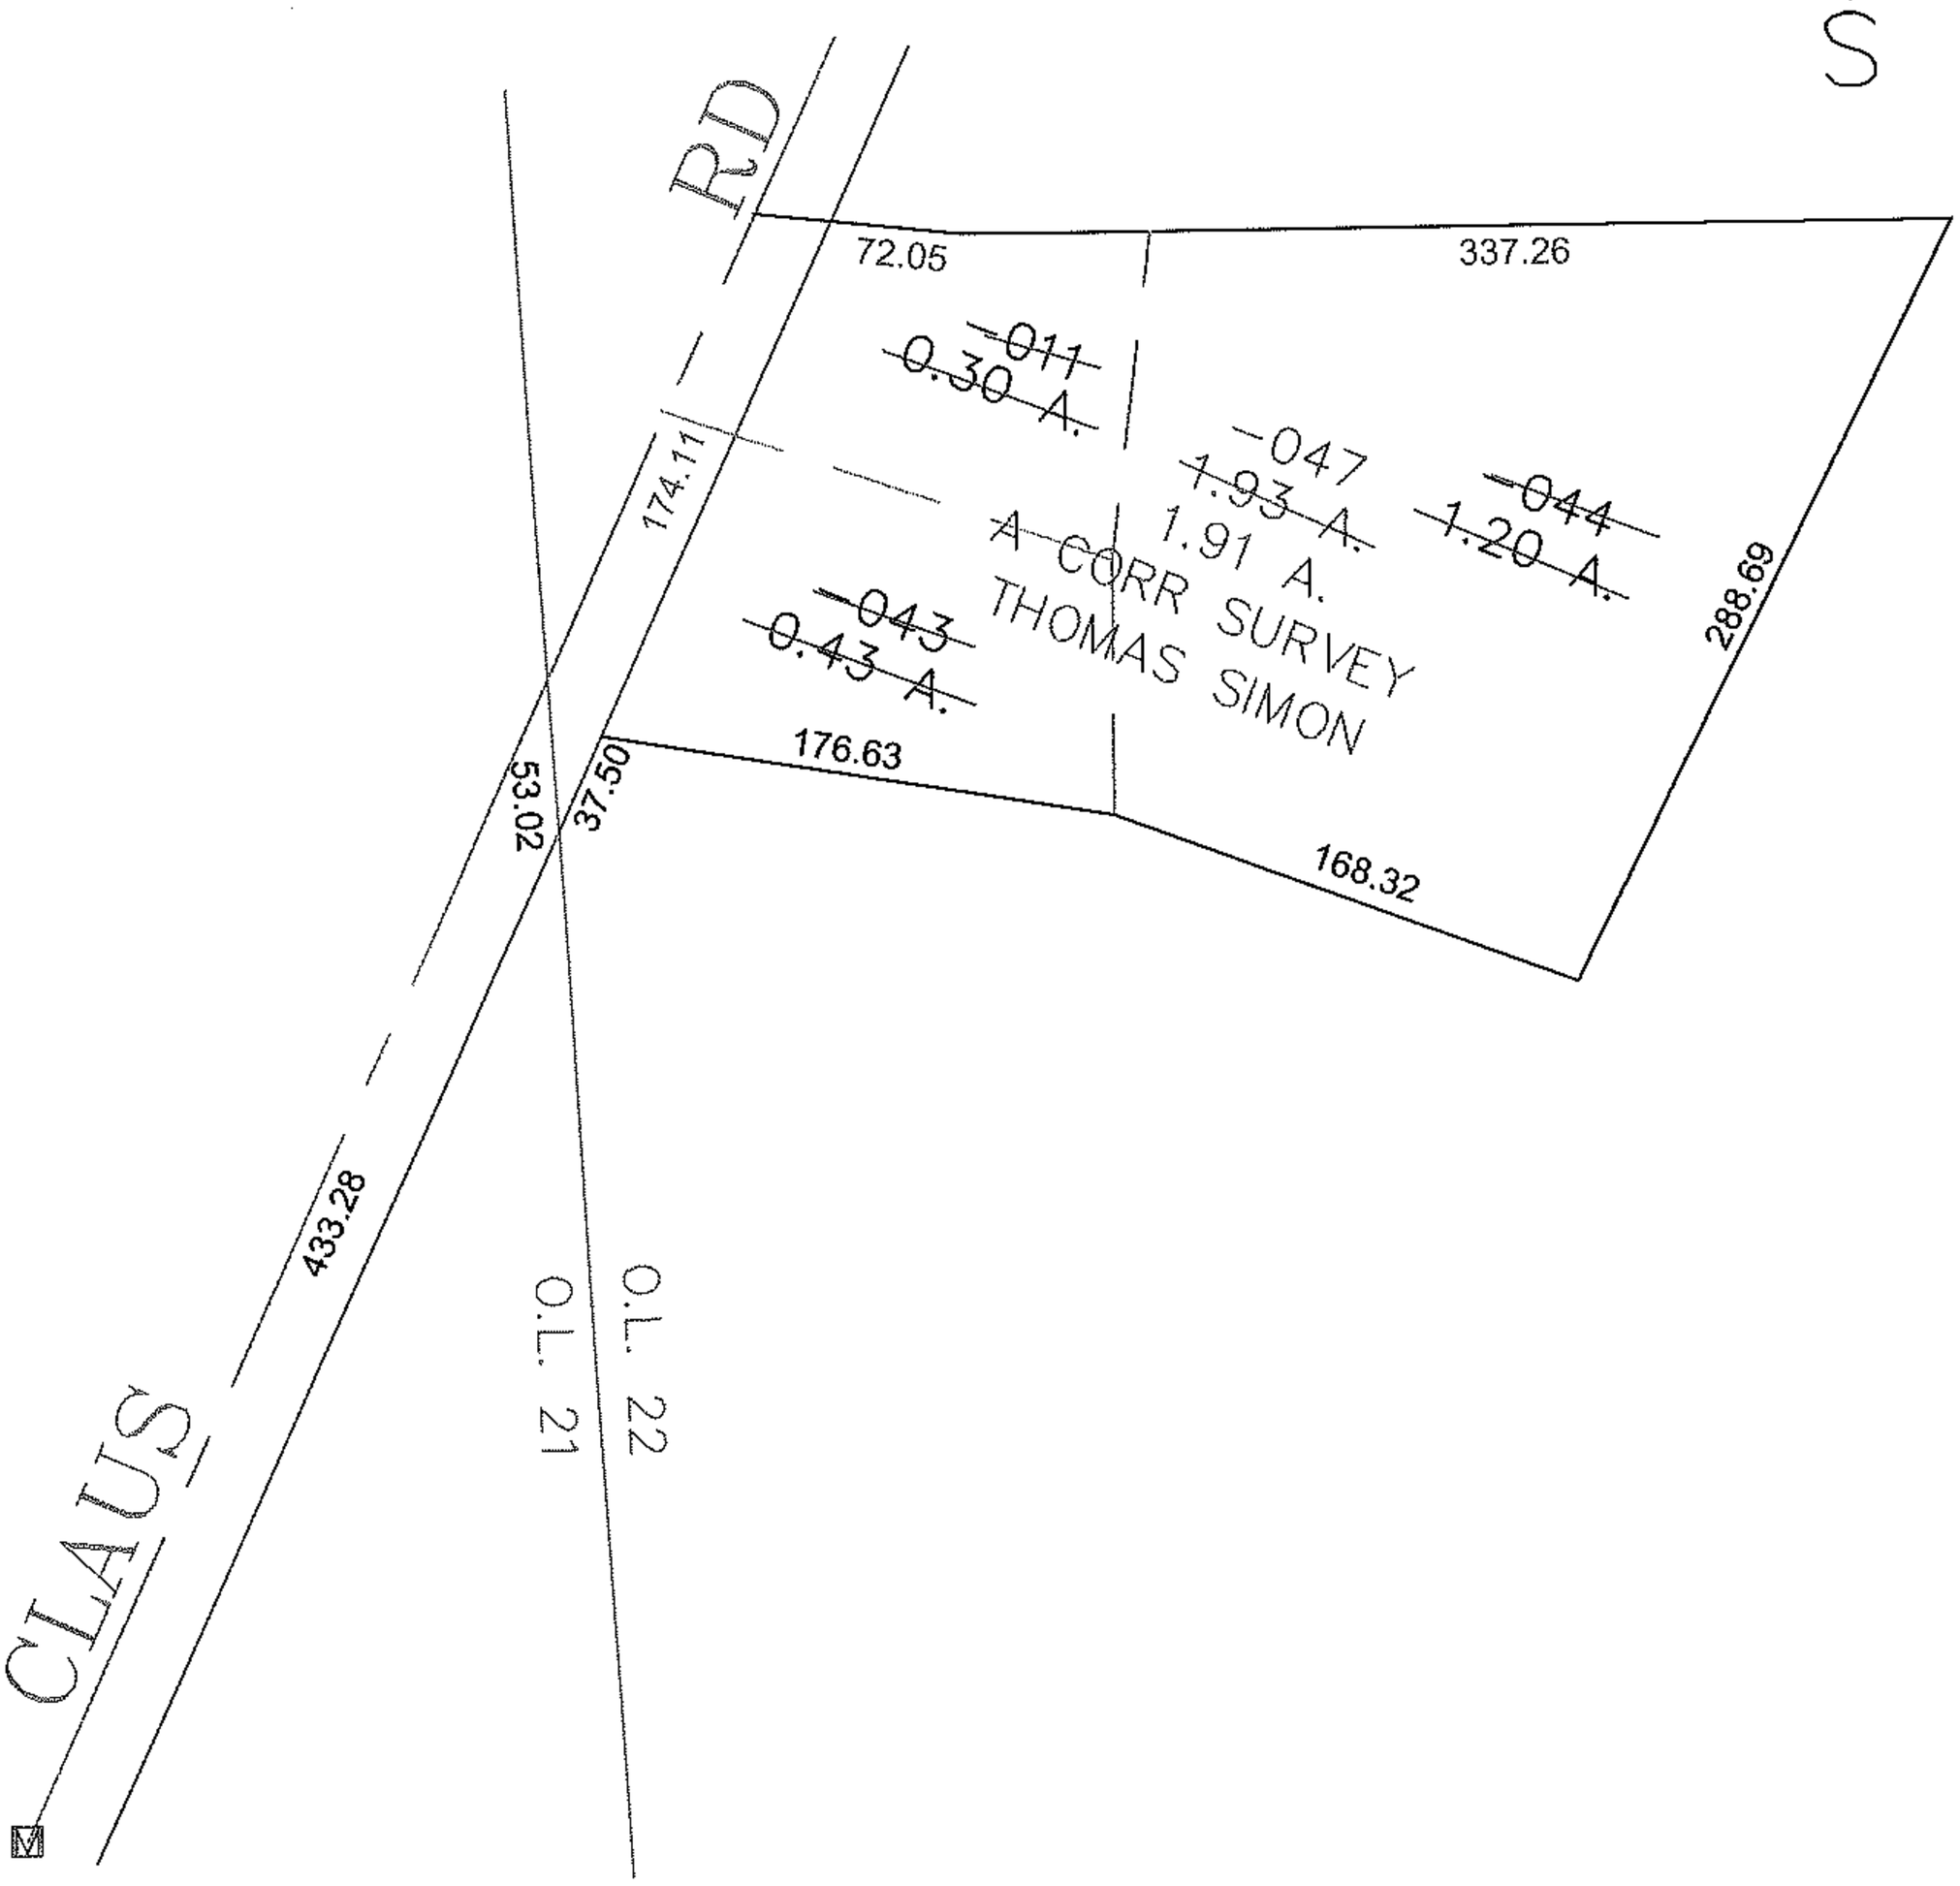

SPLITS/DEEDS PROCESSED

LORAIN COUNTY TAX MAP DEPARTMENT
226 MIDDLE AVE. ELYRIA, OHIO

SURVEYED BY: THOMAS SIMON

CLOSURE: 0.00 : 10,000

MAP PAGE(S): 01-00-022-A

APPROVED BY: JAH DATE: 8-29-2012

SCALE: 1"= 100 PRIOR INSTRUMENT: 20090283781