PARENT PARCEL: 06-25-124-000-005 THRU -010 & 06-25-054-000-001, -002, -004, & -009

CHILD PARCEL: 06-25-000-000-001 THRU -009

STARTING POINT: XXXXXX

15-03087-X

N
W E
S

PARCEL RE-NUMBER

OLD P.P.N.	NEW P.P.N.
06-25-124-000-005 10 X 315	06-25-000-000-001 10.00 X 315.00
06-25-124-000-006 264.56 X ?	06-25-000-000-002 264.56 X ?
06-25-124-000-007 550.01 X ?	06-25-000-000-003 550.01 X ?
06-25-124-000-008 50.00 X ?	06-25-000-000-004 50.00 X ?
06-25-124-000-009 62.00 X ?	06-25-000-000-005 62.00 X ?
06-25-124-000-010 40.00 X ?	06-25-000-000-006 40.00 X ?
06-25-054-000-001 40 X 135	06-25-000-000-007 40.00 X 135.00
06-25-054-000-002 40 X ?	06-25-000-000-008 40.00 X ?
06-25-054-000-009 40 X 110	06-25-000-000-009 40.00 X 110.00
06-25-054-000-004 55 X 80	06-25-000-000-010 55.00 X 80.00

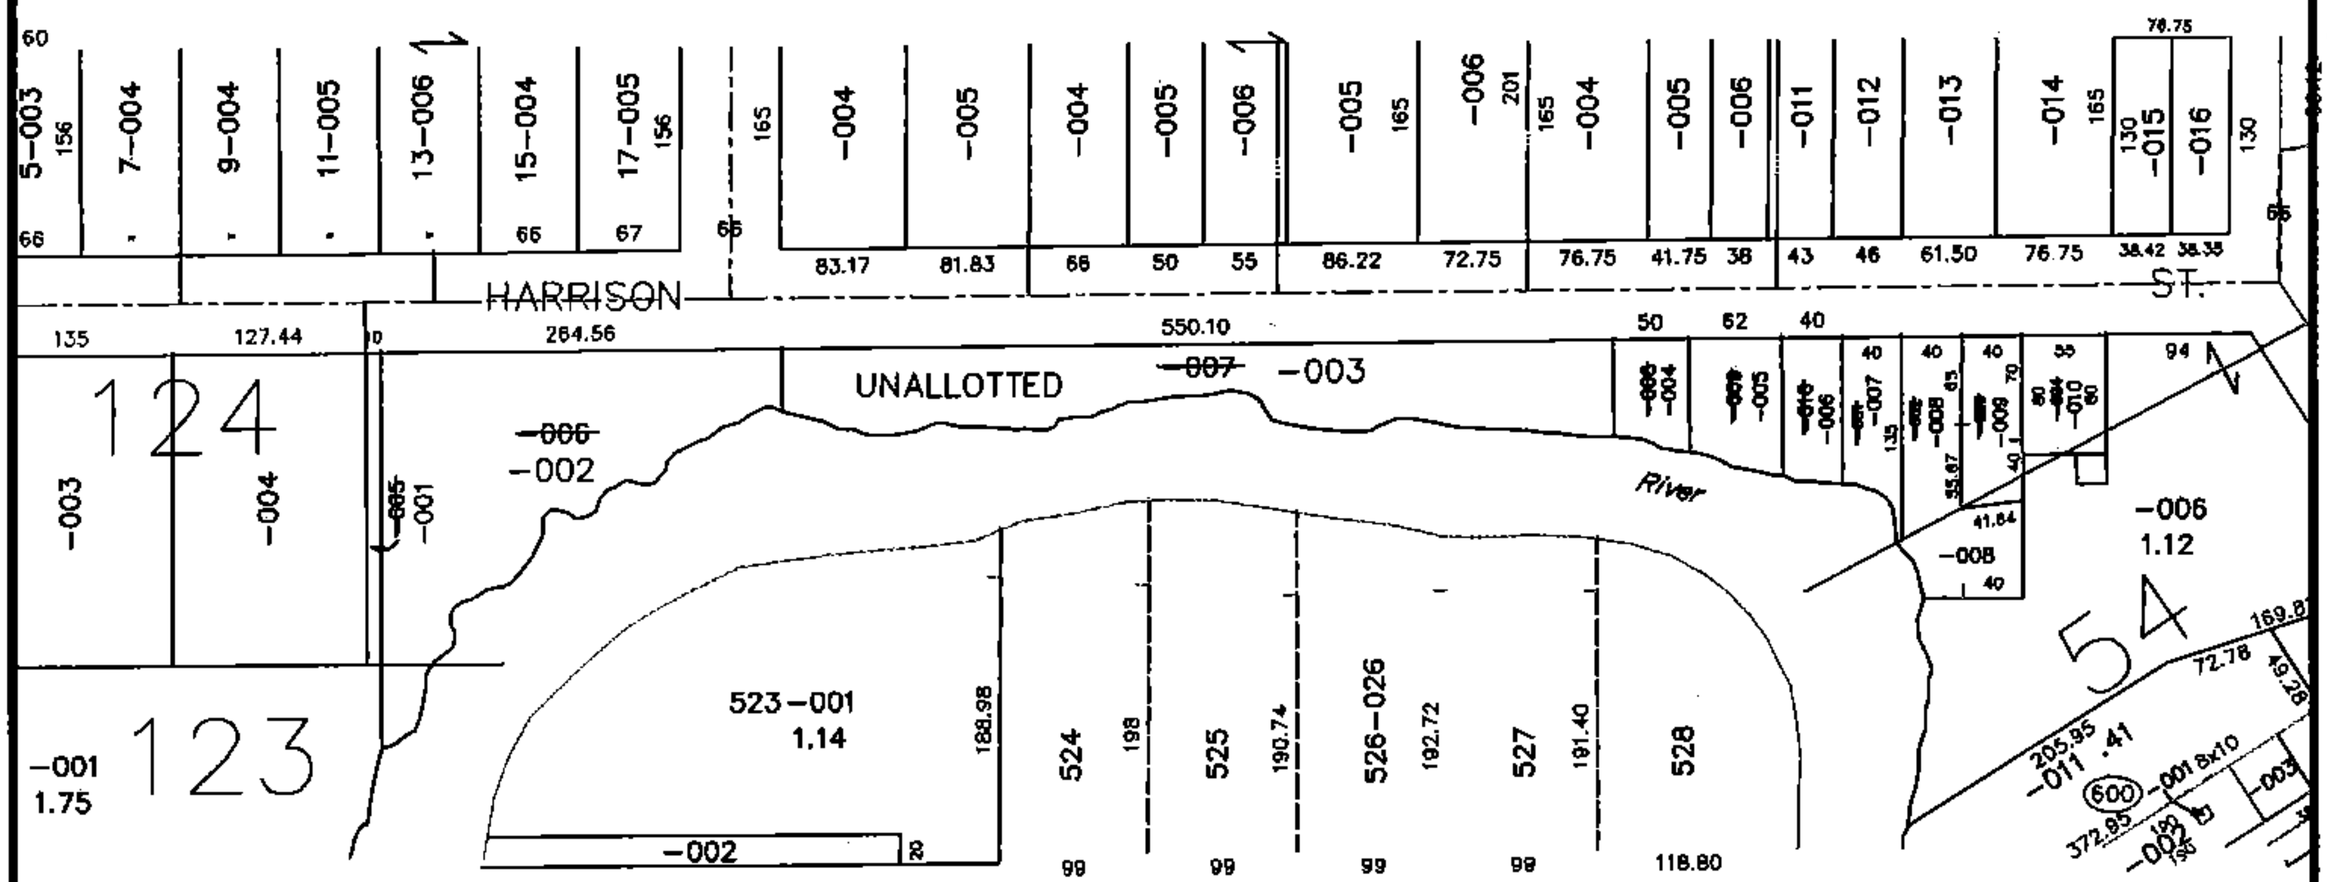

SPLITS/DEEDS PROCESSED

LORAIN COUNTY TAX MAP DEPARTMENT
226 MIDDLE AVE. ELYRIA, OHIO

SURVEYED BY: NA

CLOSURE: NA

MAP PAGE(S): 6-102 & 6-103

APPROVED BY: TJS DATE: 1/14/15

SCALE: 1"= 200 PRIOR INSTRUMENT: DV XXXX/XXX