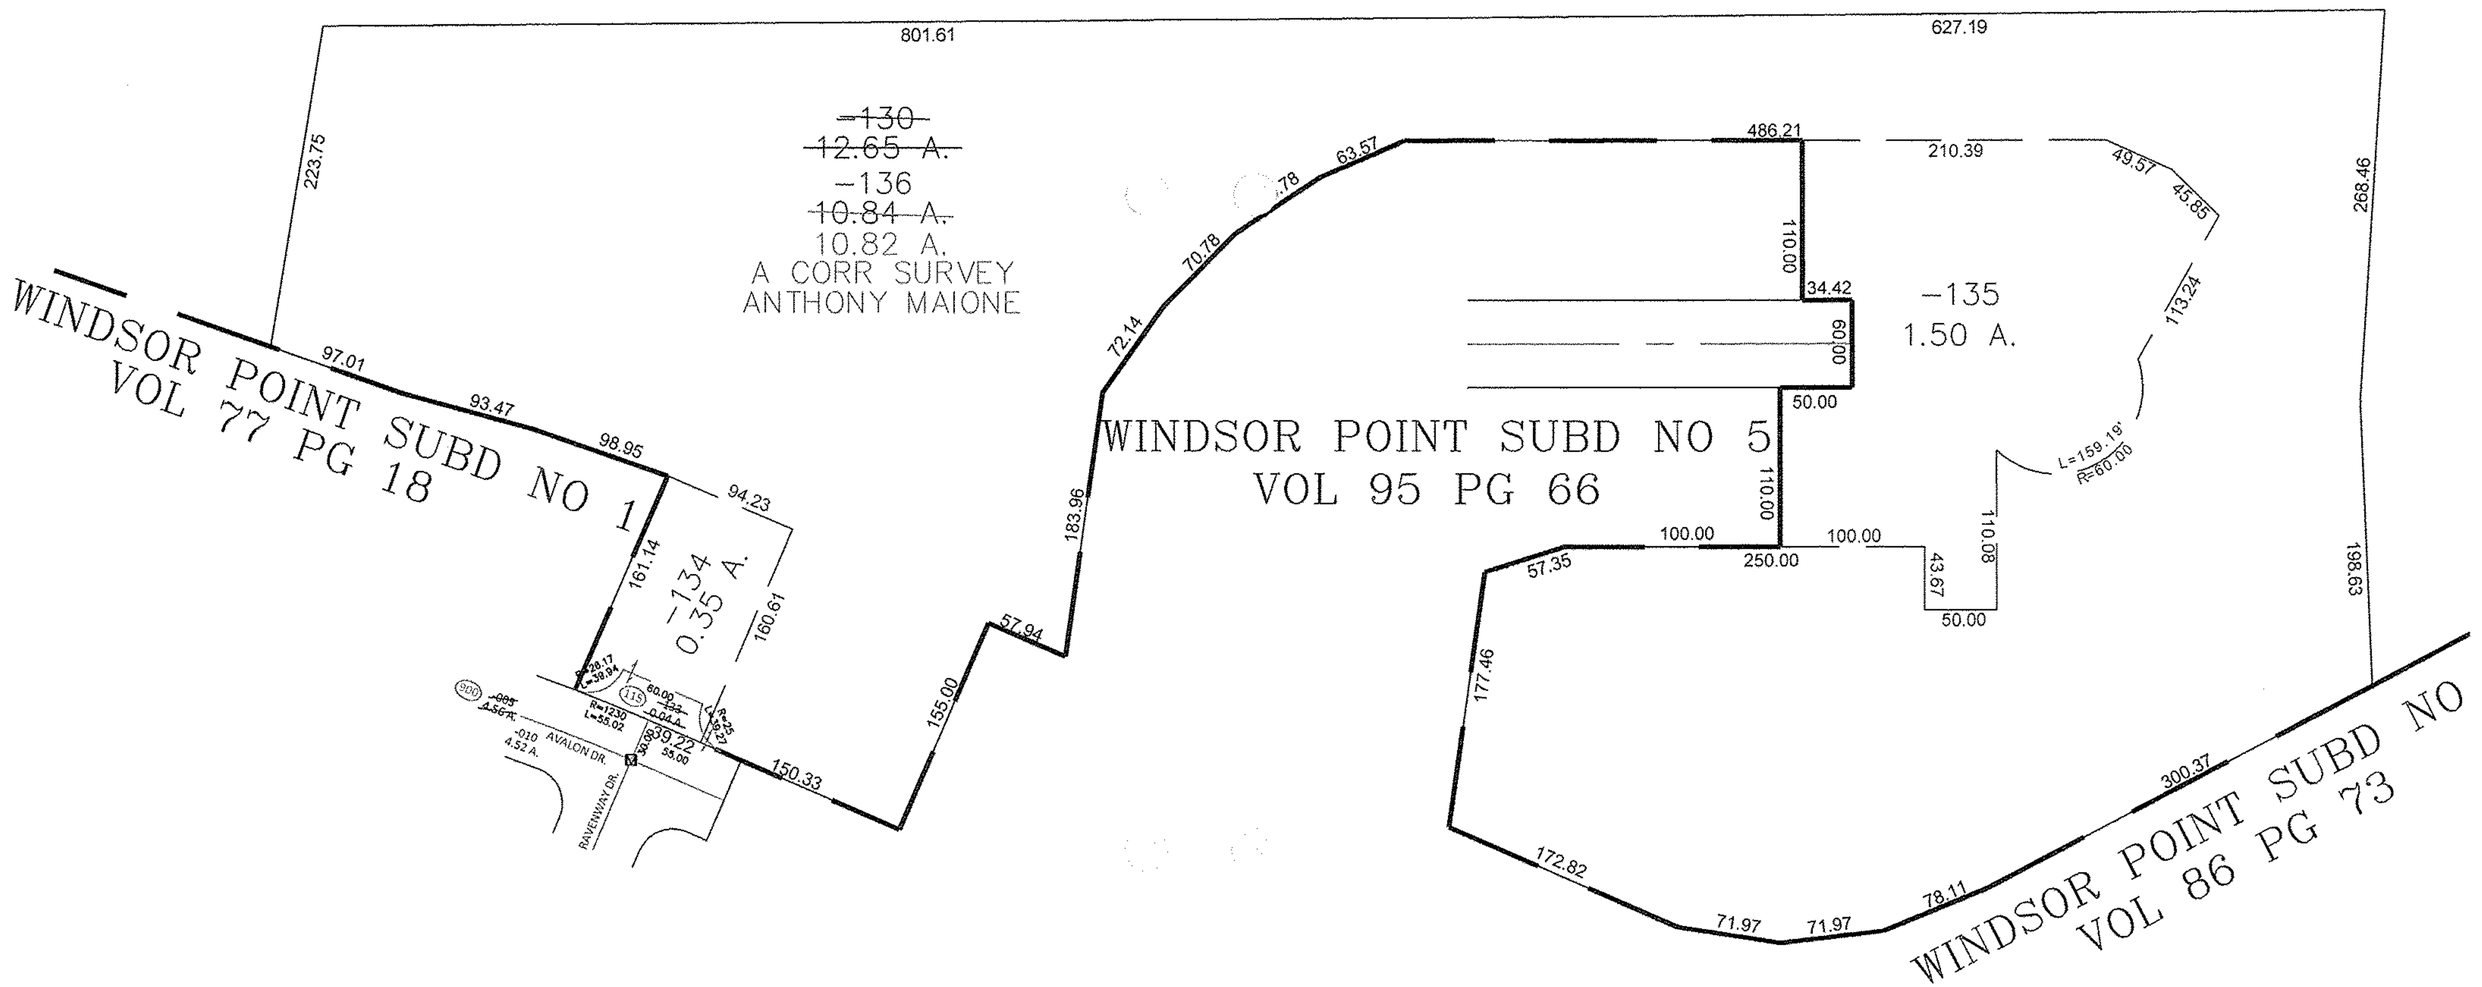

801.61
627.19
223.75
~~-130~~
~~12.65 A.~~
-136
~~10.84 A.~~
10.82 A.
A CORR SURVEY
ANTHONY MAIONE
WINDSOR POINT SUBD NO 1
VOL 77 PG 18
97.01
93.47
98.95
94.23
161.14
-134
0.35 A.
160.61
150.33
155.00
57.94
183.96
72.14
70.78
63.57
486.21
210.39
49.57
45.85
268.46
110.00
34.42
-135
1.50 A.
60.00
50.00
113.24
WINDSOR POINT SUBD NO 5
VOL 95 PG 66
110.00
100.00
250.00
100.00
43.67
50.00
110.08
57.35
177.46
172.82
71.97
71.97
78.11
300.37
198.63
WINDSOR POINT SUBD NO
VOL 86 PG 73
AVALON DR.
RAVENWAY DR.