PARENT PARCEL: 06-25-030-101-005
CHILD PARCEL: 06-25-030-900-003
STARTING POINT: PV. 22/73 & PV 22/35

15-03101-C

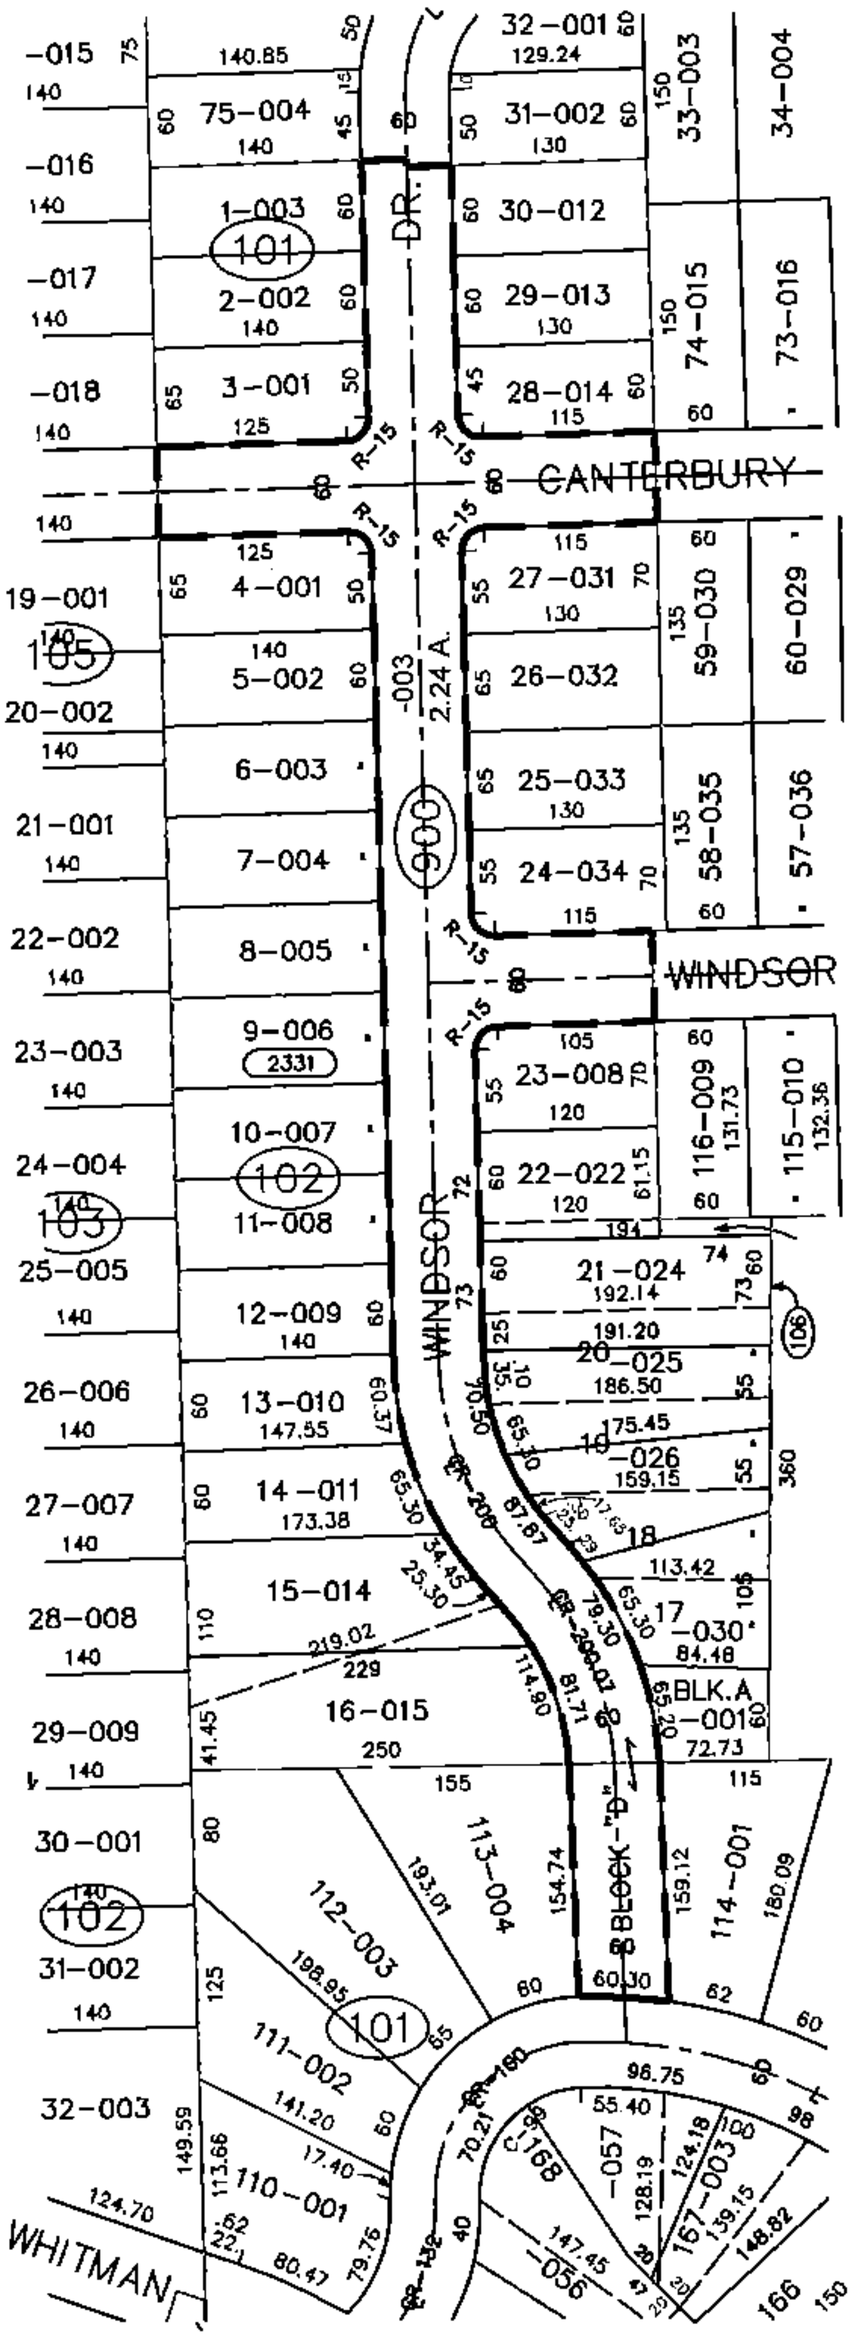

DROP FROM DUPLICATE

06-25-030-101-005
60.30 X ?
PER PV. 22 PG. 73

ADD TO DUPLICATE

06-25-030-900-003
2.24 A.
PER PV. 22 PG. 73

SPLITS/DEEDS PROCESSED

LORAIN COUNTY TAX MAP DEPARTMENT
226 MIDDLE AVE. ELYRIA, OHIO

SURVEYED BY: WARDEN
CLOSURE: NA
MAP PAGE(S): 06-25-030
APPROVED BY: TJS DATE: 1/26/15
SCALE: 1"= 200 PRIOR INSTRUMENT: DV XXXX/XXX