PARENT PARCEL: 09-00-085-112-027, -031, & -083

CHILD PARCEL: 09-00-085-112-093 THRU -098

STARTING POINT: MON. BOX, CL OF WEST COLLEGE ST. & CL OF SOUTH MAIN ST.

13-03116

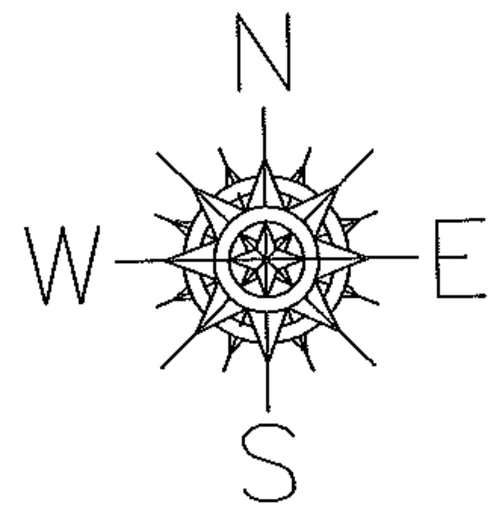

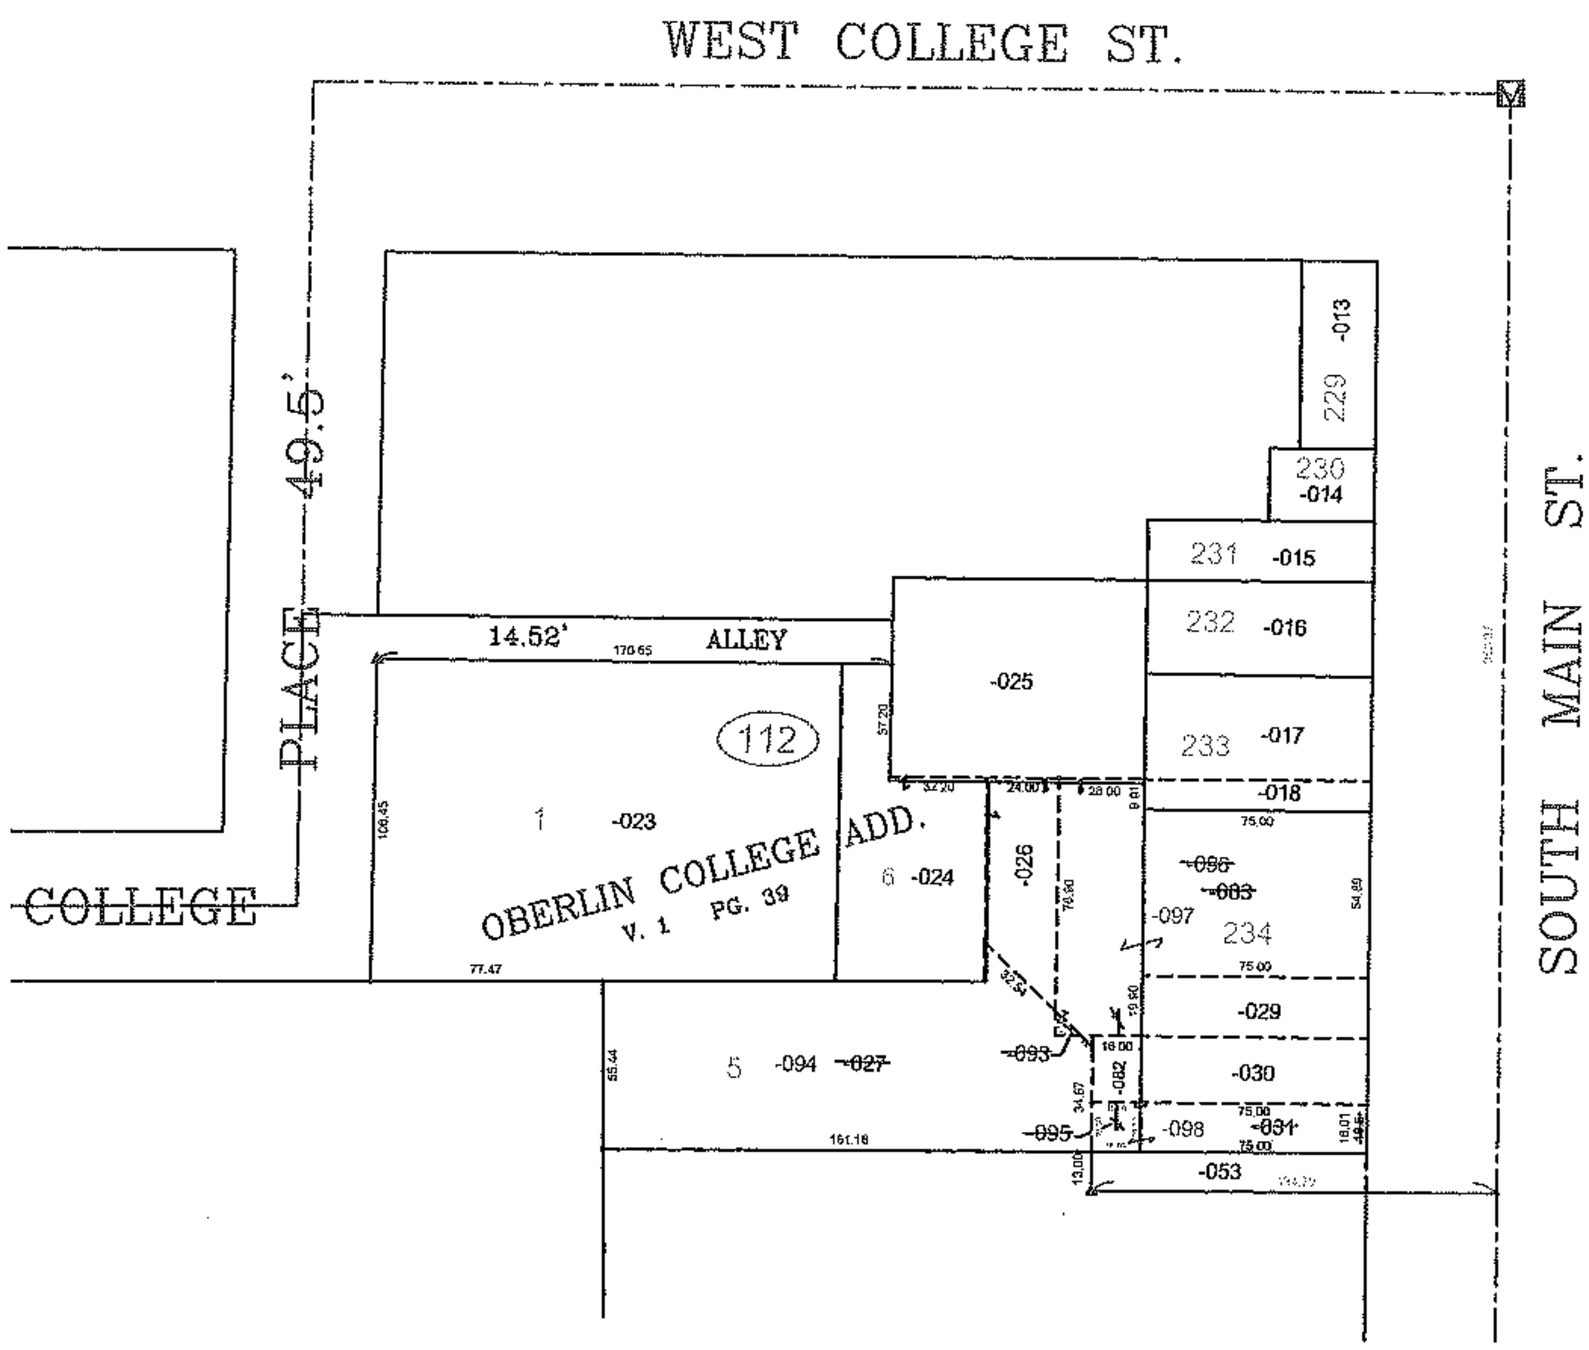

PRIOR INSTRUMENT: DV 718/223

PRIOR INSTRUMENT: DV 718/223

PRIOR INSTRUMENT: DV 772/183

SPLITS/DEEDS PROCESSED

LORAIN COUNTY TAX MAP DEPARTMENT
226 MIDDLE AVE. ELYRIA, OHIO

SURVEYED BY: RICHARD A. FREDRICKSON

CLOSURE: 0.01 : 10,000

MAP PAGE(S): 09-00-085-B

APPROVED BY: TJS DATE: 2/4/13

SCALE: 1"= 100