PARENT PARCEL: 18-00-020-000-121

CHILD PARCEL: 18-00-020-000-130, -131

STARTING POINT: CENTERLINE OF PECK-WADSWORTH RD & ST RT 58

13-03117

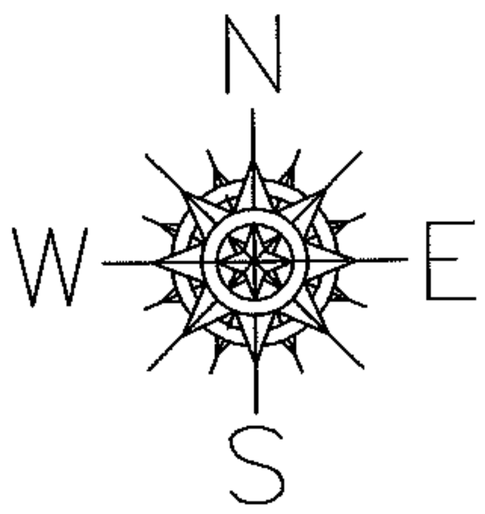

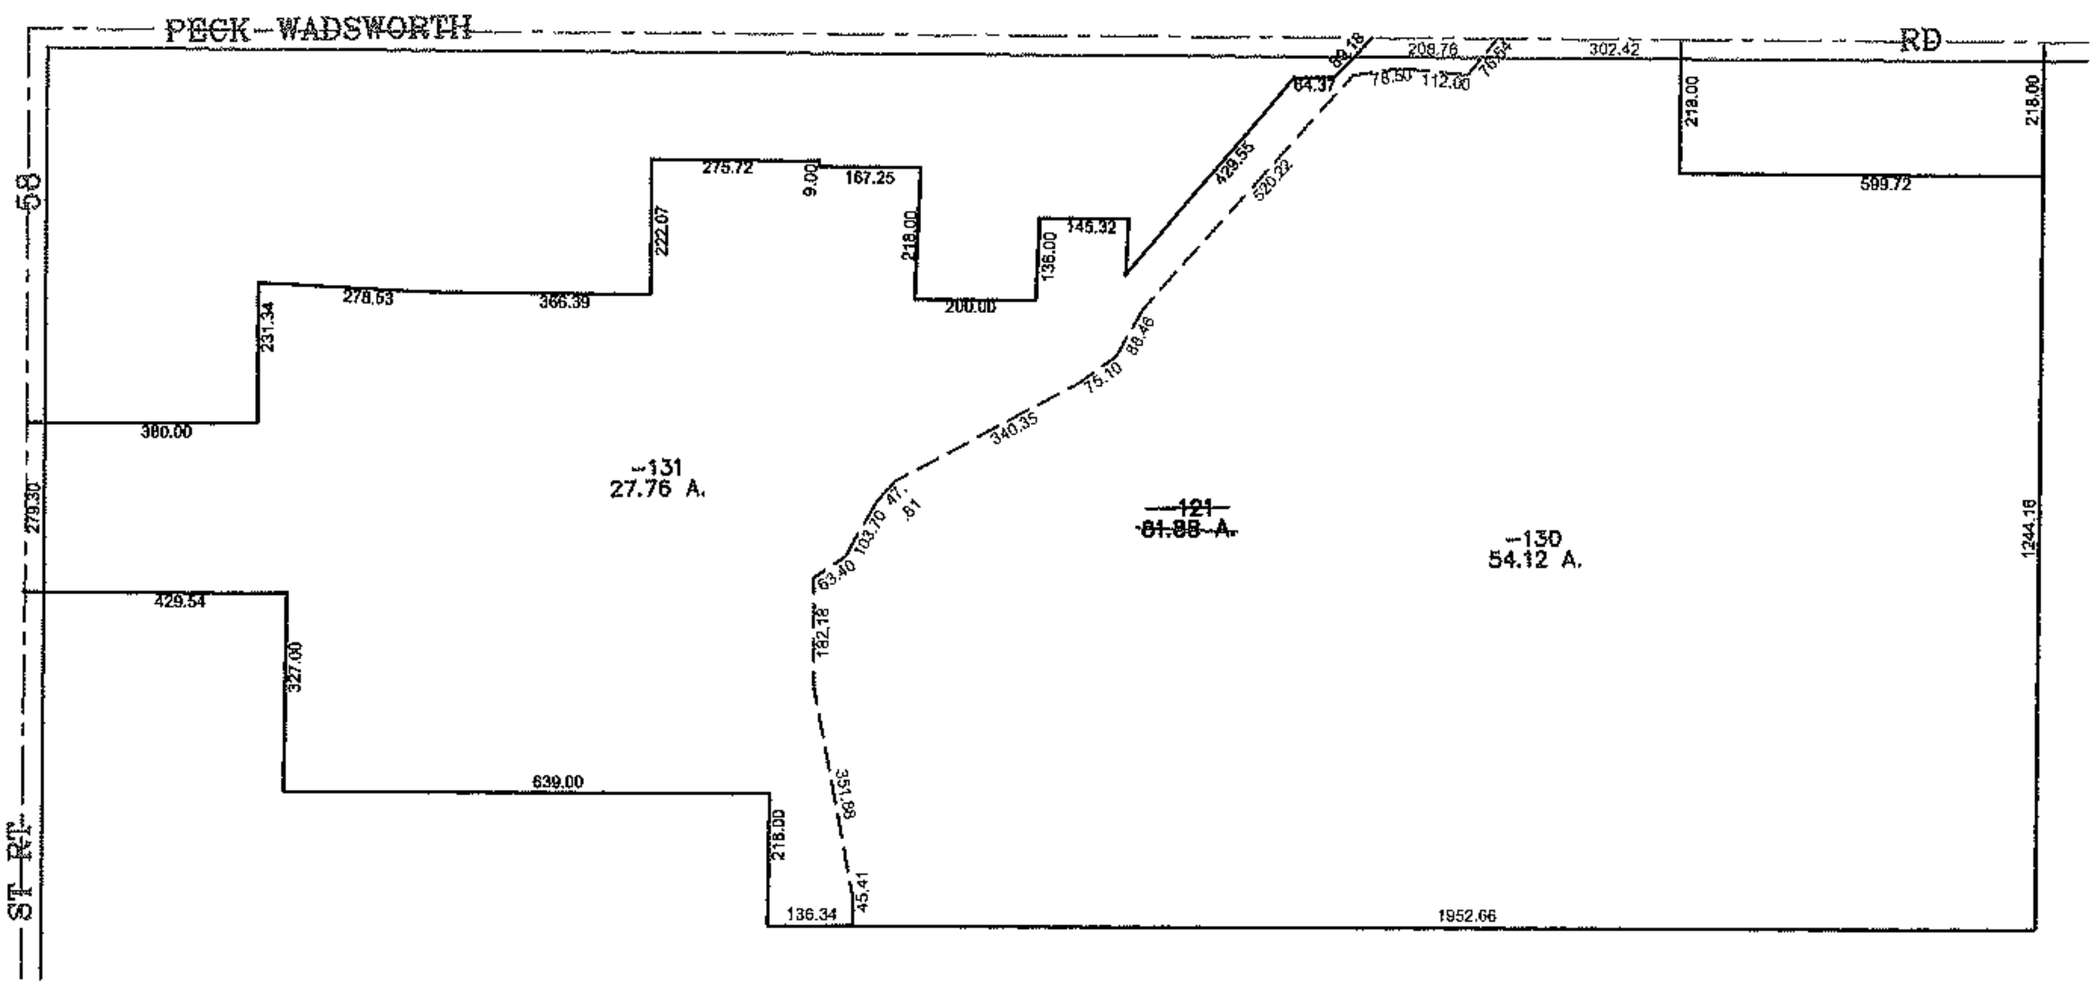

SPLITS/DEEDS PROCESSED

LORAIN COUNTY TAX MAP DEPARTMENT

226 MIDDLE AVE. ELYRIA, OHIO

SURVEYED BY: THOMAS SNEZEK

CLOSURE: 0.00 : 10,000

MAP PAGE(S): 18-00-020-B

APPROVED BY: JAH DATE: 02-04-2013

SCALE: 1"= 500 PRIOR INST.: 20120409891