PARENT PARCEL: 04-00-028-101-097 & -100

CHILD PARCEL: 04-00-028-101-104 THRU -106

STARTING POINT: I.P. MON. BOX, S.W. CORNER OF SECTION 28

13-03167

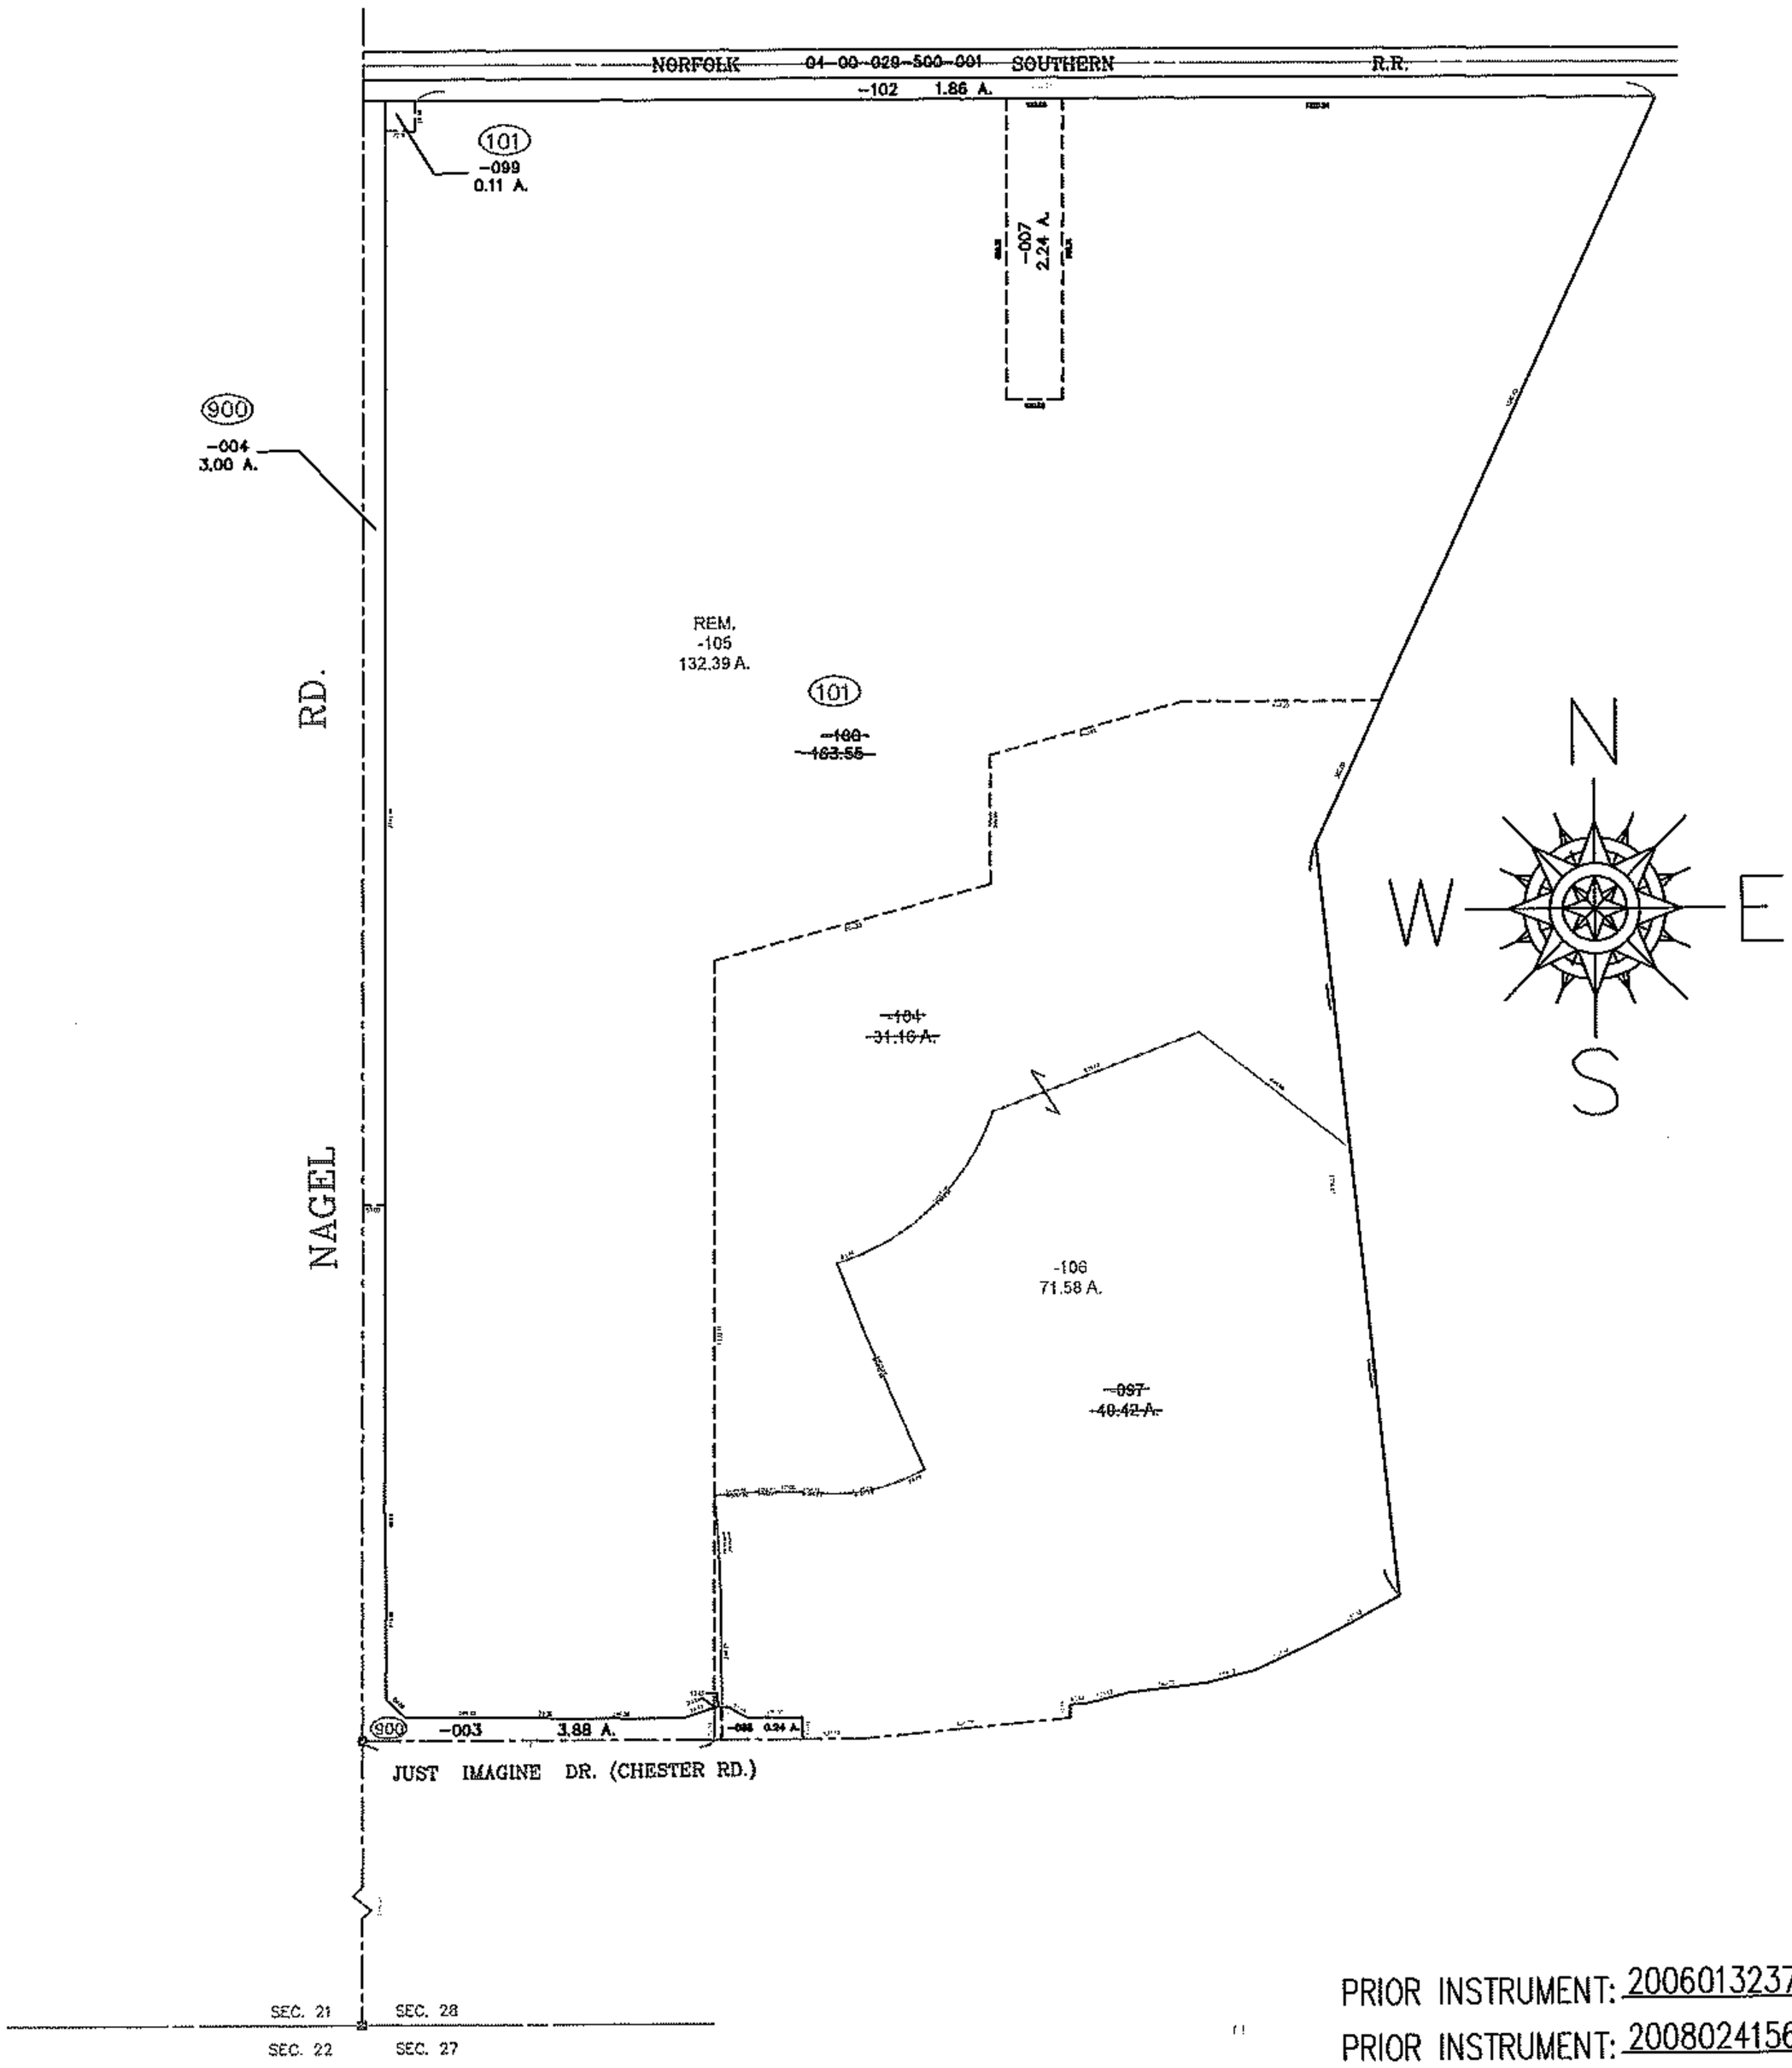


PRIOR INSTRUMENT: 20060132374

PRIOR INSTRUMENT: 20080241560

SPLITS/DEEDS PROCESSED

LORAIN COUNTY TAX MAP DEPARTMENT
226 MIDDLE AVE. ELYRIA, OHIO

SURVEYED BY: CHRISTOPHER J. TOMKO

CLOSURE: 0.01 : 10,000

MAP PAGE(S): 4-00-028

APPROVED BY: TJS DATE: 7/24/13

SCALE: 1"= 600