PARENT PARCEL: 12-00-074-000-039

CHILD PARCEL: 12-00-074-000-040, -041

STARTING POINT: AT A MON BOX AT THE INTERSECTION OF C/L OF CAPEL RD. AND C/L OF STATION RD.

13-03176

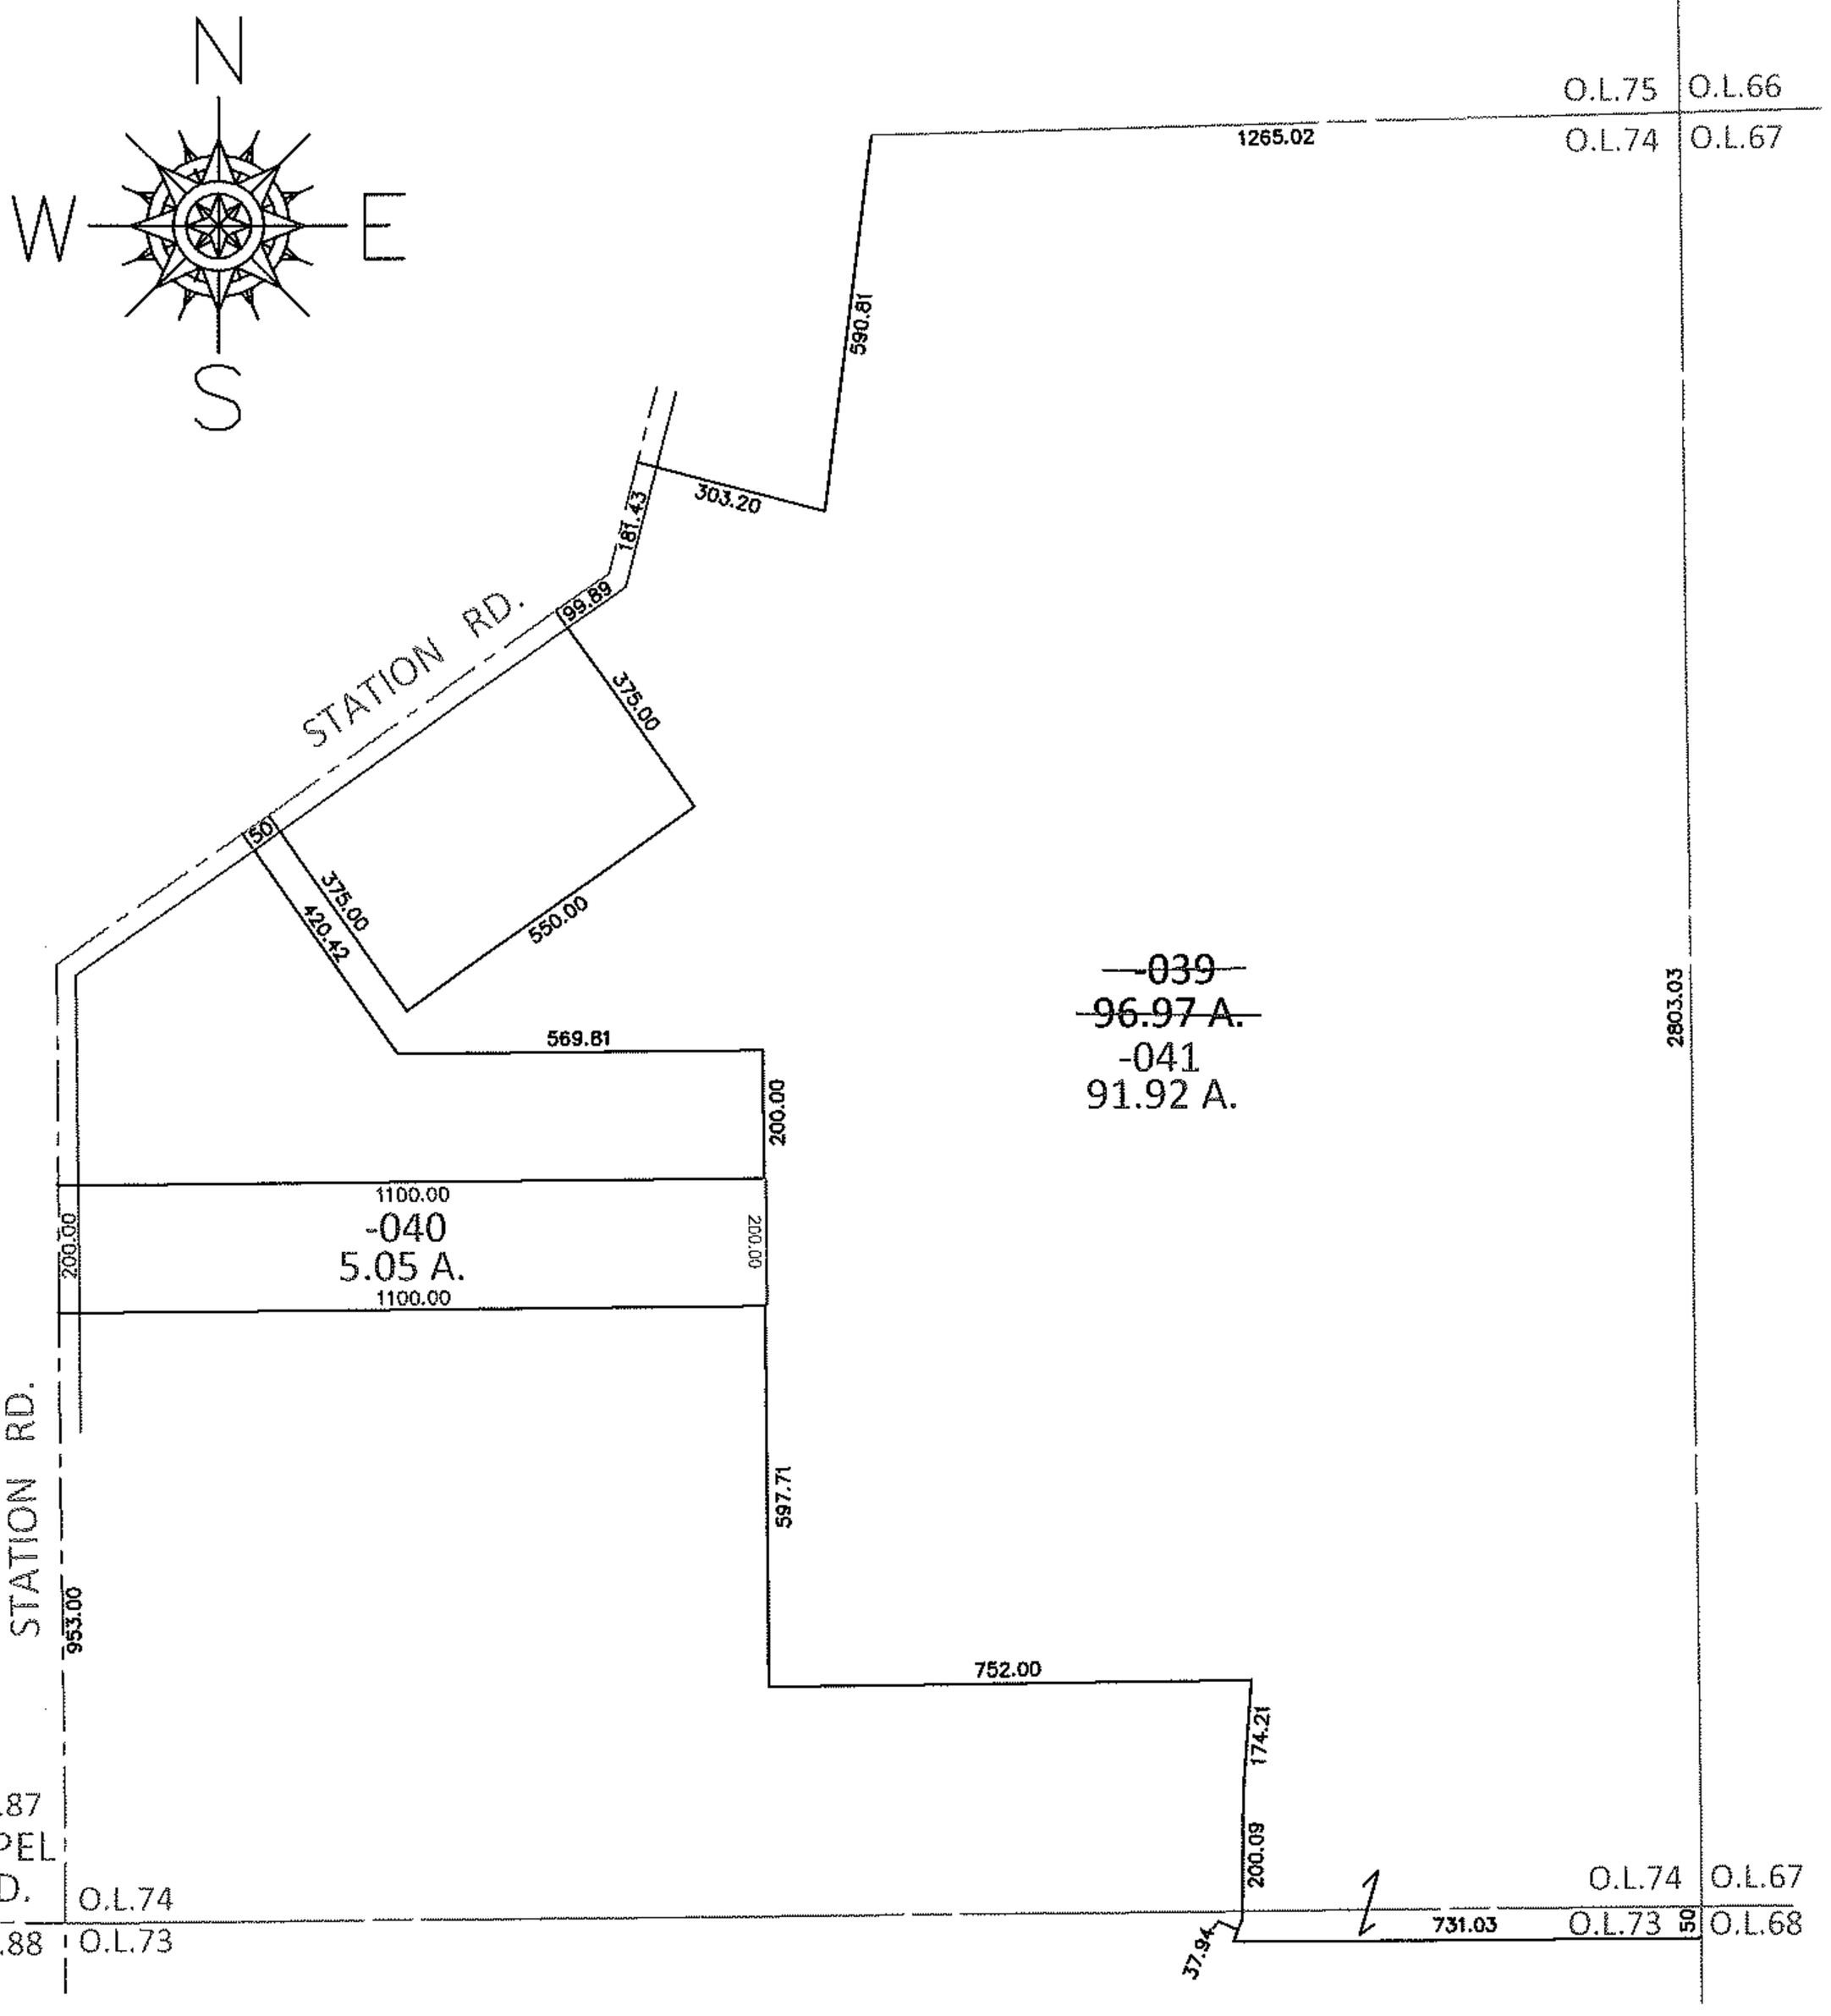

SPLITS/DEEDS PROCESSED

LORAIN COUNTY TAX MAP DEPARTMENT

226 MIDDLE AVE. ELYRIA, OHIO

SURVEYED BY: THOMAS A. NEFF JR.

CLOSURE: .01:10,000

MAP PAGE(S): 12-E

APPROVED BY: JAH DATE: 8/13/2013

SCALE: 1"= 400 PRIOR INST.: DV 1314/93