PARENT PARCEL: 12-00-089-000-016

CHILD PARCEL: 12-00-089-630-001

STARTING POINT:

15-03178-A

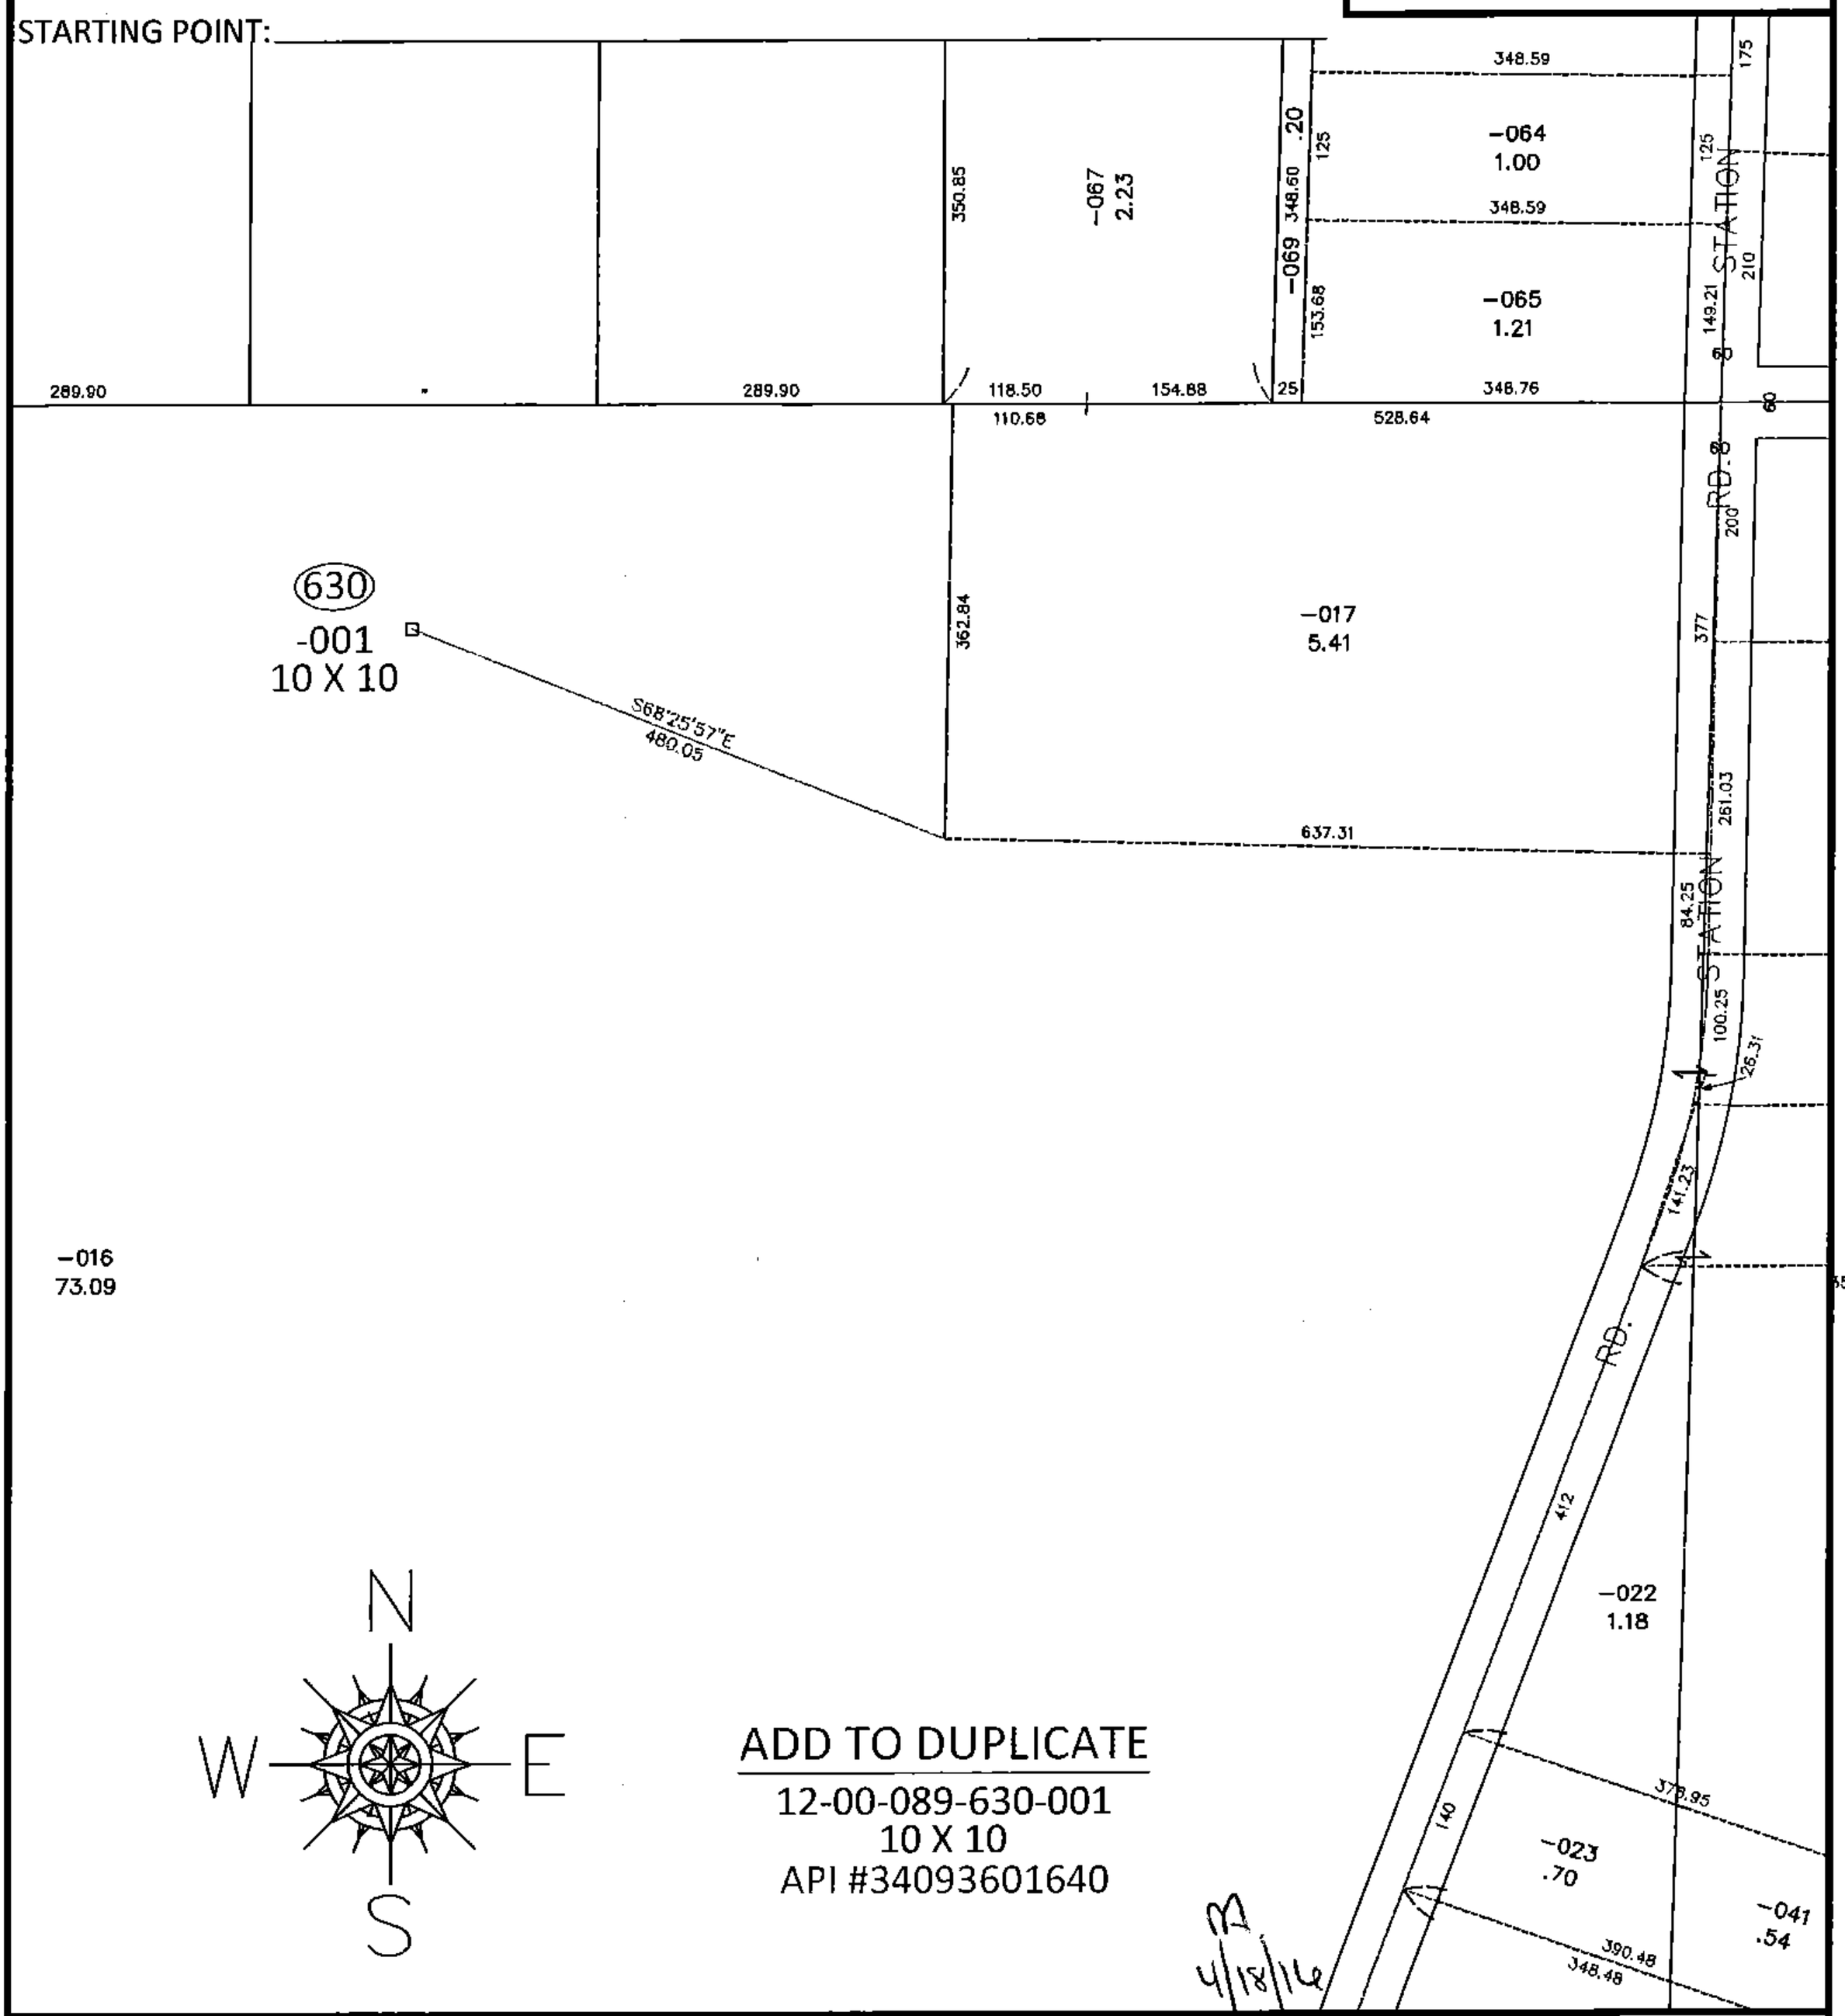

ADD TO DUPLICATE

12-00-089-630-001
10 X 10
API #34093601640

M
4/18/16

SPLITS/DEEDS PROCESSED

LORAIN COUNTY TAX MAP DEPARTMENT
226 MIDDLE AVE. ELYRIA, OHIO

SURVEYED BY: N/A

CLOSURE: N/A

MAP PAGE(S): 12-E

APPROVED BY: RRM DATE: 5-6-15

SCALE: 1"= 200 PRIOR INST.: