PARENT PARCEL: 07-00-016-112-049, 07-00-017-130-011

CHILD PARCEL: 07-00-016-112-052 THRU -054 07-00-017-130-015 THRU -017

STARTING POINT: SOUTHEASTERLY CORNER OF S/L 184 IN WIL LOU ACRES SUBD NO 4

13-03178

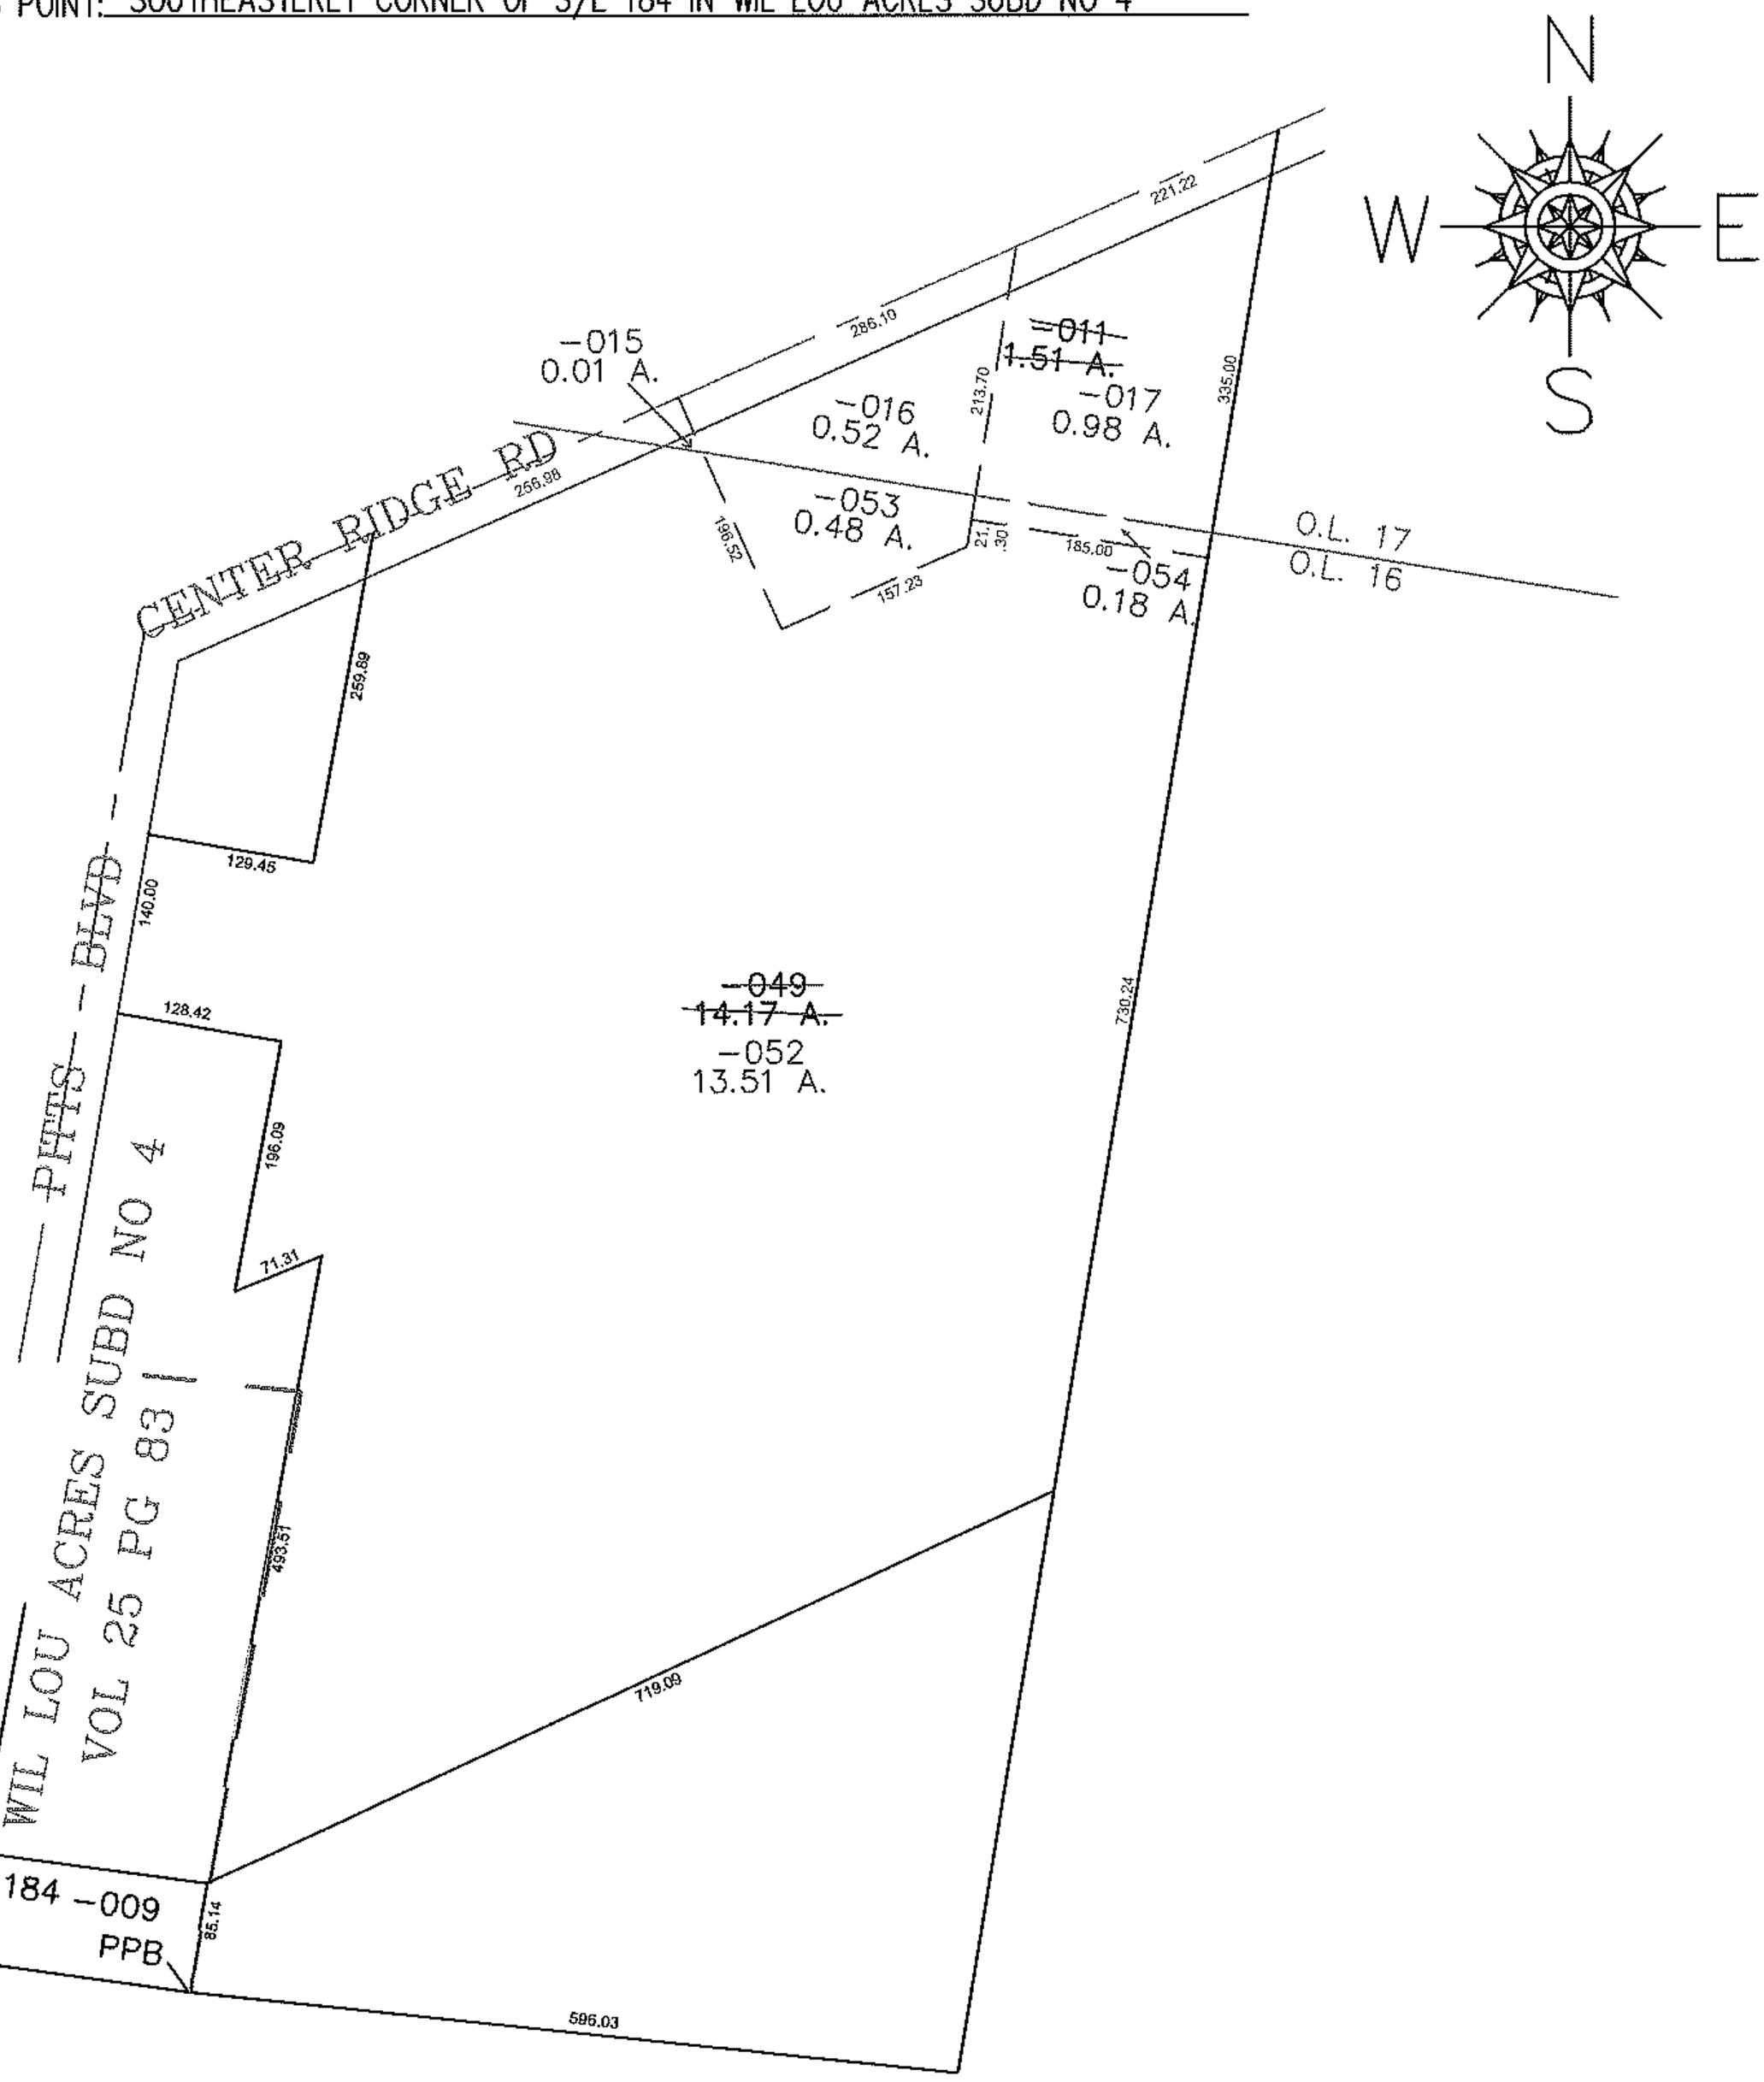

SPLITS/DEEDS PROCESSED

LORAIN COUNTY TAX MAP DEPARTMENT
226 MIDDLE AVE. ELYRIA, OHIO

SURVEYED BY: TIMOTHY J FELLER

CLOSURE: 0.00 : 10,000

MAP PAGE(S): 07-00-016-B

APPROVED BY: JAH DATE: 8/16/2013

SCALE: 1"= 200 PRIOR INSTRUMENT: 20120403731