PARENT PARCEL: 05-00-030-000-027, -029, -023, -028

CHILD PARCEL: 05-00-030-000-063 THRU -066

STARTING POINT: CENTERLINE OF ANNIS RD & TELEGRAPH RD

13-03209

N

W E

S

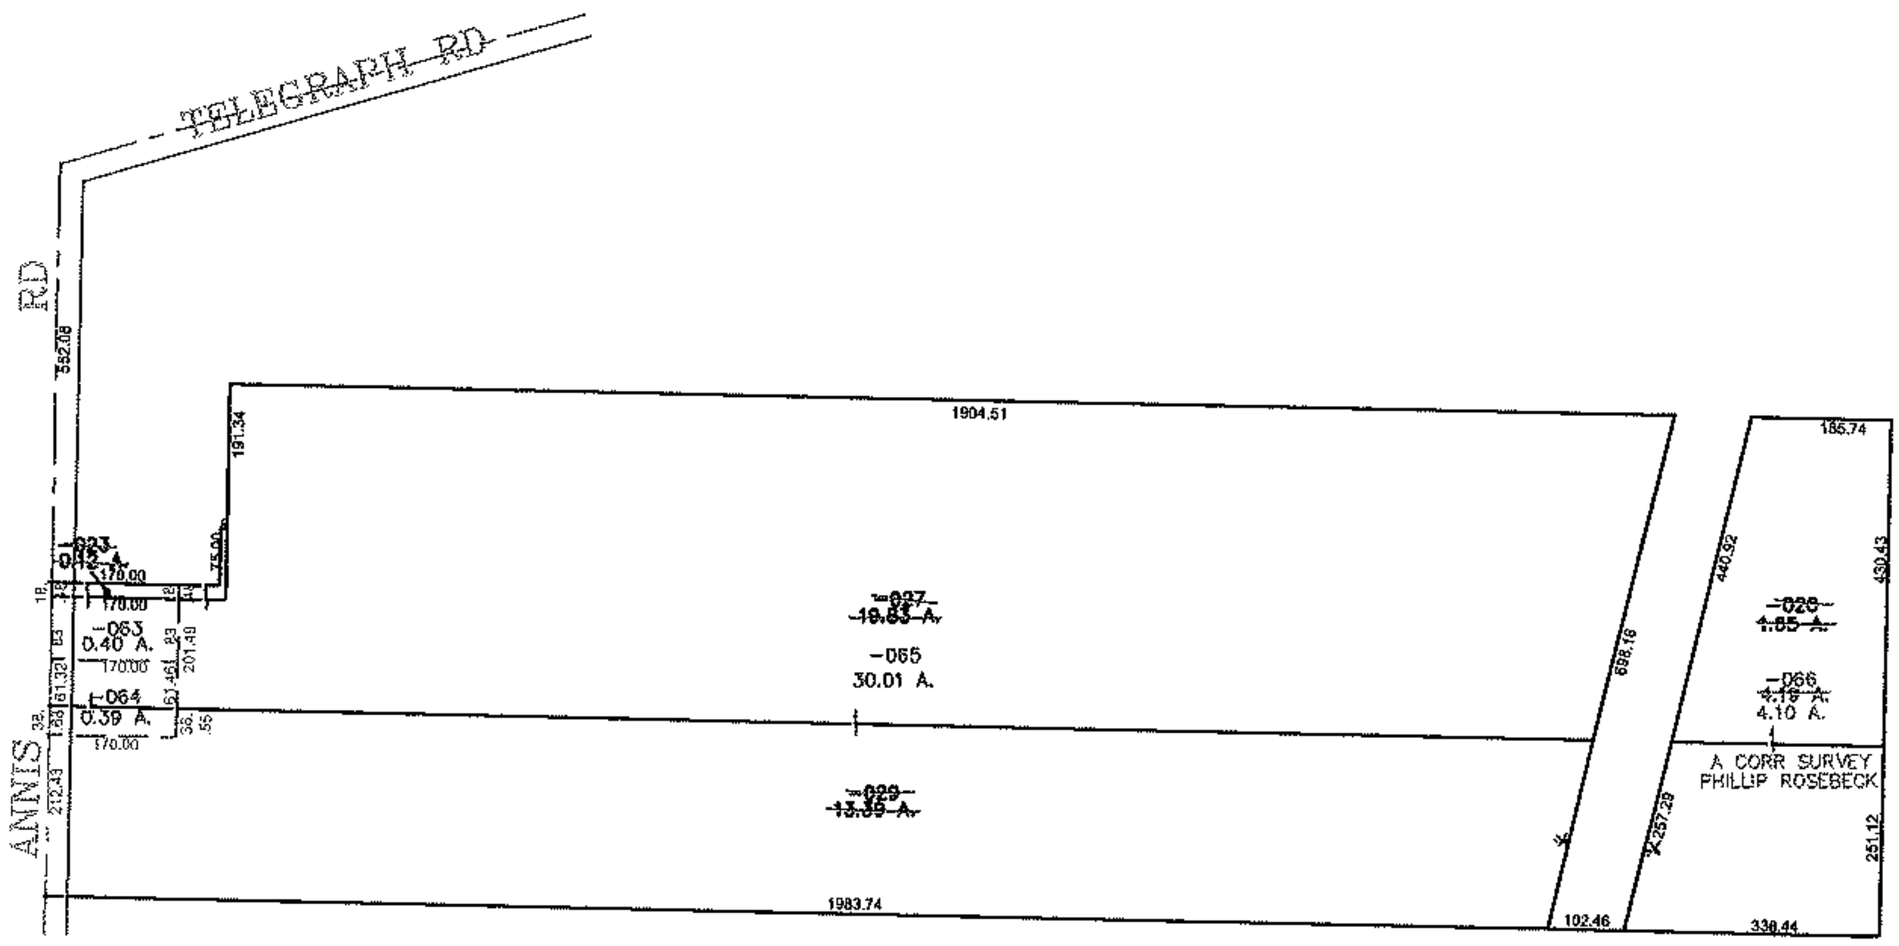

SPLITS/DEEDS PROCESSED

LORAIN COUNTY TAX MAP DEPARTMENT

226 MIDDLE AVE. ELYRIA, OHIO

SURVEYED BY: PHILLIP ROSEBECK

CLOSURE: 0.00 : 10,000

MAP PAGE(S): 05-00-030-A, B

APPROVED BY: JAH DATE: 12/17/2013

SCALE: 1"= 400 PRIOR INST.: 20120437525