PARENT PARCEL: 06-22-016-000-009

CHILD PARCEL: 06-22-016-000-0110, -011 06-22-015-101-009

STARTING POINT: CENTERLINE OF FREEDOM COURT AND THE SOUTHWESTERLY CORNER OF S/L 3

14-03219

N

W E

S

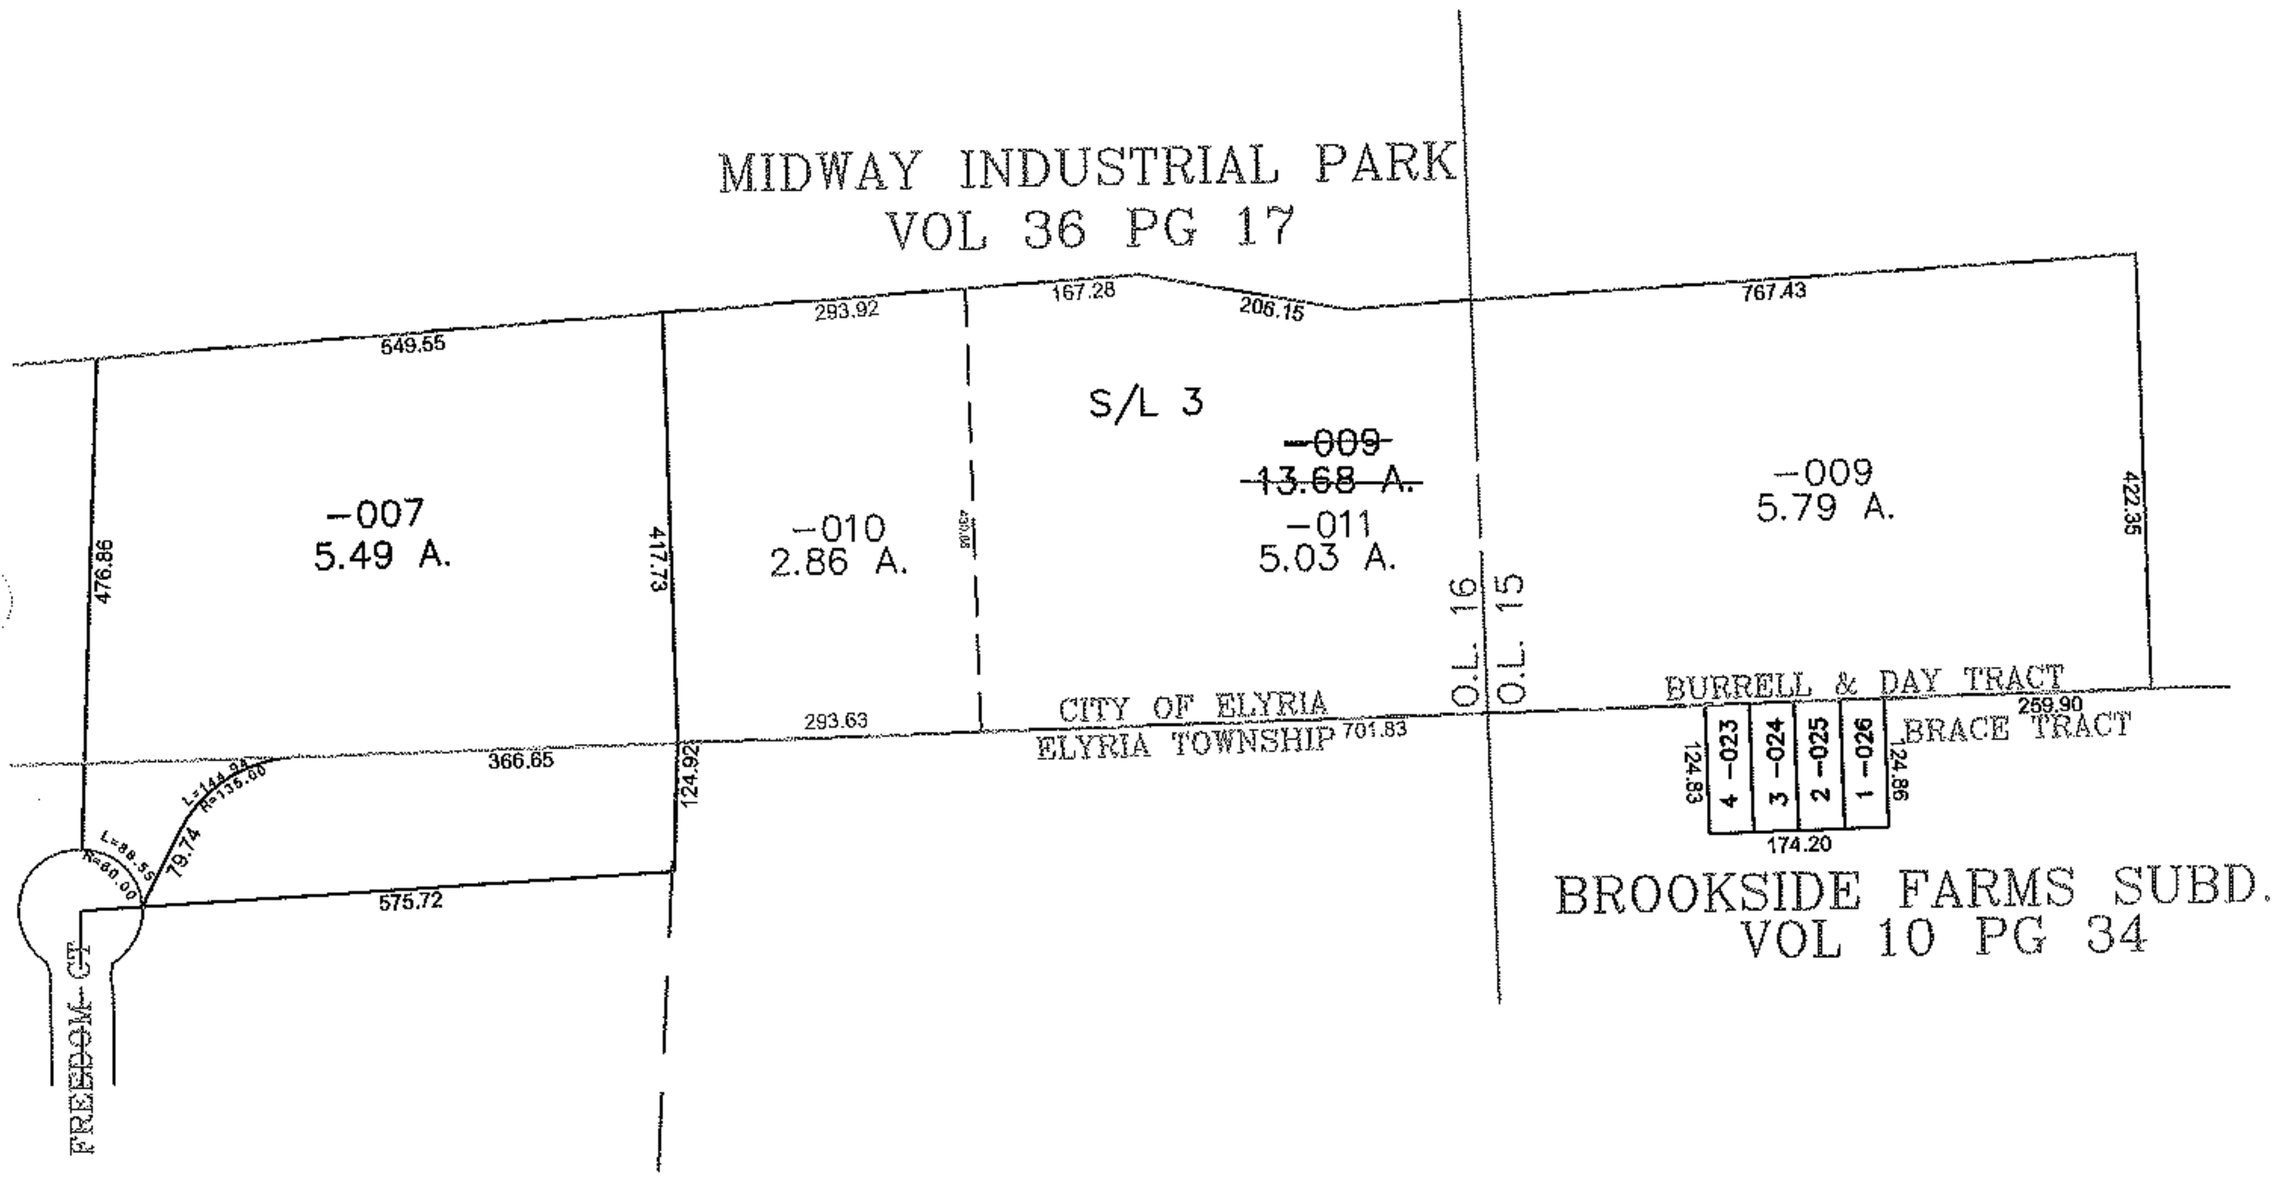

SPLITS/DEEDS PROCESSED

LORAIN COUNTY TAX MAP DEPARTMENT
226 MIDDLE AVE. ELYRIA, OHIO

SURVEYED BY: LELAND DILLWORTH

CLOSURE: 0.00 : 10,000

MAP PAGE(S): 6-8, 6-9

APPROVED BY: JAH DATE: 1-22-2014

SCALE: 1"= 300 PRIOR INSTRUMENT: 20040039666