PARENT PARCEL: 08-12-013-000-006, -021, & -022

CHILD PARCEL: 08-12-013-000-027 THRU -031

STARTING POINT: I.P. MON. BOX, CL OF BATES RD. & CL OF BAIRD RD.

14-03222

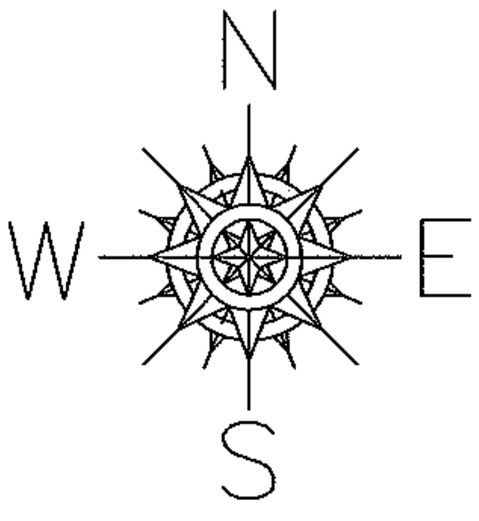

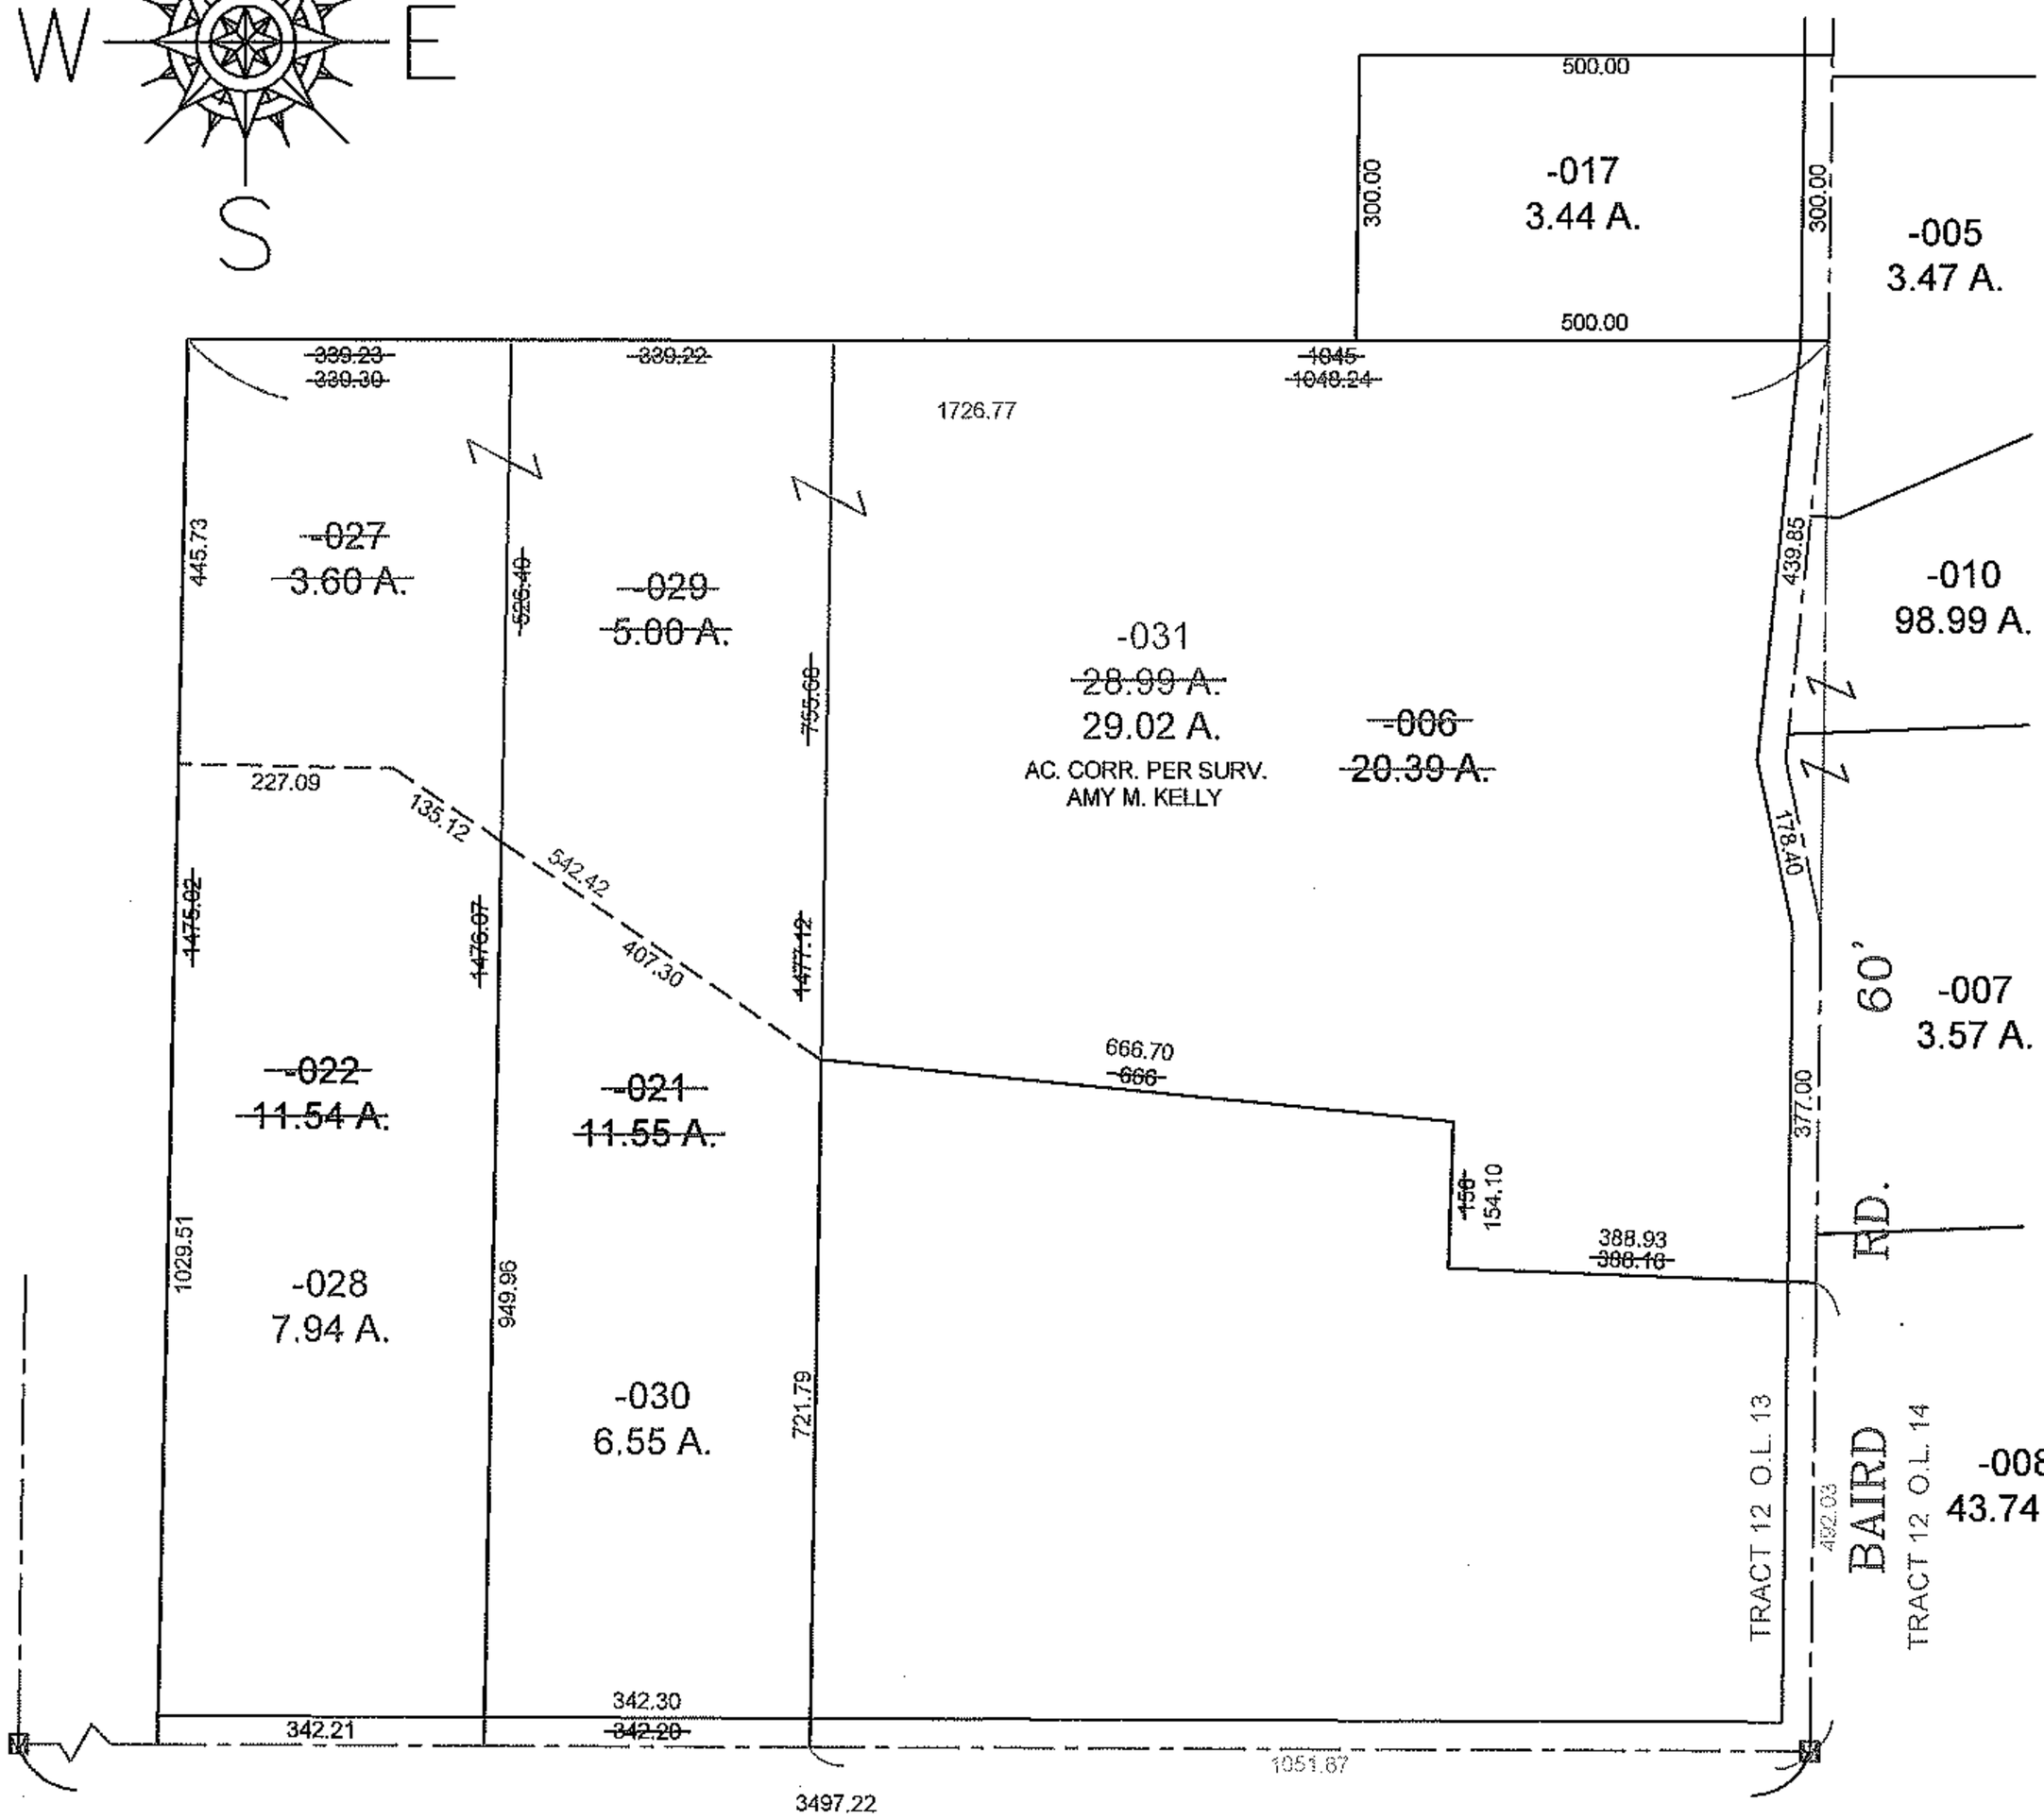

PRIOR INSTRUMENT: 20080239189

PRIOR INSTRUMENT: 20030951726

PRIOR INSTRUMENT: 20030951727

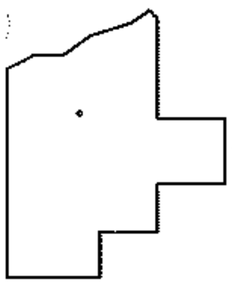

SPLITS/DEEDS PROCESSED

LORAIN COUNTY TAX MAP DEPARTMENT
226 MIDDLE AVE. ELYRIA, OHIO

SURVEYED BY: AMY M. KELLY

CLOSURE: 0.01 : 10,000

MAP PAGE(S): 8-E

APPROVED BY: TJS DATE: 1/29/14

SCALE: 1" = 300