PARENT PARCEL: 04-00-016-900-001

CHILD PARCEL: 04-00-016-101-212

STARTING POINT: XXXXXX

15-03234-C

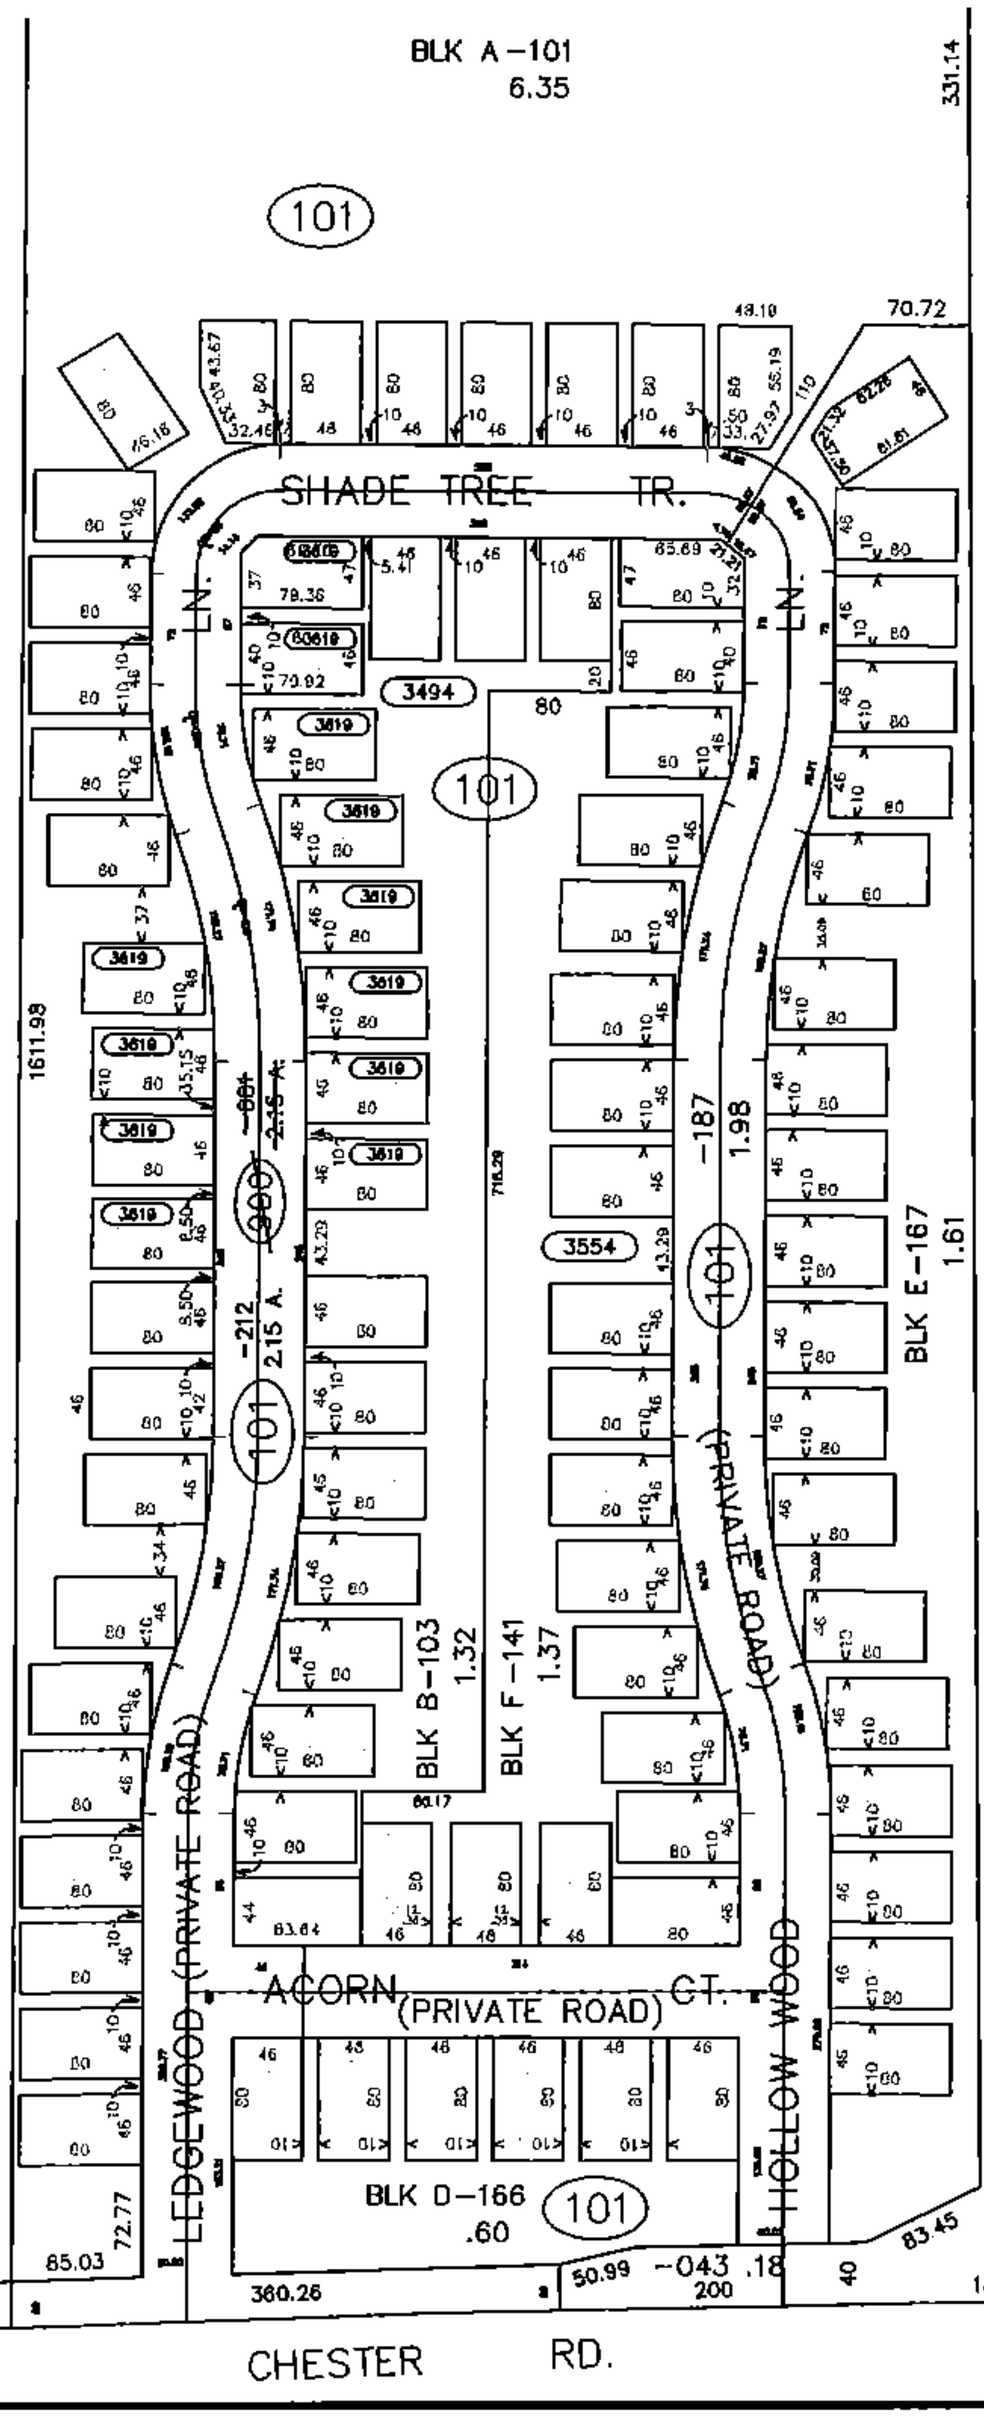

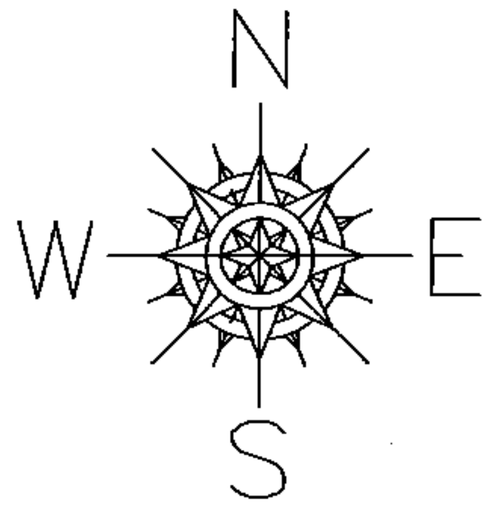

PARCEL & NAME CORRECTION

~~04-00-016-900-001~~
~~2.15 A.~~
~~CITY OF AVON~~

04-00-016-101-212
2.15 A.
PIN OAK PRESERVE
HOMEOWNERS ASSOC.

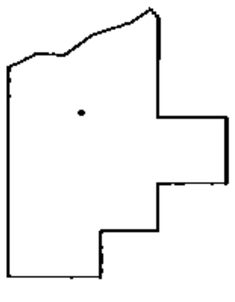

SPLITS/DEEDS PROCESSED

LORAIN COUNTY TAX MAP DEPARTMENT
226 MIDDLE AVE. ELYRIA, OHIO

SURVEYED BY: DONALD HIMES
CLOSURE: NA
MAP PAGE(S): 04-00-016
APPROVED BY: TJS DATE: 6/17/15
SCALE: 1"= 200 PRIOR INST.: PV 66/20