PARENT PARCEL: 04-00-028-101-109

CHILD PARCEL: 04-00-028-101-110, -111

STARTING POINT: CENTERLINE OF NAGEL RD & O.L. 28

14-03268

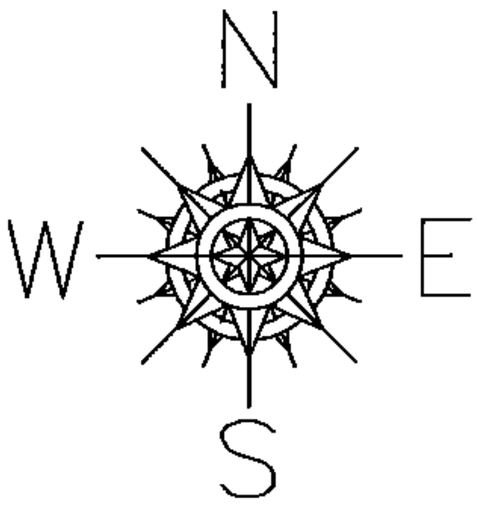

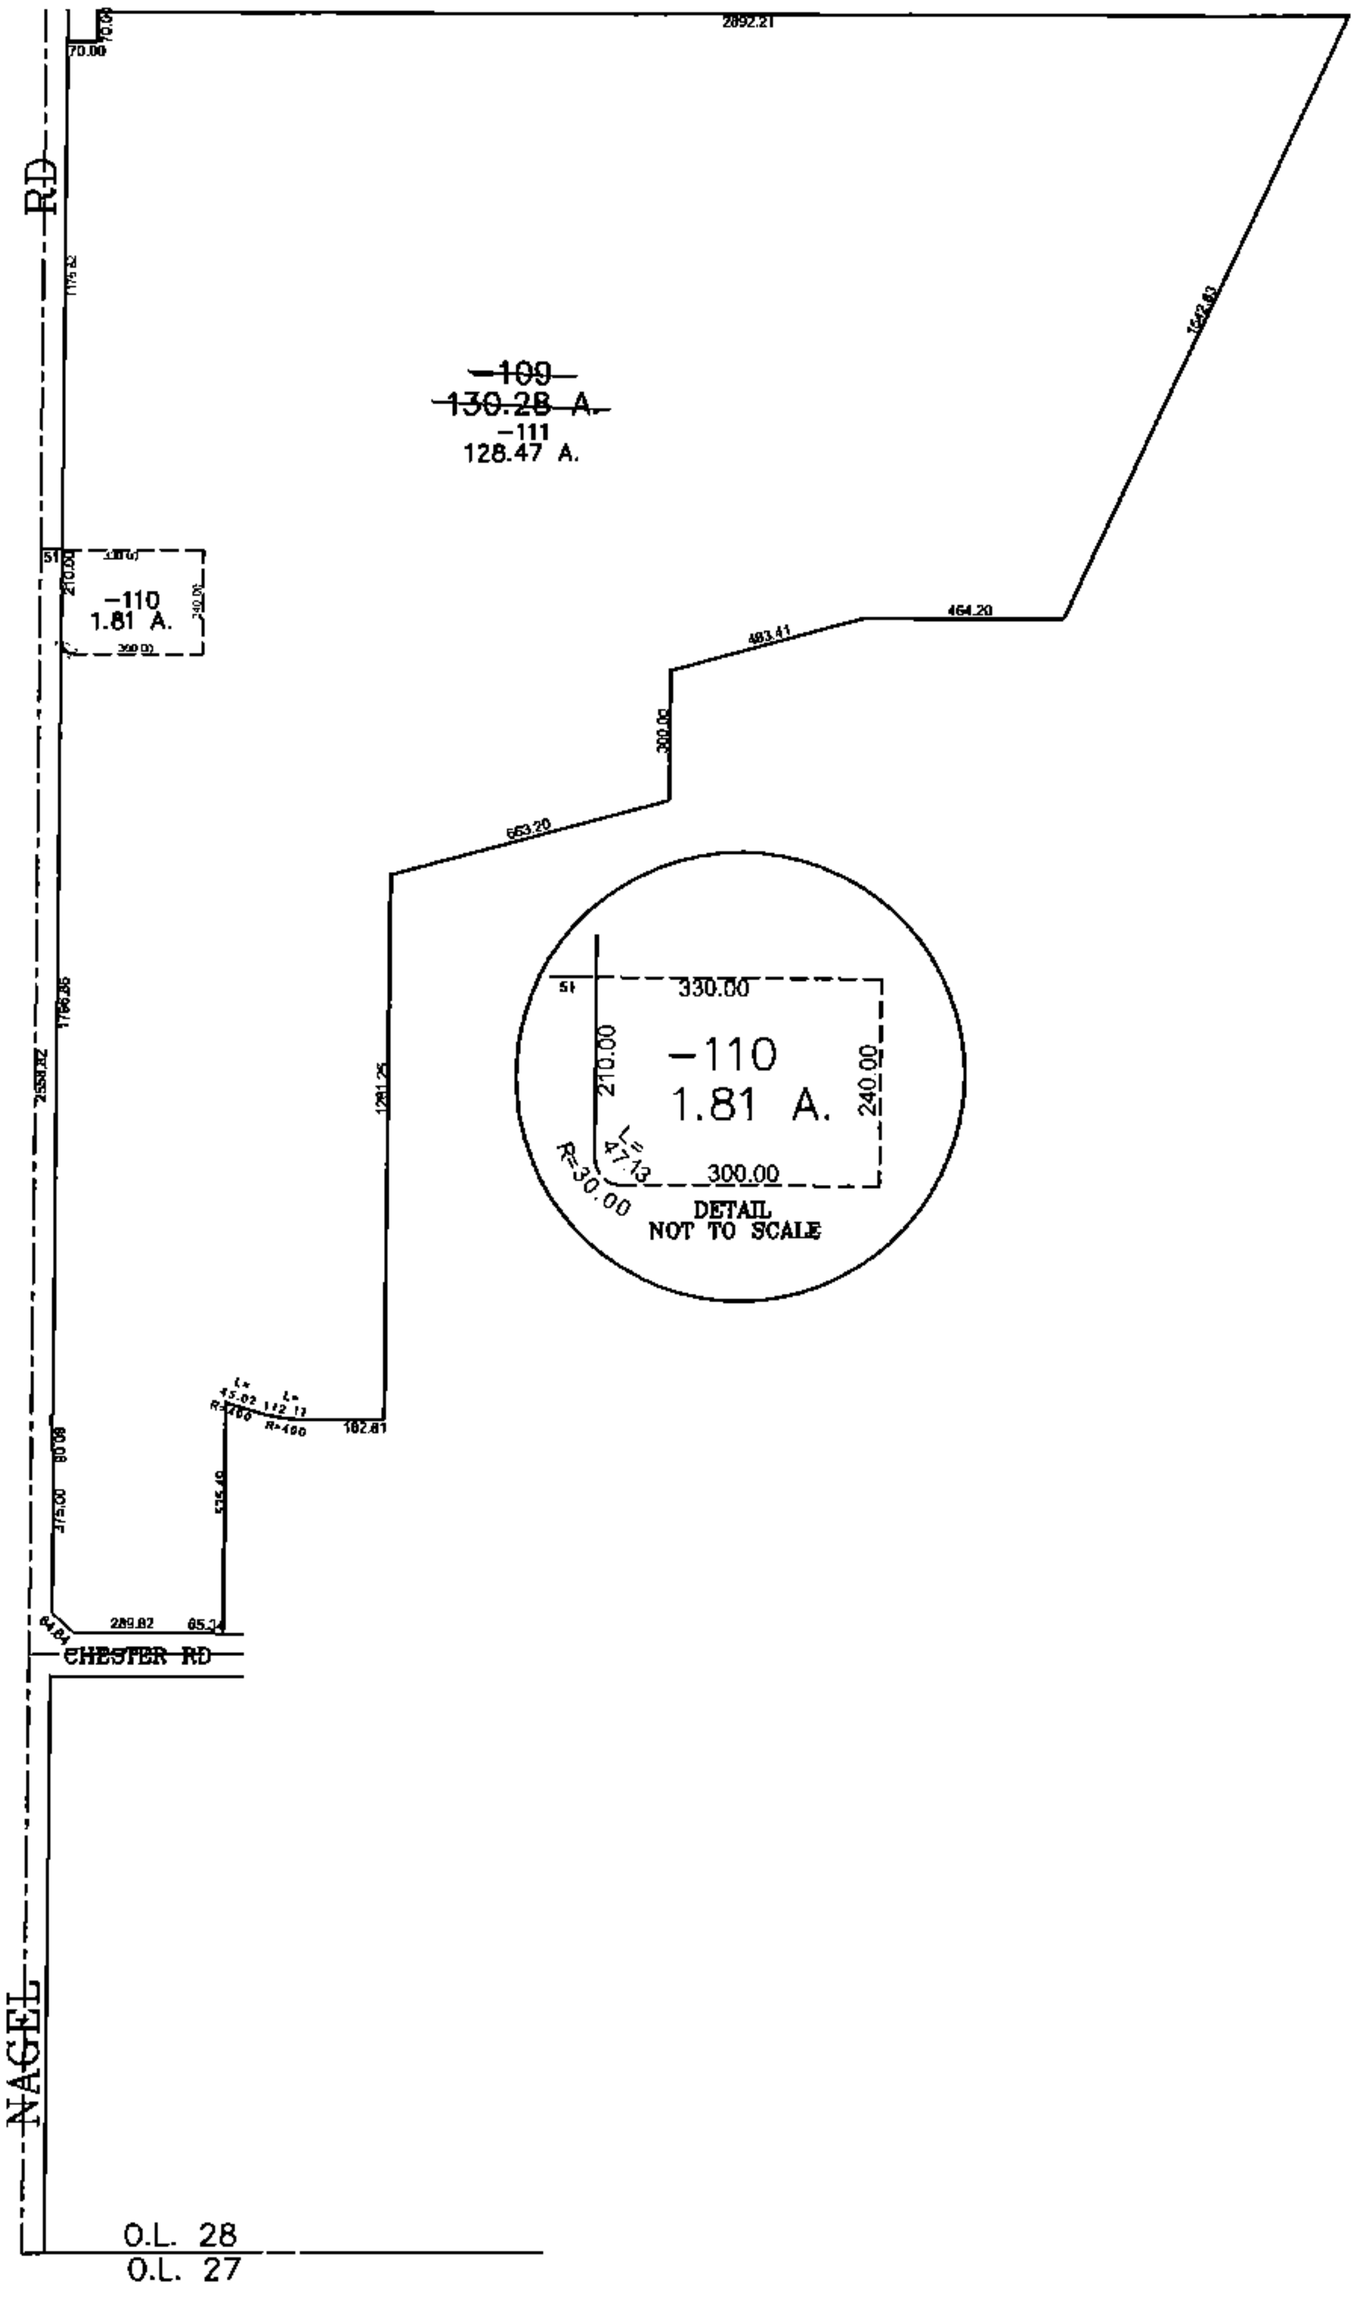

SPLITS/DEEDS PROCESSED

LORAIN COUNTY TAX MAP DEPARTMENT
226 MIDDLE AVE. ELYRIA, OHIO

SURVEYED BY: ALEX E MARKS

CLOSURE: 0.00 : 10,000

MAP PAGE(S): 04-00-028-A

APPROVED BY: JAH DATE: 7/30/2014

SCALE: 1"= 700 PRIOR INSTRUMENT: 20130482288