PARENT PARCEL: 12-00-077-000-001, 12-00-078-000-012, -013, -014, 12-00-083-000-009, 12-00-084-103-015

CHILD PARCEL: 12-00-077-000-001, 12-00-078-000-031, 12-00-083-000-009, 12-00-084-103-015

STARTING POINT: INTERSECTION OF C/L OF STATION RD. AND C/L OF NICHOLS RD.

14-03309

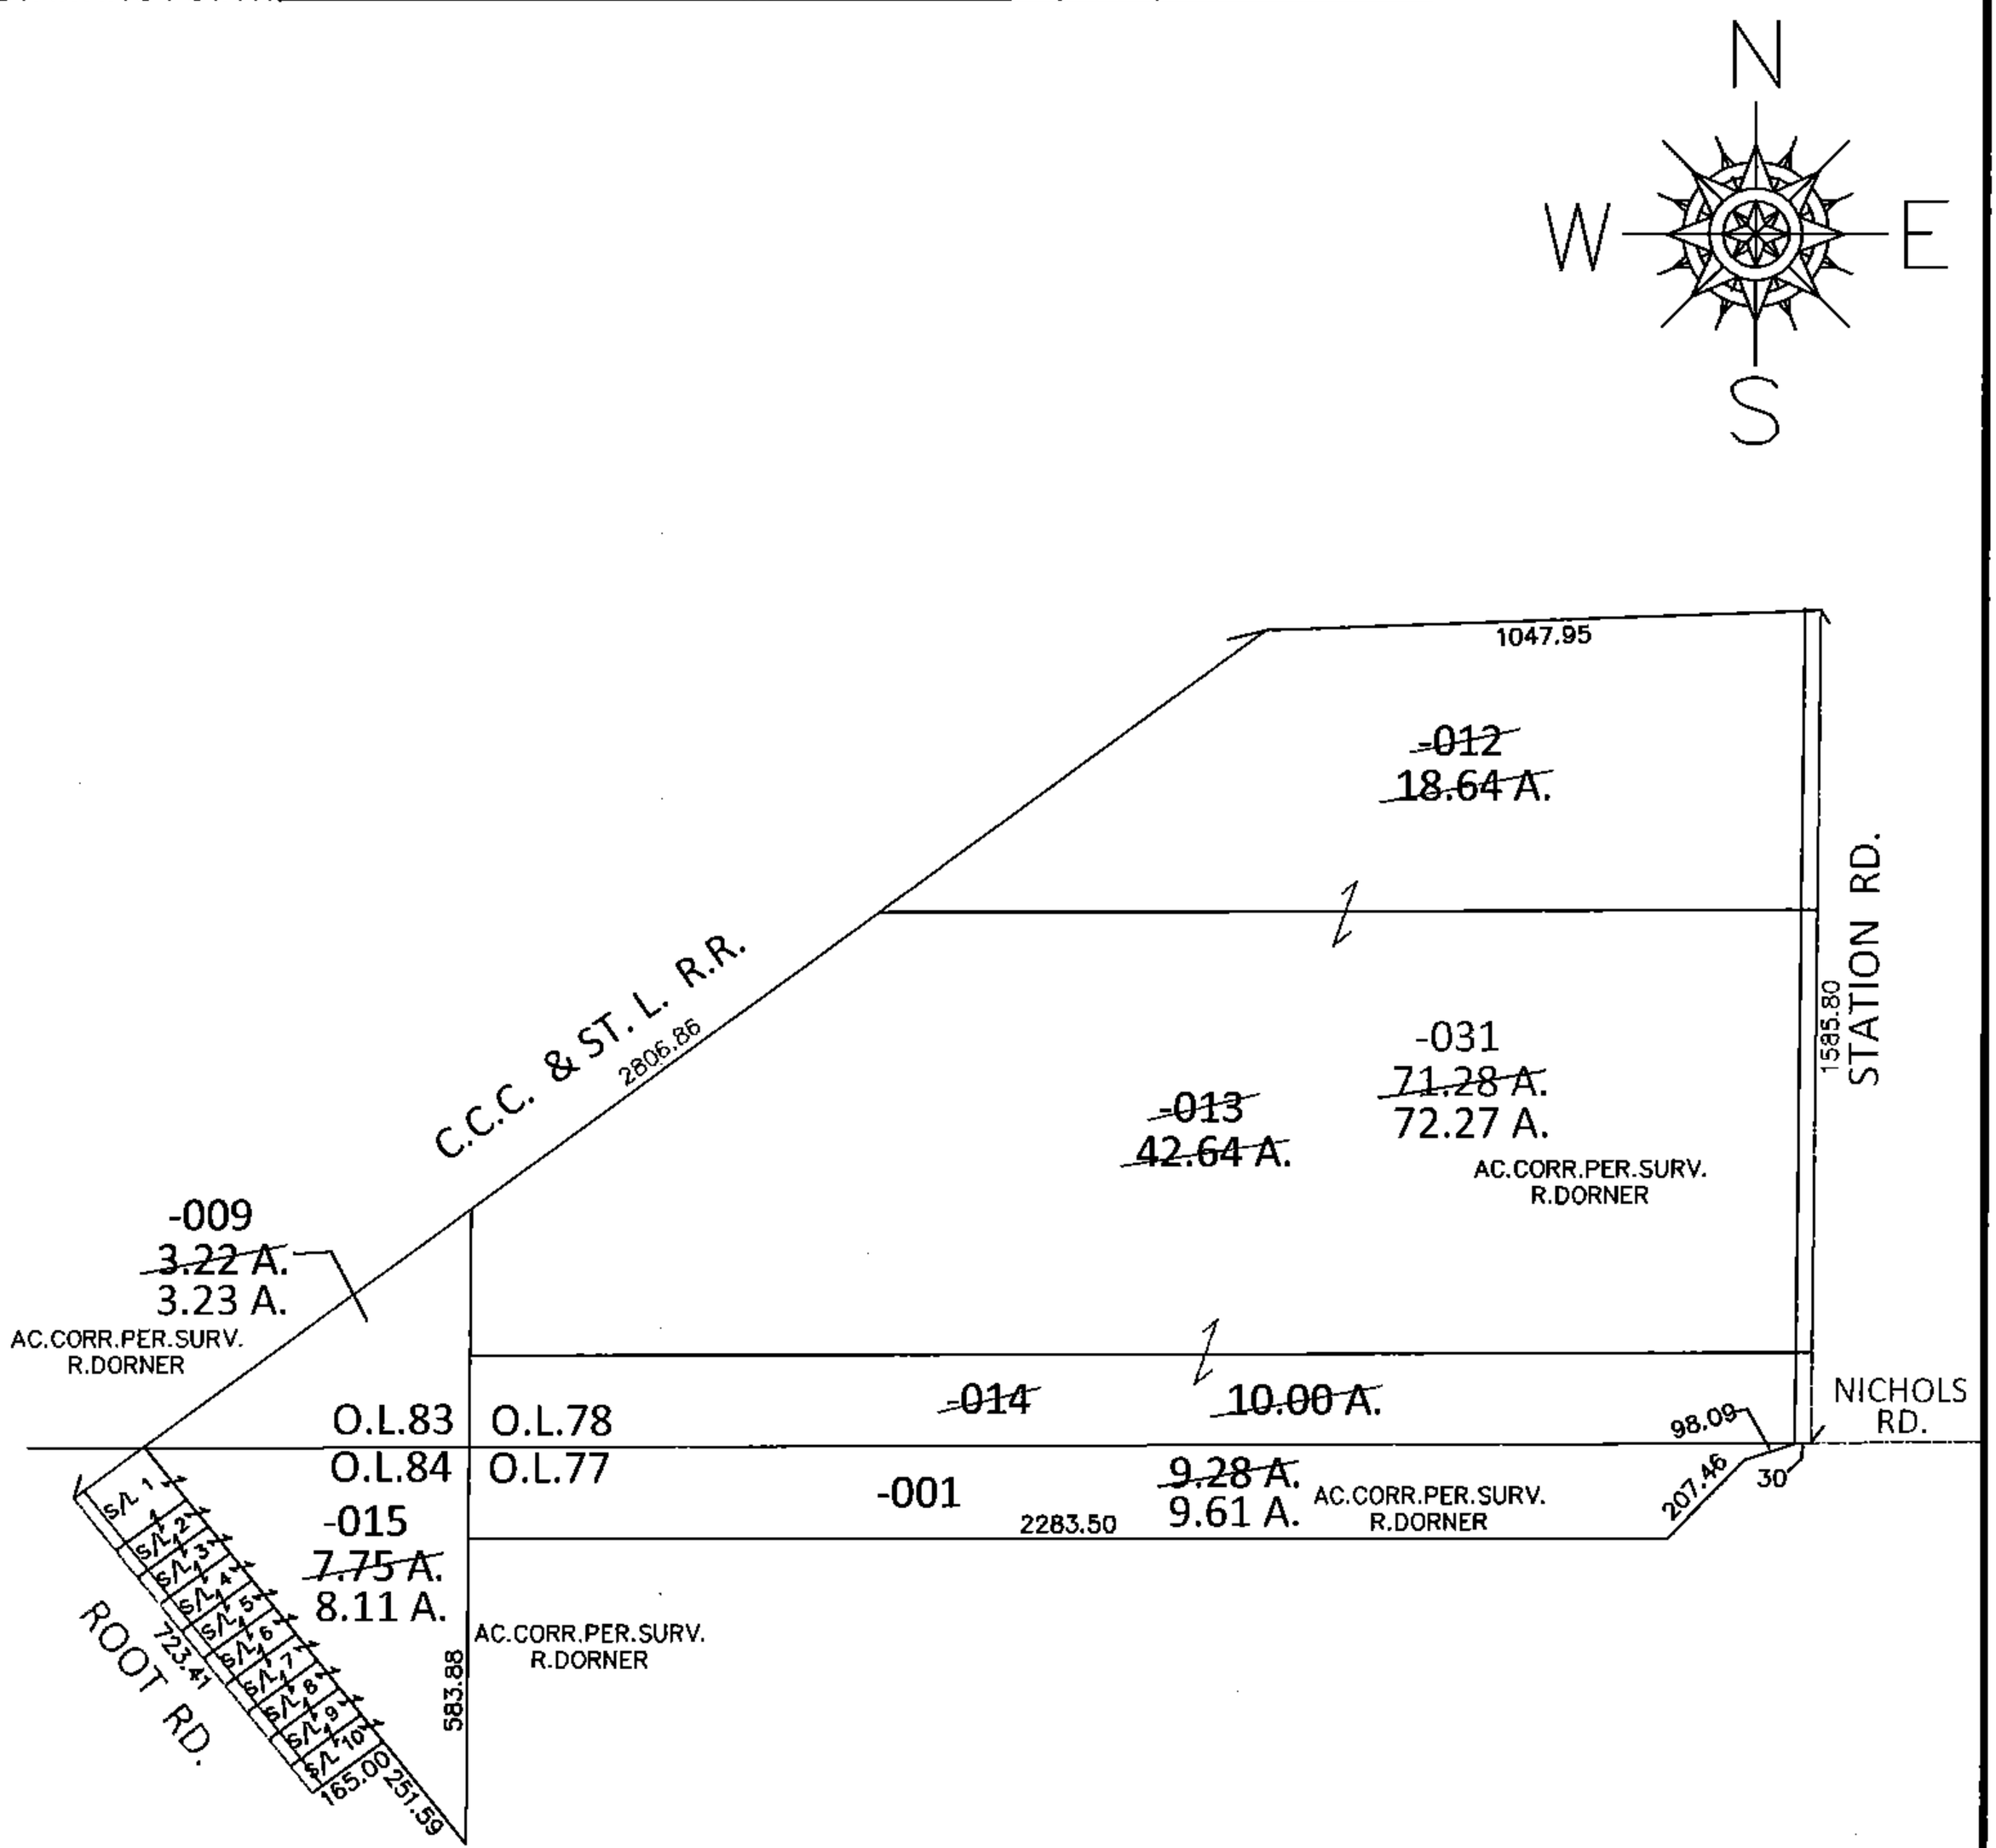

SPLITS/DEEDS PROCESSED

LORAIN COUNTY TAX MAP DEPARTMENT
226 MIDDLE AVE. ELYRIA, OHIO

SURVEYED BY: ROBERT A. DORNER
CLOSURE: .01:10,000
MAP PAGE(S): 12-00-078-A&B, 084-B, 12-A
APPROVED BY: RRM DATE: 11-6-14
SCALE: 1"= 500 PRIOR INST.: DV 996/543