PARENT PARCEL: 04-00-002-102-064,-024, -063

CHILD PARCEL: 04-00-002-102-242, -243

STARTING POINT: CENTERLINE OF DETROIT RD & LONG RD

# 14-03312

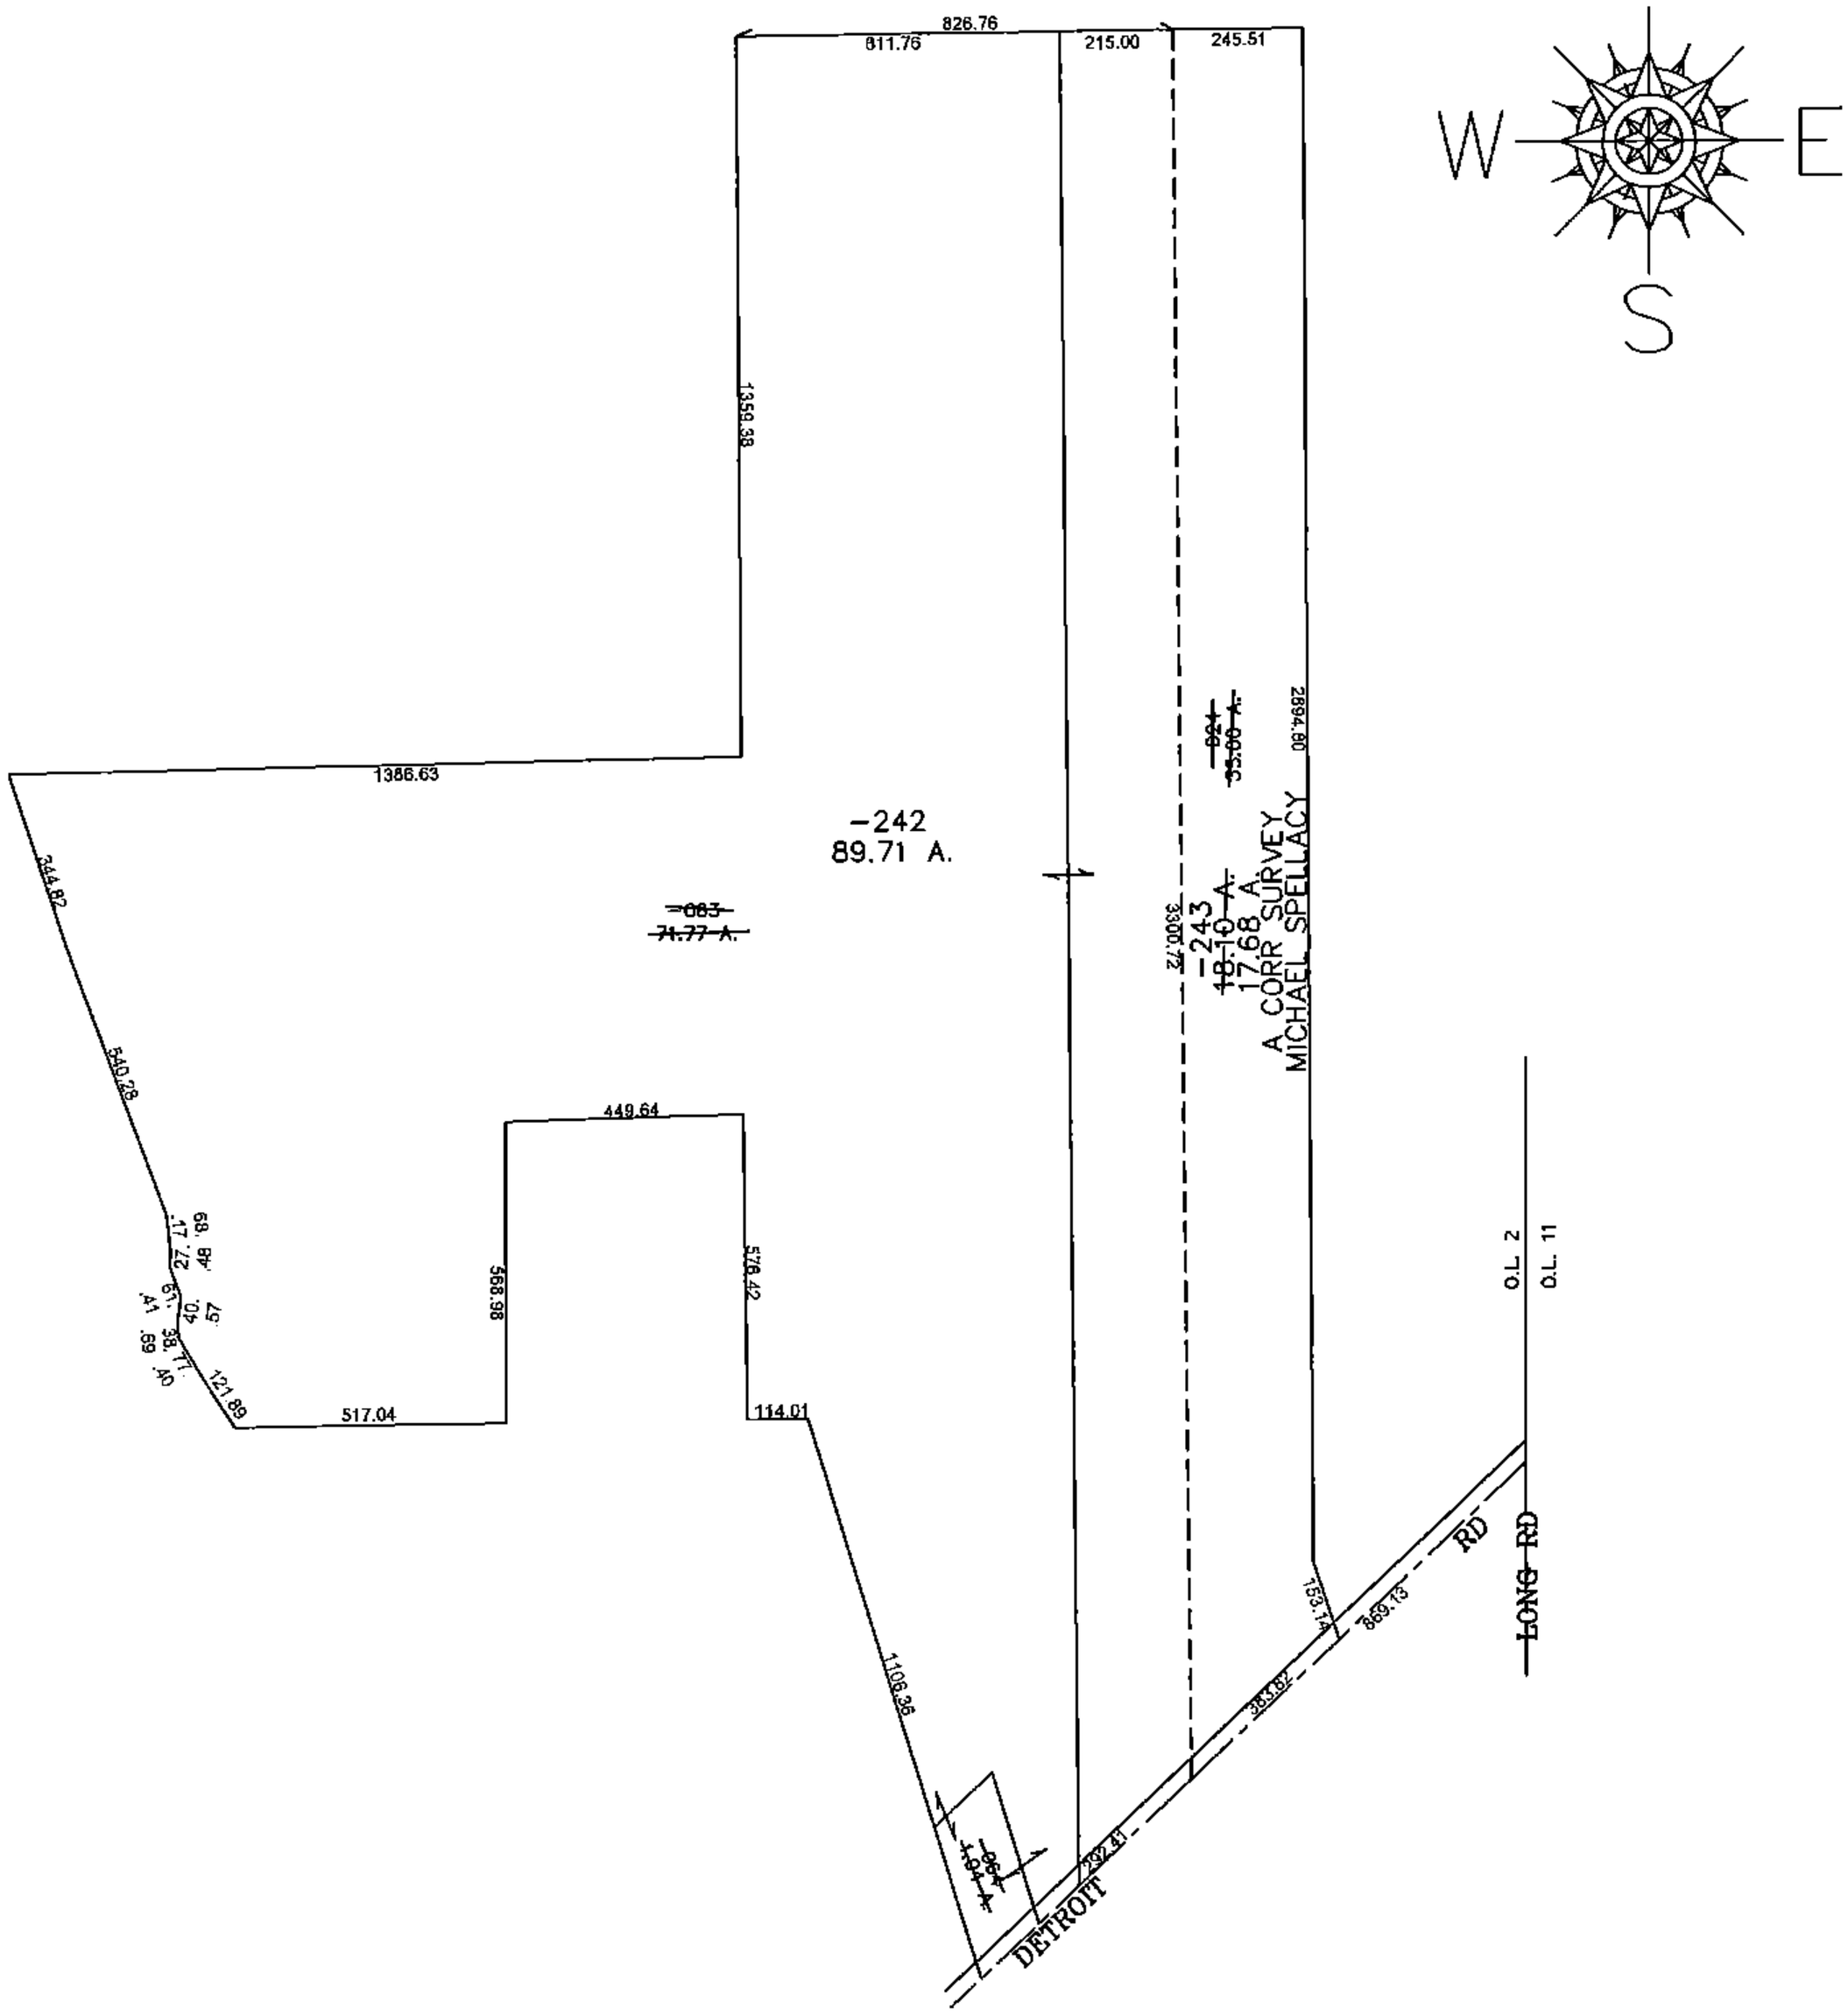


## SPLITS/DEEDS PROCESSED

LORAIN COUNTY TAX MAP DEPARTMENT
226 MIDDLE AVE. ELYRIA, OHIO

SURVEYED BY: MICHAEL SPELLACY

CLOSURE: 0.01 : 10,000

MAP PAGE(S): 04-00-002-H

APPROVED BY: JAH DATE: 11/17/2014

SCALE: 1"= 500 PRIOR INST.: 20050107180