PARENT PARCEL: 12-00-039-000-006
CHILD PARCEL: 12-00-039-630-001
STARTING POINT:

15-03313-A

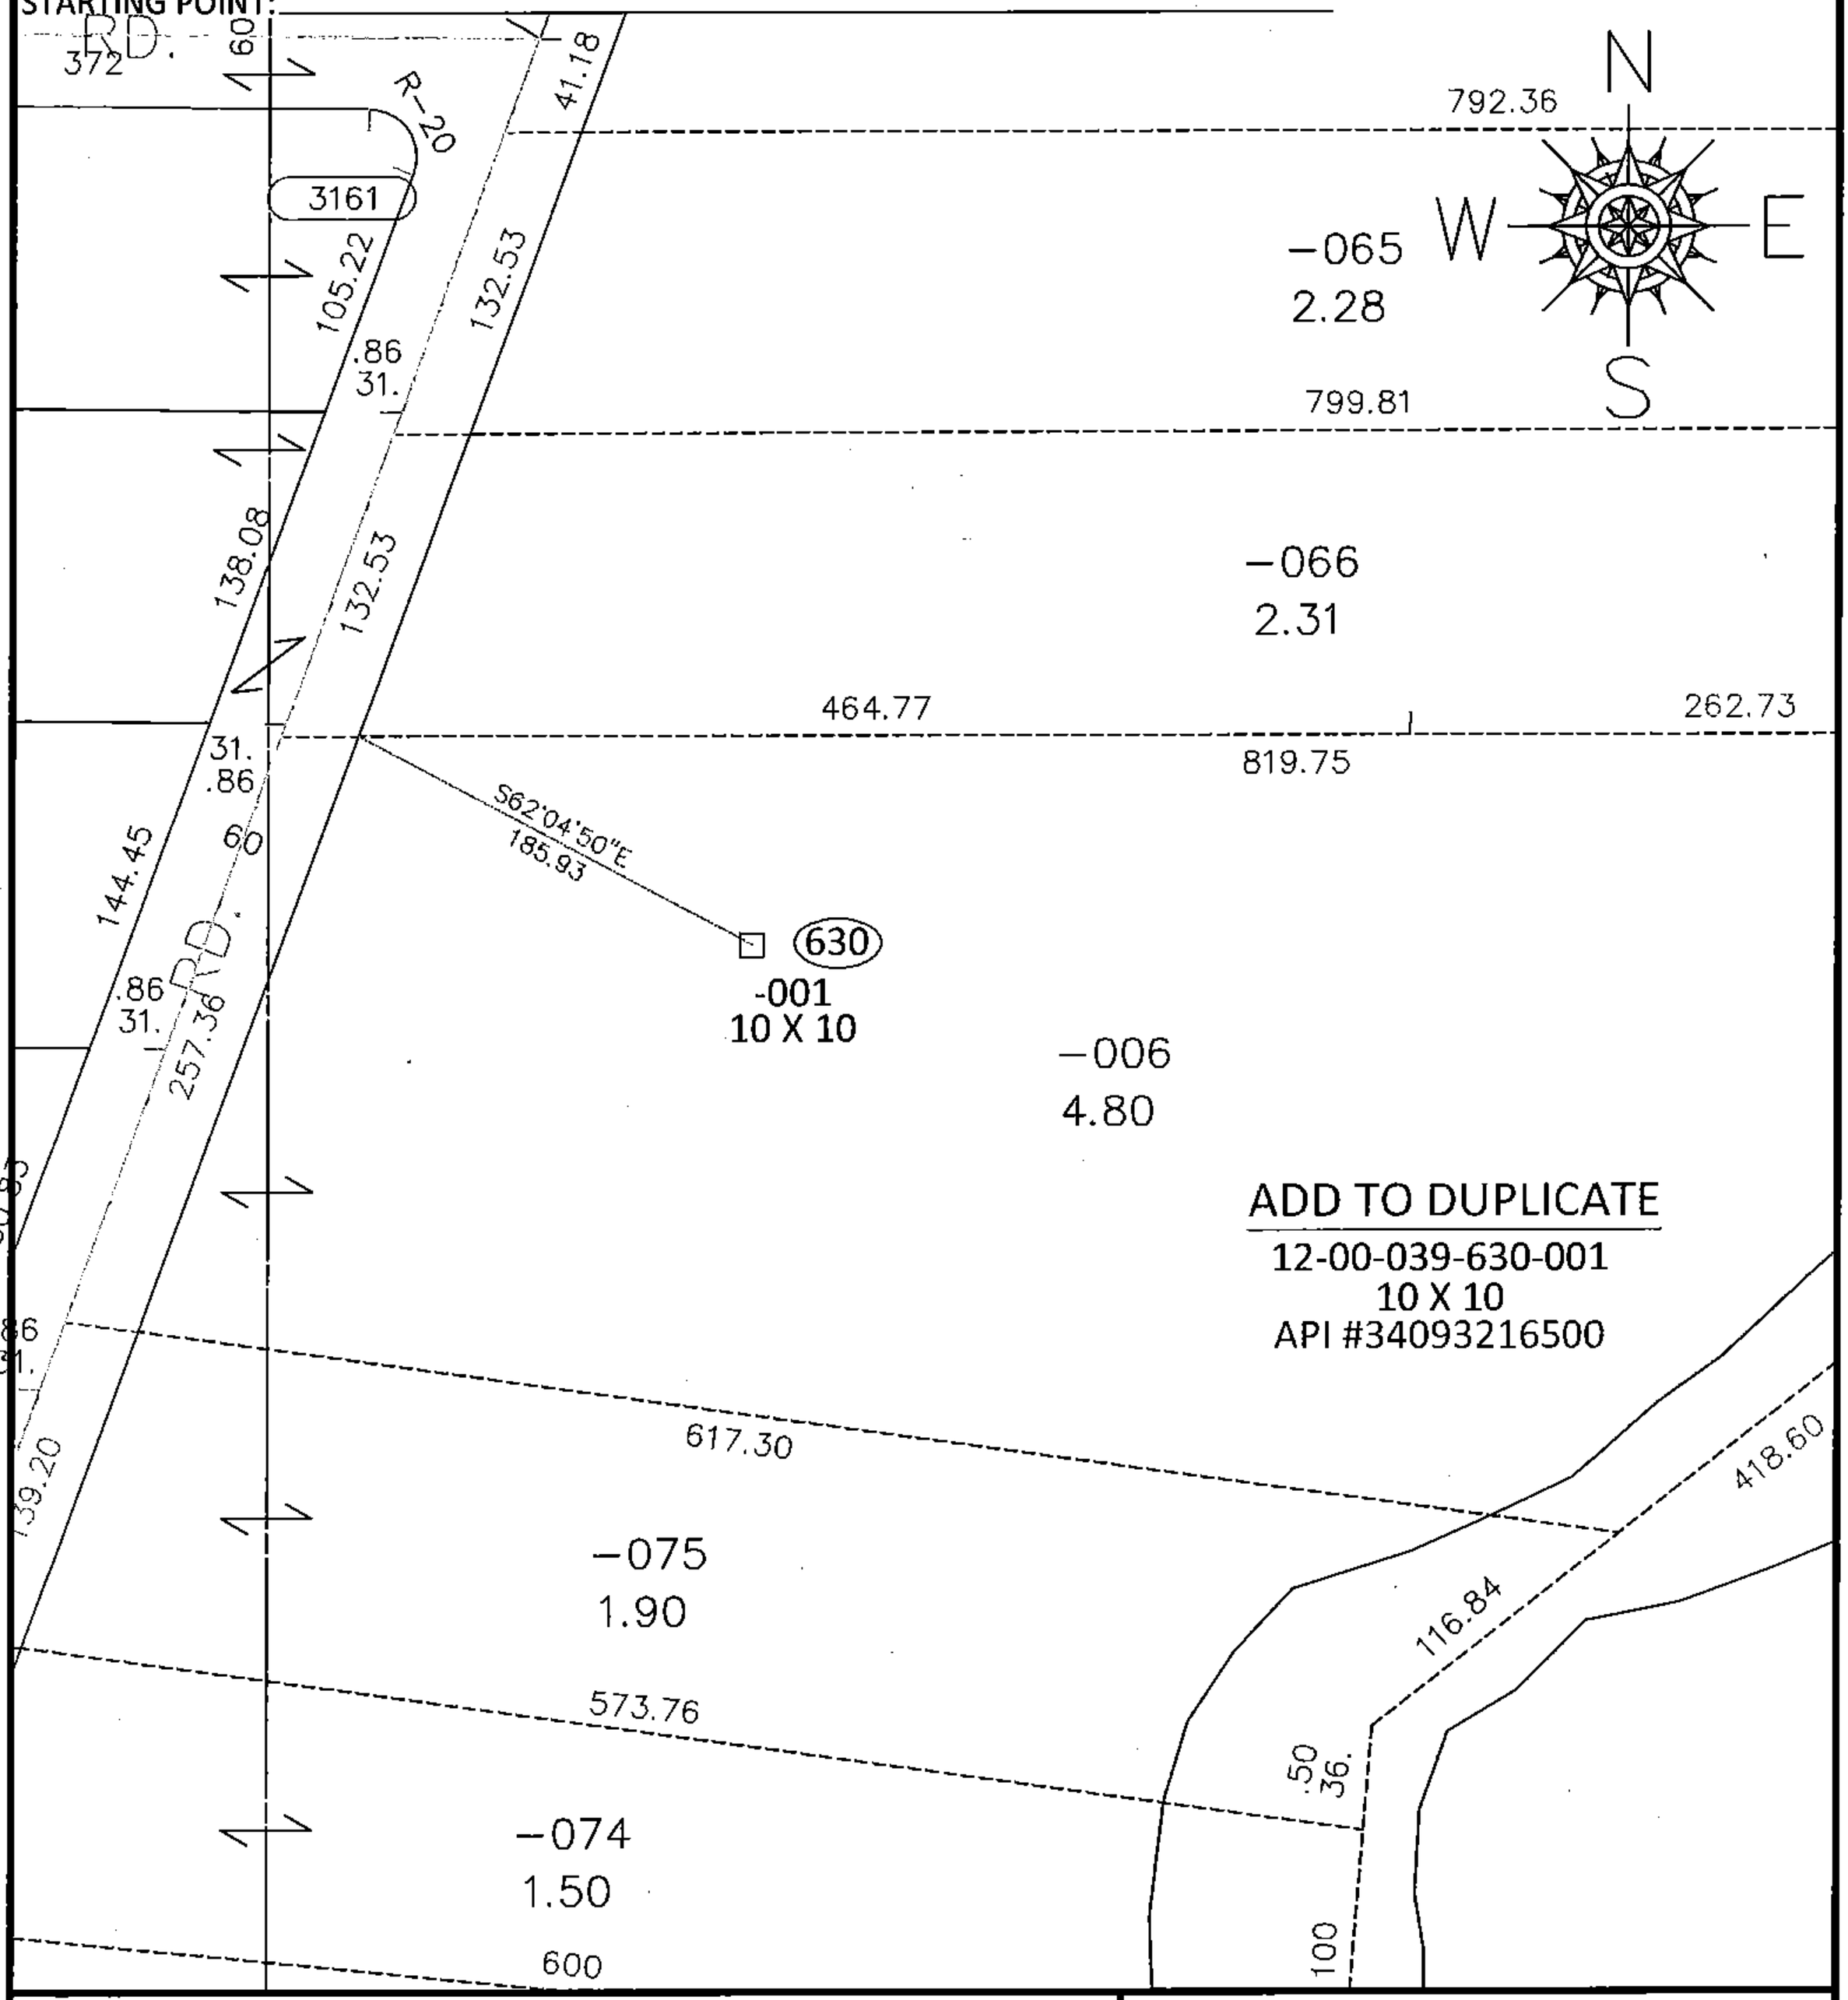

SPLITS/DEEDS PROCESSED

LORAIN COUNTY TAX MAP DEPARTMENT
226 MIDDLE AVE. ELYRIA, OHIO

SURVEYED BY: N/A
CLOSURE: N/A
MAP PAGE(S): 12-00-039-A
APPROVED BY: RRM DATE: 10-14-15
SCALE: 1"= 100 PRIOR INST.: