PARENT PARCEL: 10-00-024-000-071 064 013 098 103, 10-00-025-101-050

CHILD PARCEL: SAME

STARTING POINT: CENTERLLINE OF PARSONS RD & O.L. 24

14-03325

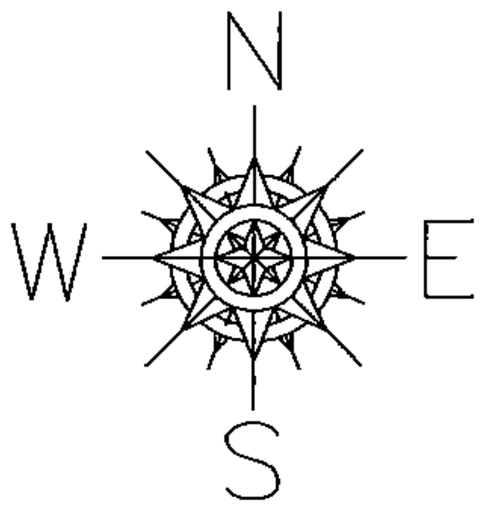

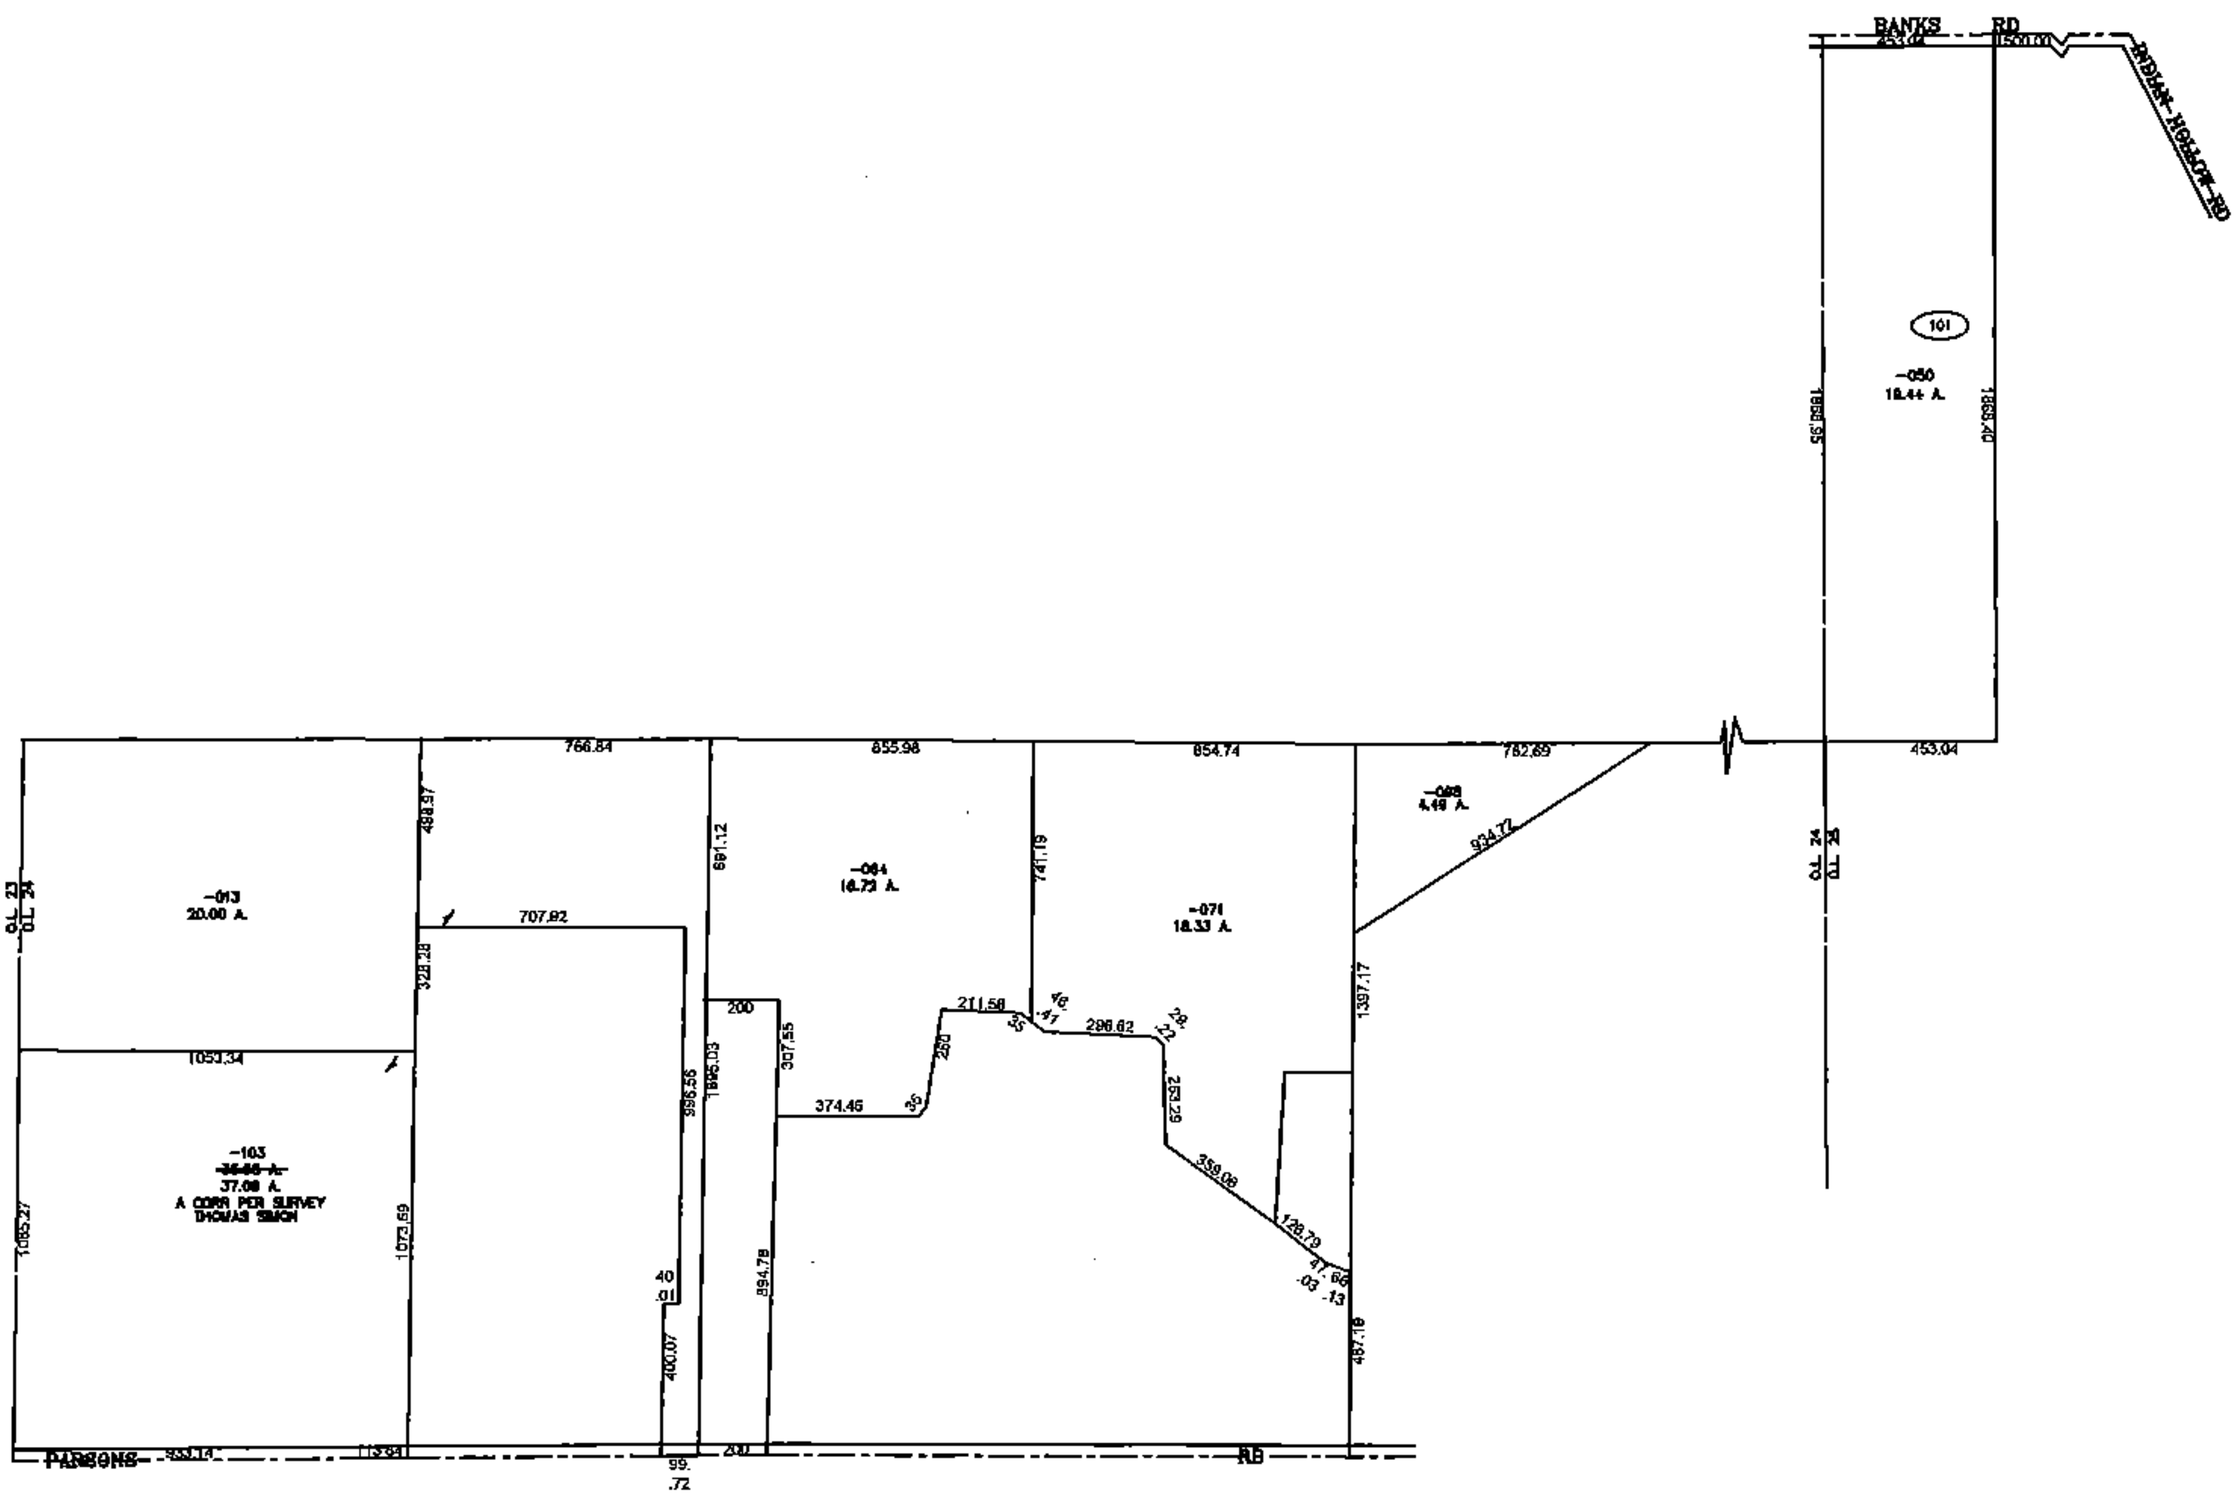

SPLITS/DEEDS PROCESSED

LORAIN COUNTY TAX MAP DEPARTMENT
226 MIDDLE AVE. ELYRIA, OHIO

SURVEYED BY: THOMAS SIMON

CLOSURE: 0.00 : 10,000

MAP PAGE(S): 10-00-024-E

APPROVED BY: JAH DATE: 12/17/2014

SCALE: 1"= 800 PRIOR INSTRUMENT: DV 1251/699