PARENT PARCEL: 06-24-173-000-004, -020, 06-24-172-000-030, -031

CHILD PARCEL: 06-24-173-000-021, 06-24-172-000-036

STARTING POINT: INTERSECTION OF THE EAST LINE OF WEST RIVER RD. AND SOUTH LINE OF O.L.173

15-03329-C

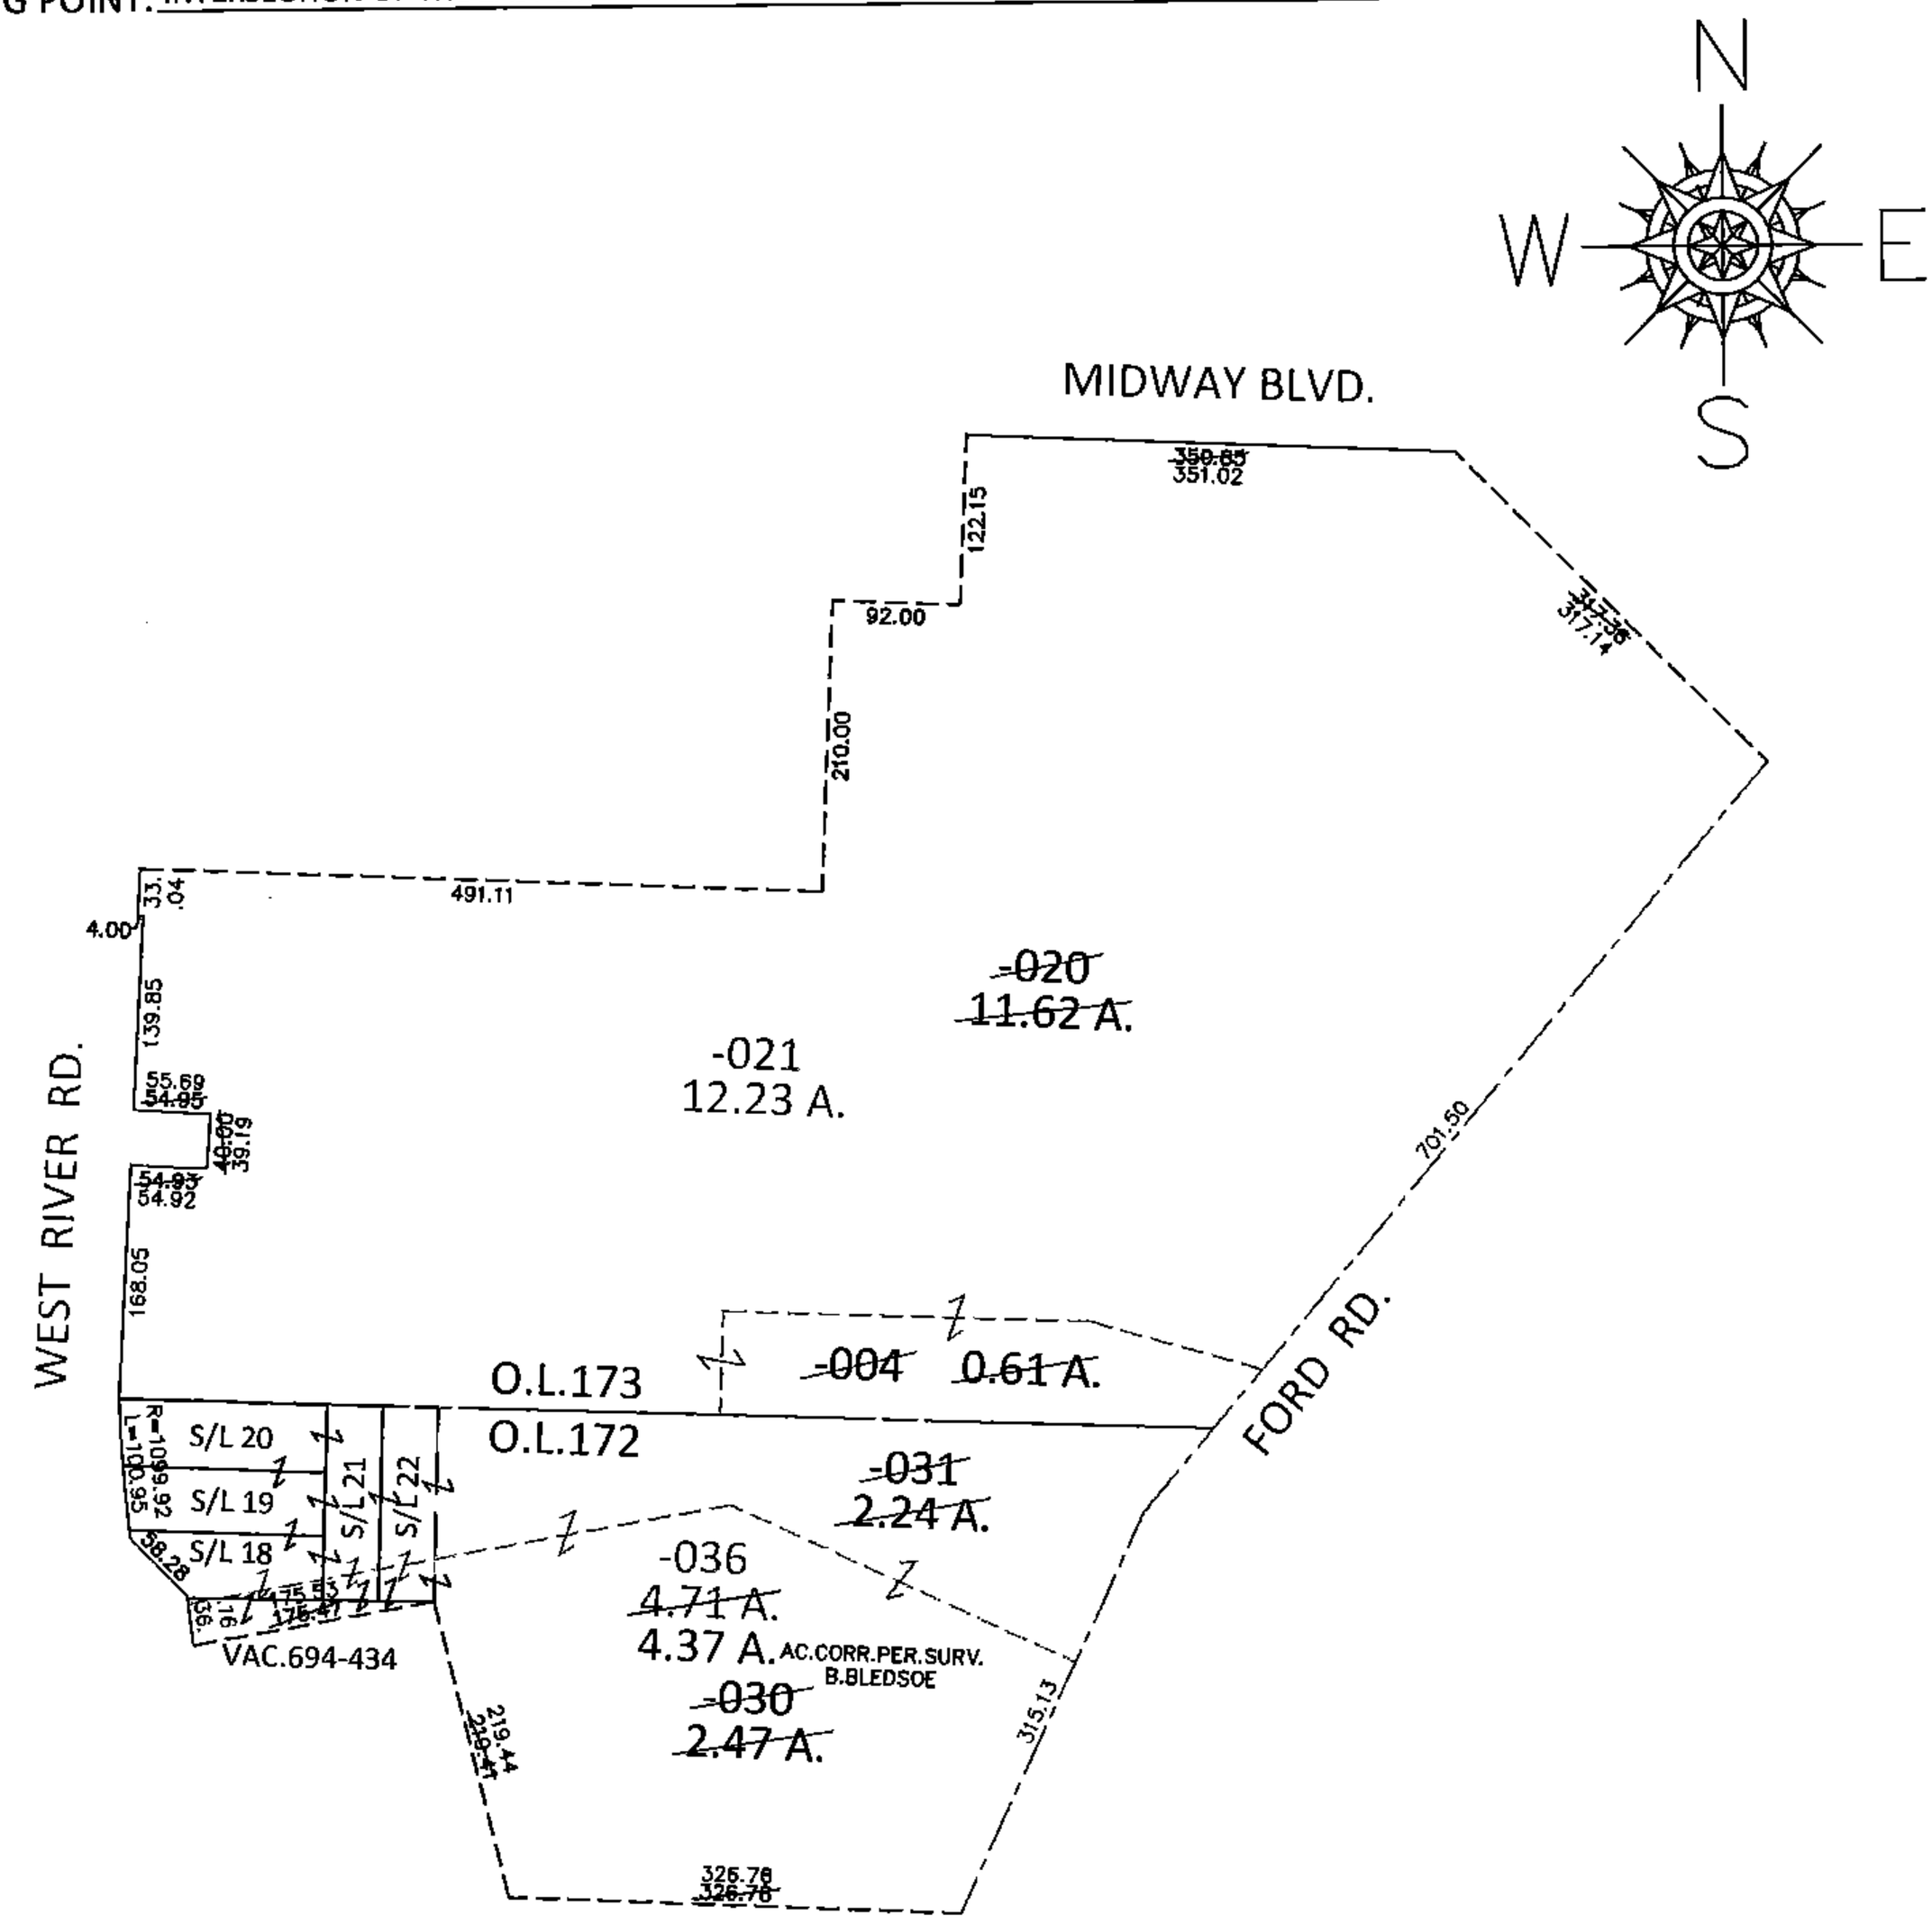

SPLITS/DEEDS PROCESSED

LORAIN COUNTY TAX MAP DEPARTMENT
226 MIDDLE AVE. ELYRIA, OHIO

SURVEYED BY: BEN BLEDSOE
CLOSURE: .01:10,000
MAP PAGE(S): 6-48
APPROVED BY: RRM DATE: 11-4-15
SCALE: 1"= 200 PRIOR INST.: 20140995410