PARENT PARCEL: 07-00-003-102-089

CHILD PARCEL: 07-00-003-102-091, -092

STARTING POINT: CENTERLINE OF BUTTERNUT RIDGE RD & VICTORY LN

15-03359

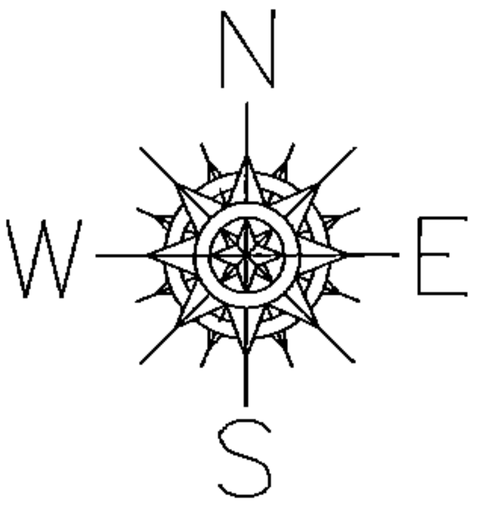

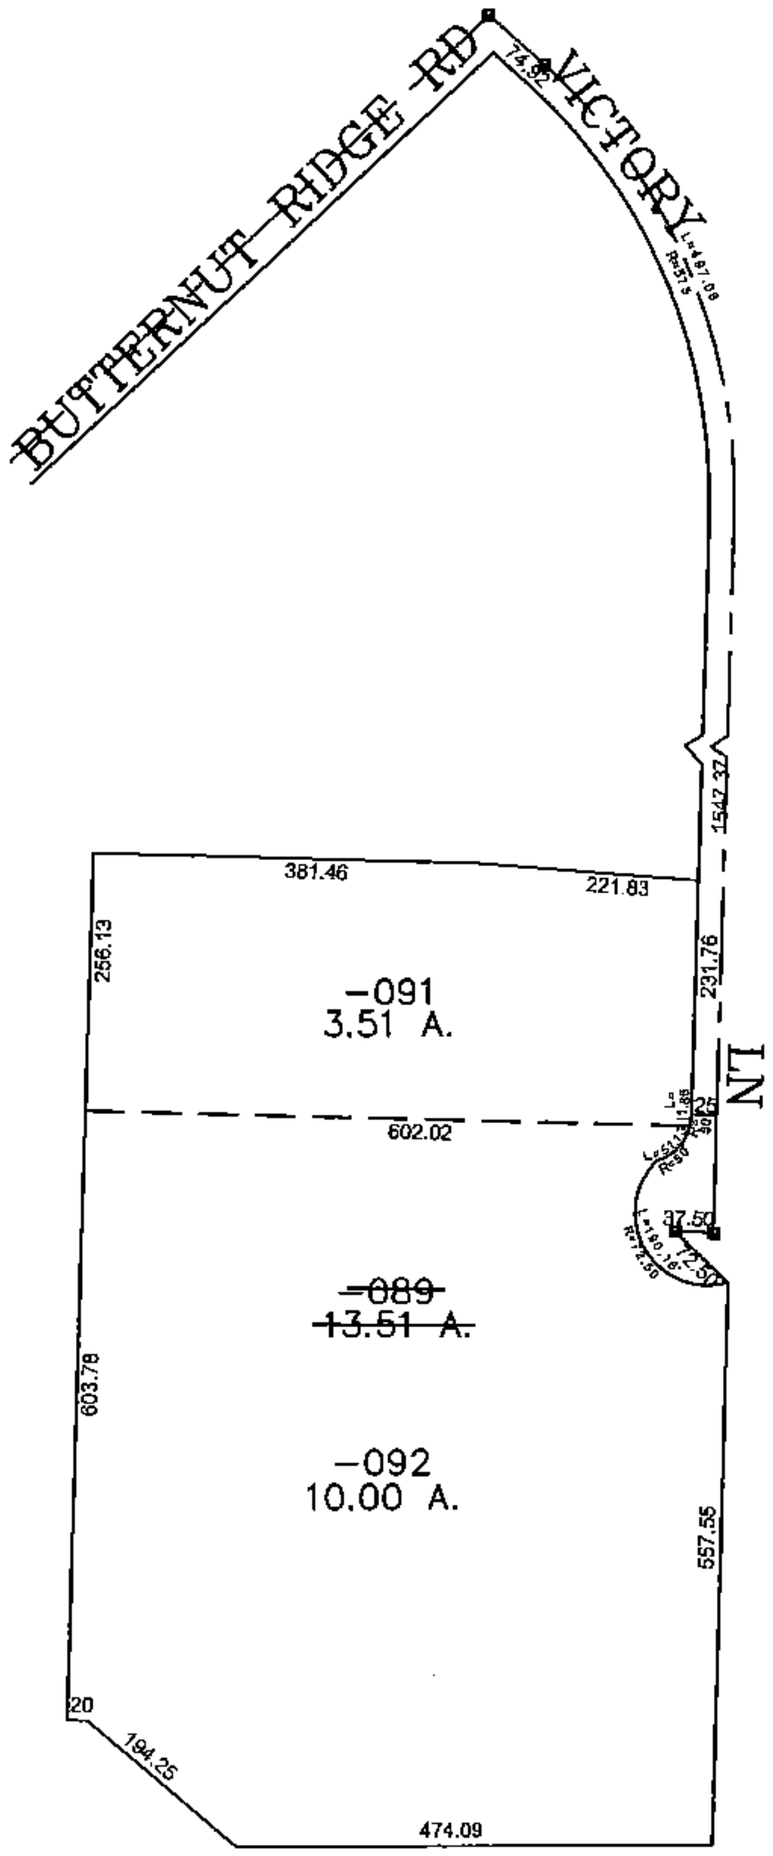

SPLITS/DEEDS PROCESSED

LORAIN COUNTY TAX MAP DEPARTMENT
226 MIDDLE AVE. ELYRIA, OHIO

SURVEYED BY: HOWARD SELEE

CLOSURE: 0.00 : 10,000

MAP PAGE(S): 07-00-003

APPROVED BY: JAH DATE: 3/31/2015

SCALE: 1"= 300 PRIOR INSTRUMENT: 20090318734