PARENT PARCEL: 12-00-074-000-041, -024, -026

CHILD PARCEL: 12-00-074-000-042 THRU -047

STARTING POINT: CENTERLINE OF STATION RD & CAPEL RD

15-03364

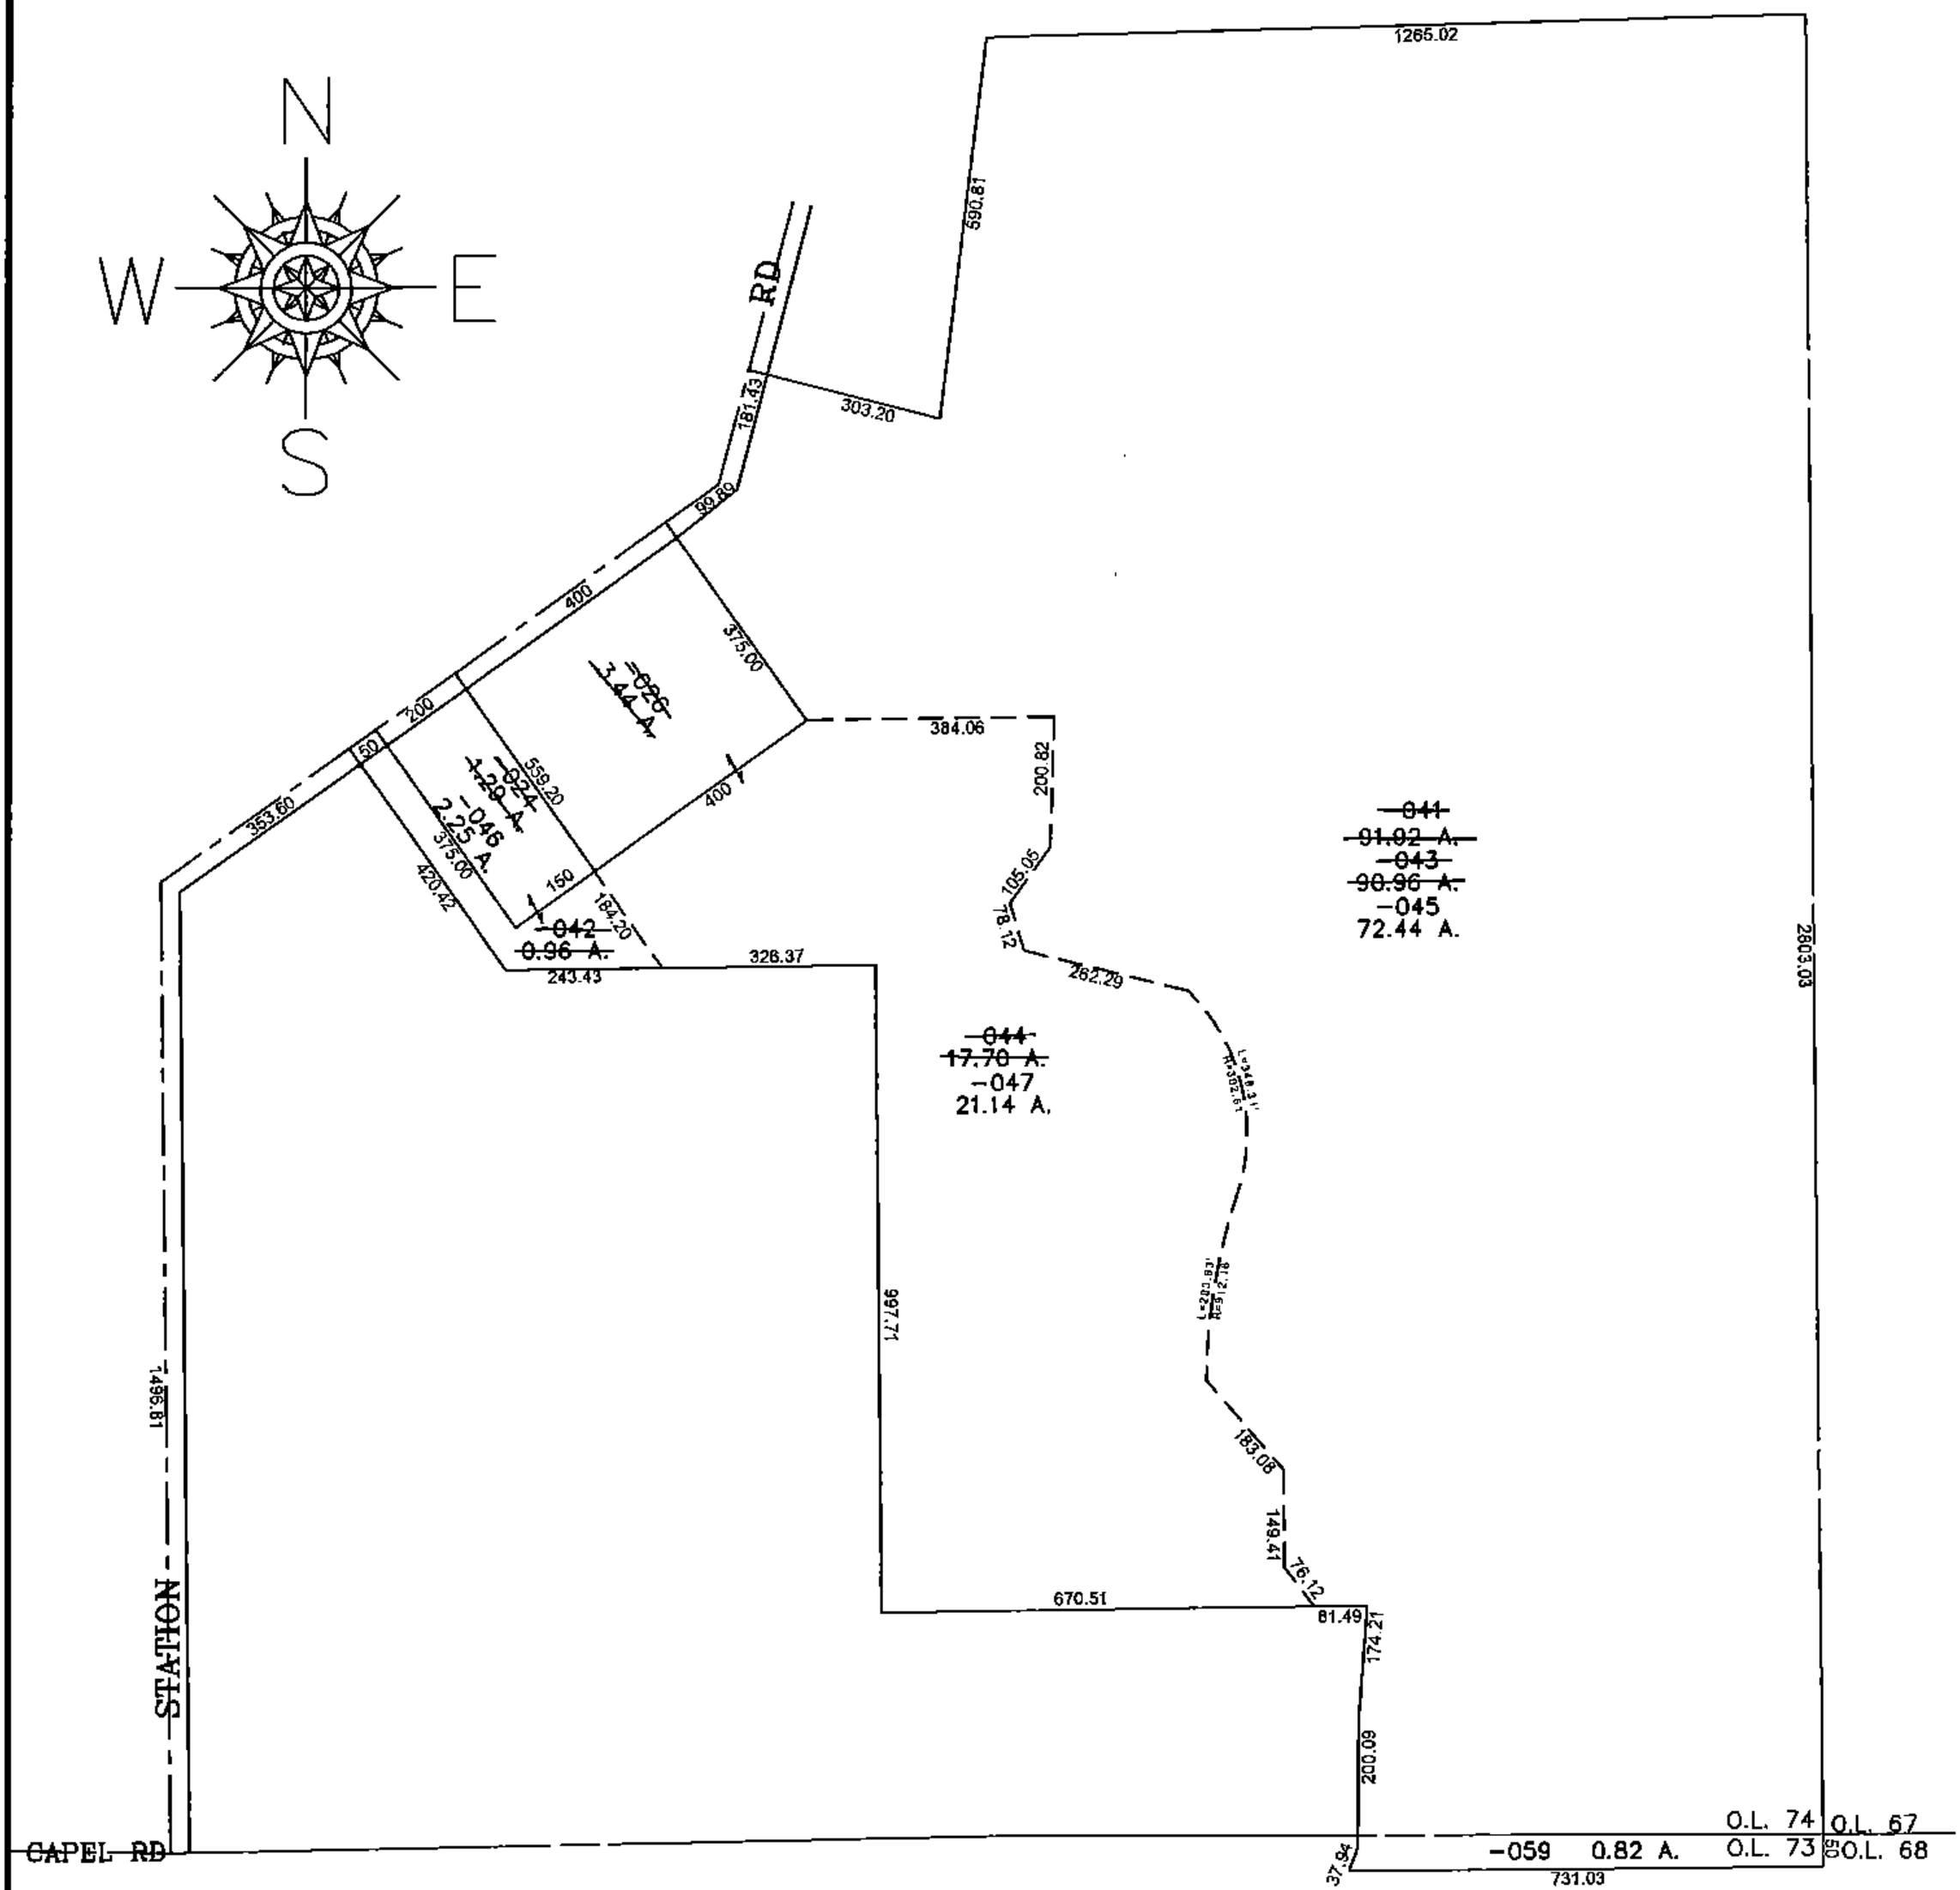

SPLITS/DEEDS PROCESSED

LORAIN COUNTY TAX MAP DEPARTMENT

226 MIDDLE AVE. ELYRIA, OHIO

SURVEYED BY: THOMAS NEFF JR

CLOSURE: 0.00 : 10,000

MAP PAGE(S): 12-00-074-A

APPROVED BY: JAH DATE: 4/24/2015

SCALE: 1"= 400 PRIOR INST.: 20130465574