PARENT PARCEL: 04-00-010-115-003
CHILD PARCEL: XX-XX-XXX-XXX-XXX
STARTING POINT: INTERSECTION OF C/L OF COLORADO AVE. AND C/L OF NORTH RIDGE RD.

16-03369-A

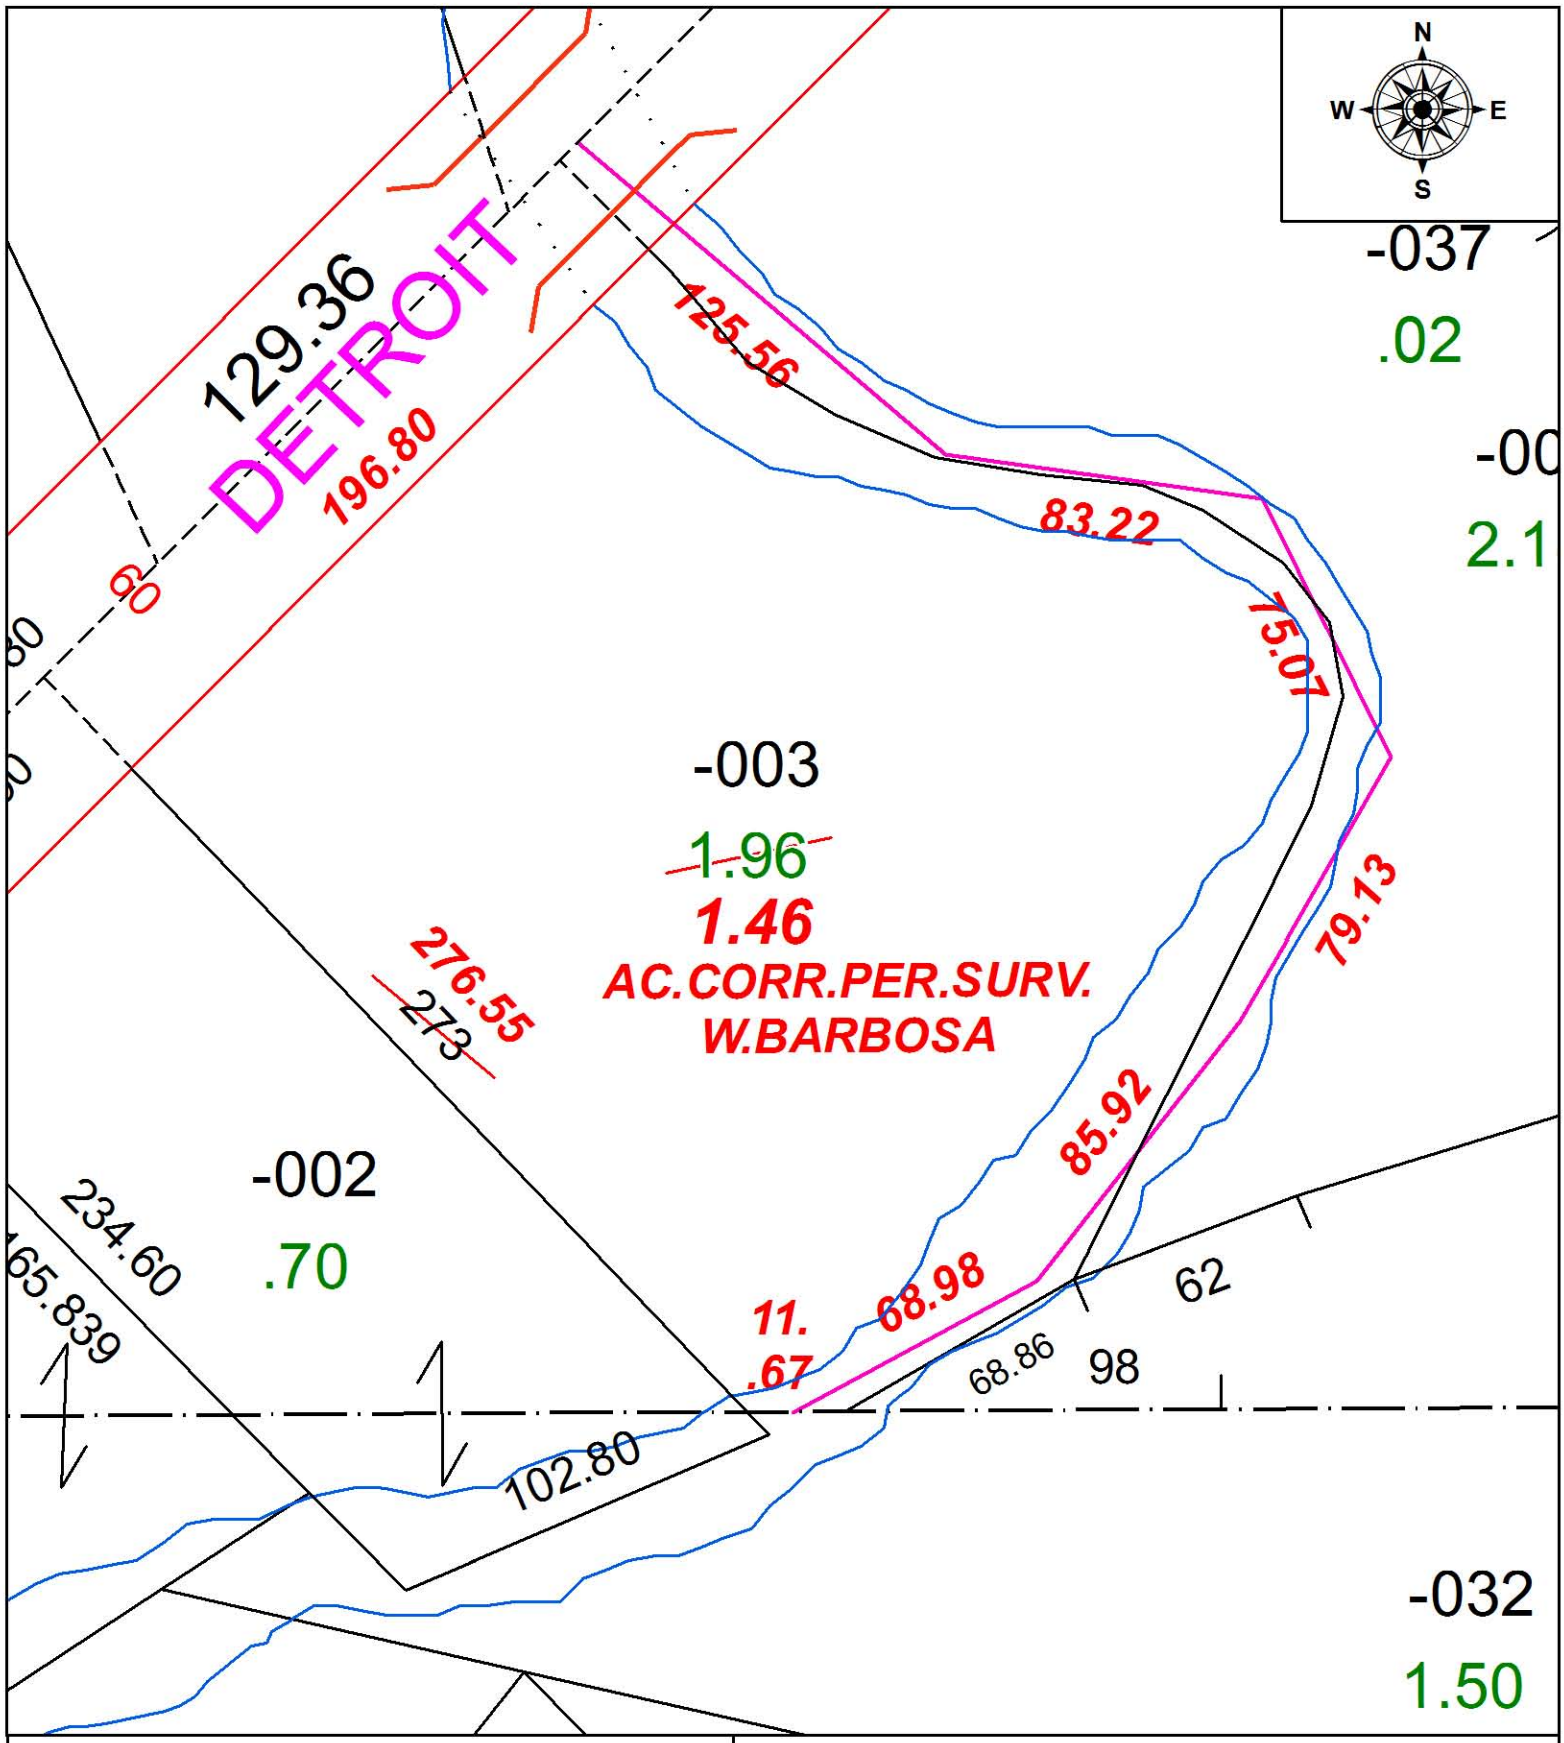

SPLITS/DEEDS PROCESSED
LORAIN COUNTY TAX MAP DEPARTMENT
226 MIDDLE AVE. ELYRIA, OH

SURVEYED BY: WILFREDO BARBOSA
CLOSURE: 1: 161,000
MAP PAGE(S): 4-00-010-G
APPOVED BY: RRM **DATE:** 1/28/16
SCALE: 1" = 50 **PRIOR INSTRUMENT:** 20120431333