PARENT PARCEL: 04-00-016-102-044
CHILD PARCEL: 04-00-016-102-086 THRU -090
STARTING POINT: CENTERLINE OF CHESTER RD & CENTER RD

15-03371

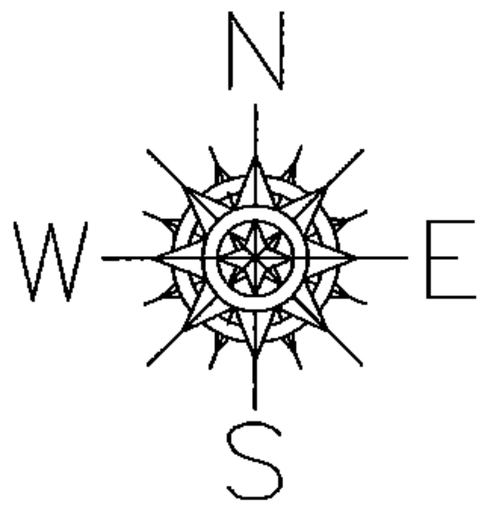

VOID

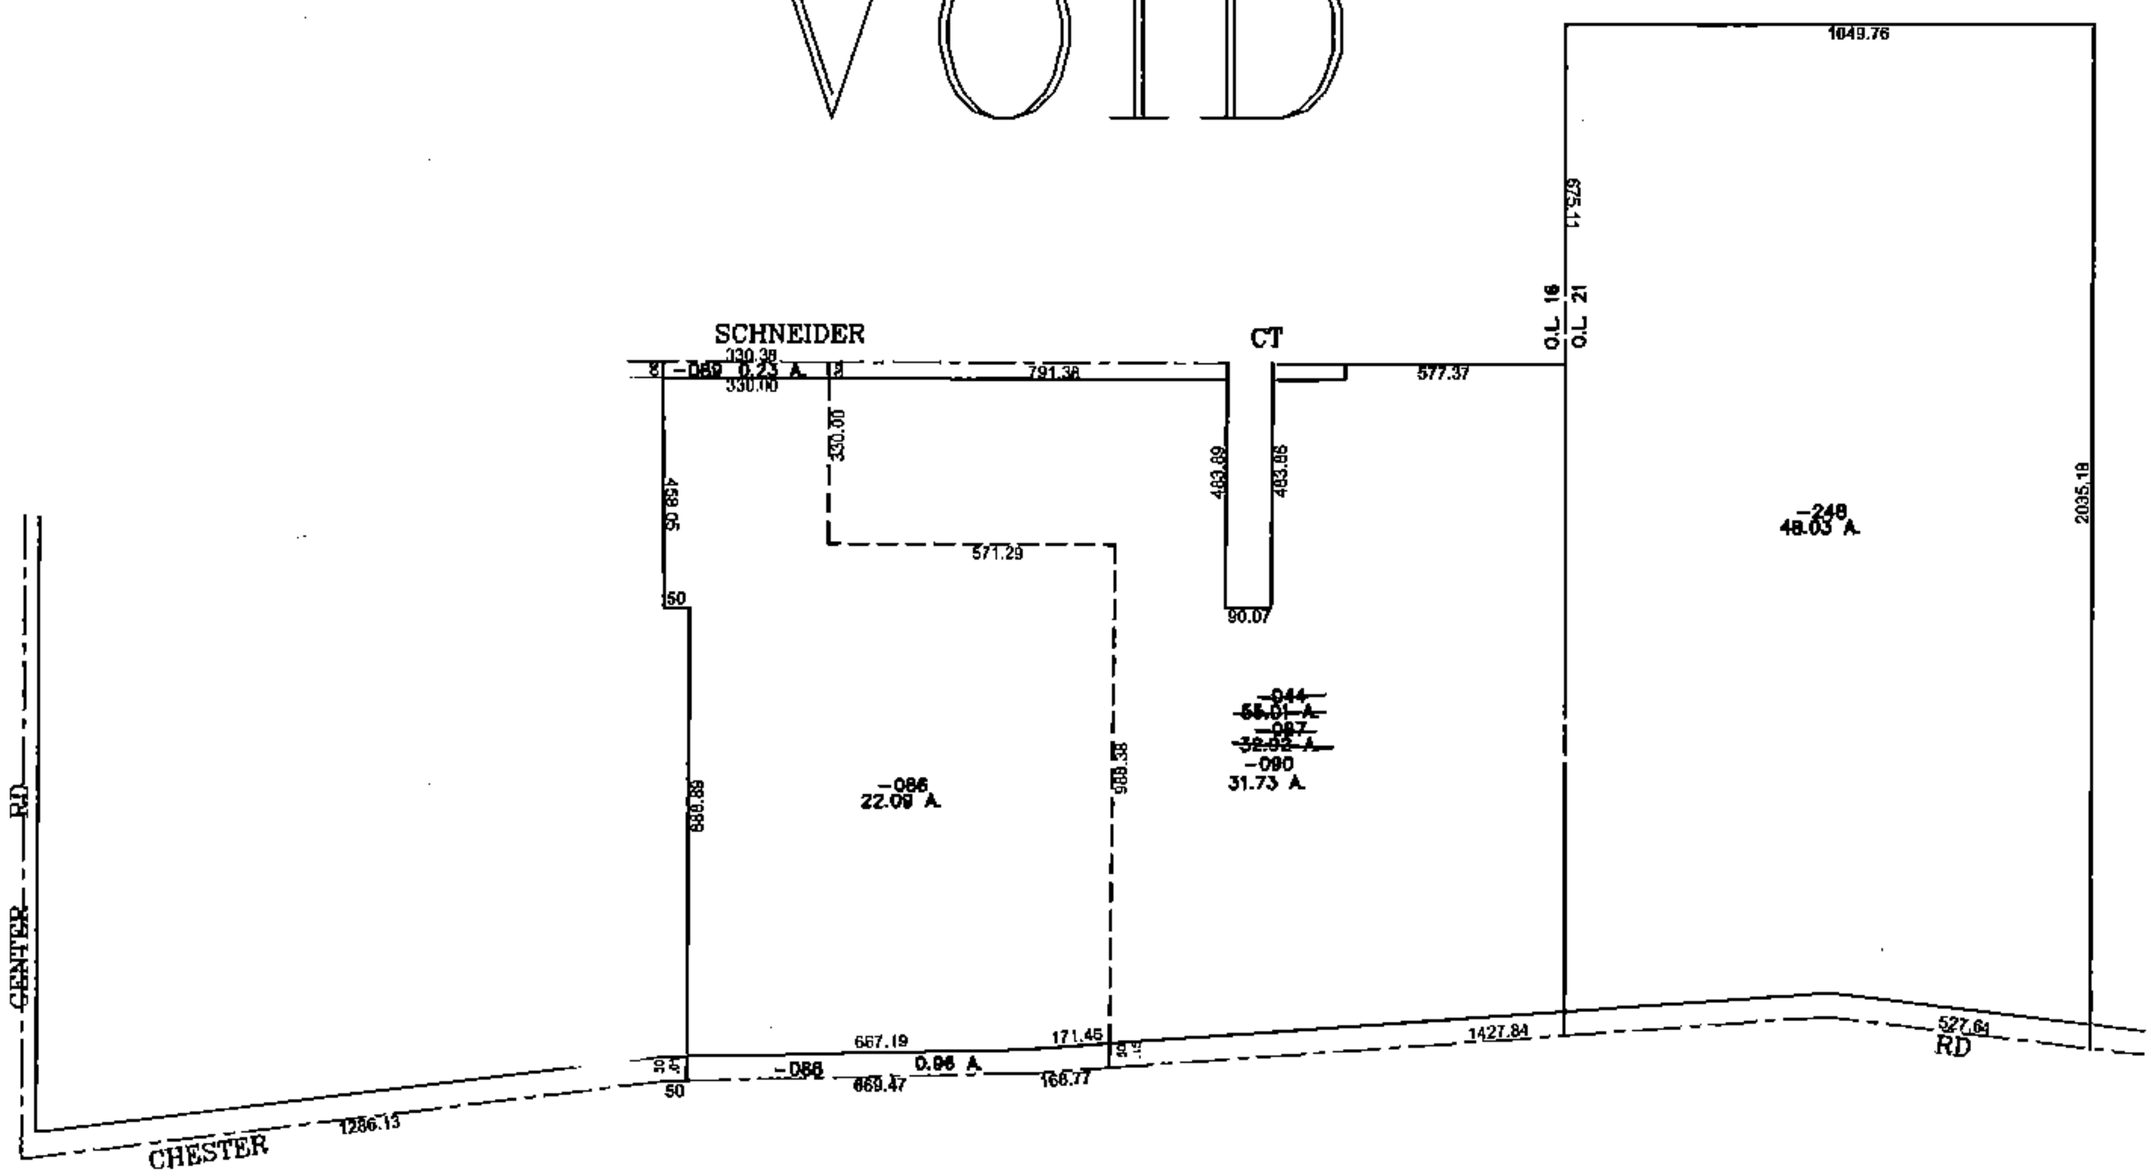

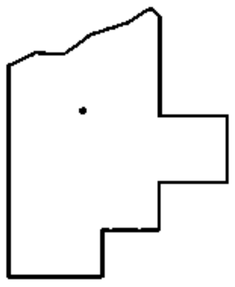

SPLITS/DEEDS PROCESSED

LORAIN COUNTY TAX MAP DEPARTMENT
226 MIDDLE AVE. ELYRIA, OHIO

SURVEYED BY: AMY KELLY
CLOSURE: 0.00 : 10,000
MAP PAGE(S): 04-00-016-H
APPROVED BY: JAH DATE: 5/22/2015
SCALE: 1"= 600 PRIOR INSTRUMENT: 20080263879