PARENT PARCEL: 09-00-076-103-040
CHILD PARCEL: XX-XX-XXX-XXX-XXX
STARTING POINT: P.K. NAIL SET, CL OF EAST LORAIN ST. & S.E. CORNER OF LOT NO. 118 ORIGINAL OBERLIN VILLAGE PLAT VO. 1 PG. 20

16-03376-C

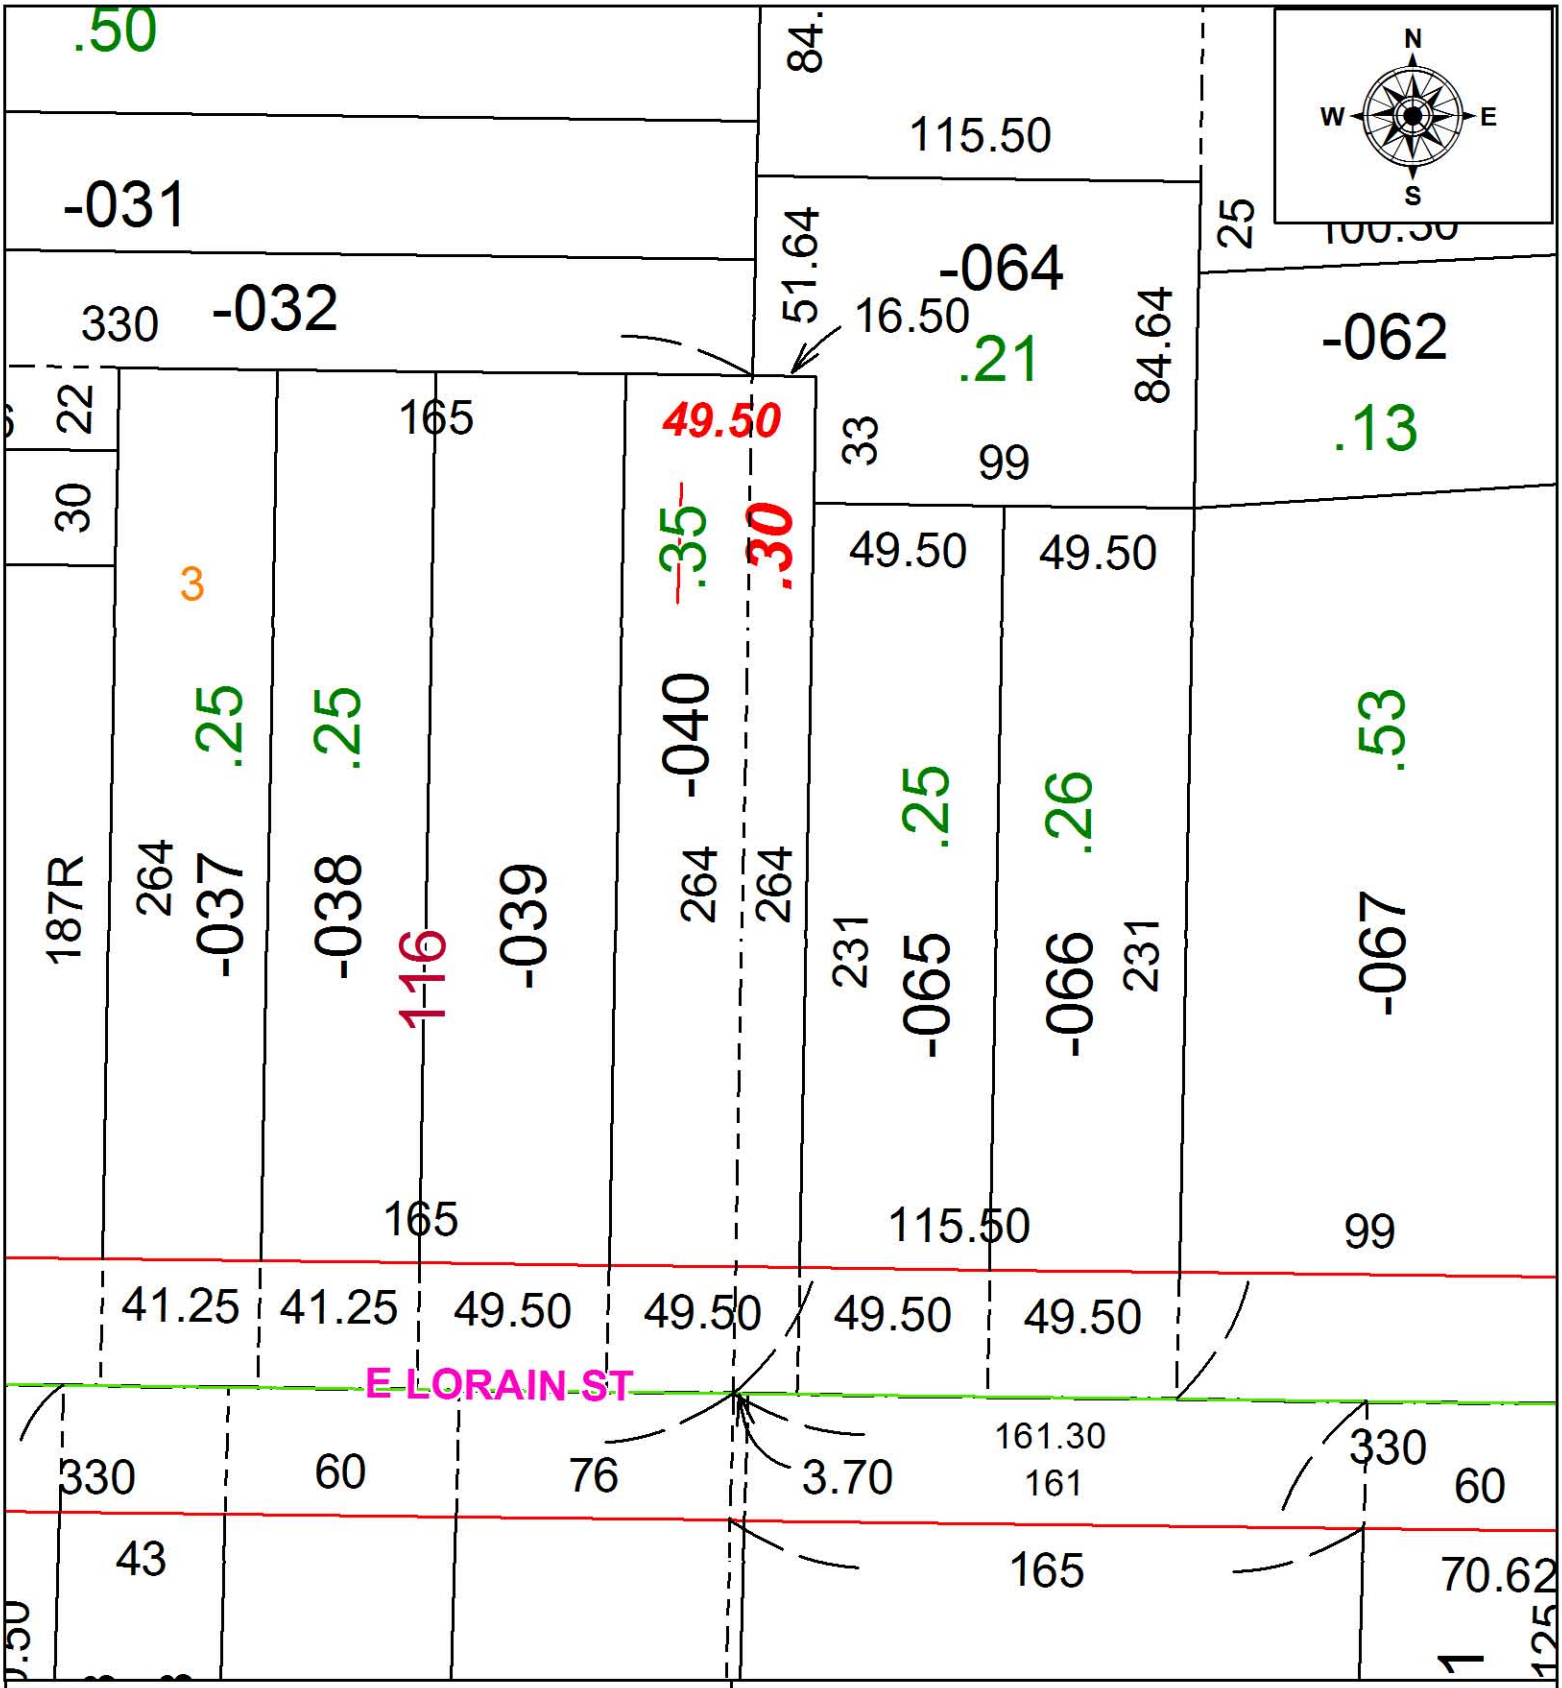

SPLITS/DEEDS PROCESSED
LORAIN COUNTY TAX MAP DEPARTMENT
226 MIDDLE AVE. ELYRIA, OH

SURVEYED BY: PETER JOHN GAURILOFF
CLOSURE: 1:2147483648
MAP PAGE(S): 09-00-076
APPOVED BY: TJS **DATE:** 2/2/16
SCALE: 1 in = 50 ft **PRIOR INSTRUMENT:** OR 286/737