PARENT PARCEL: 15-00-046-104-023
CHILD PARCEL: XX-XX-XXX-XXX-XXX
STARTING POINT: INTERSECTION OF C/L OF S.R.301 AND C/L OF LIBERTY ST.

16-03389-C

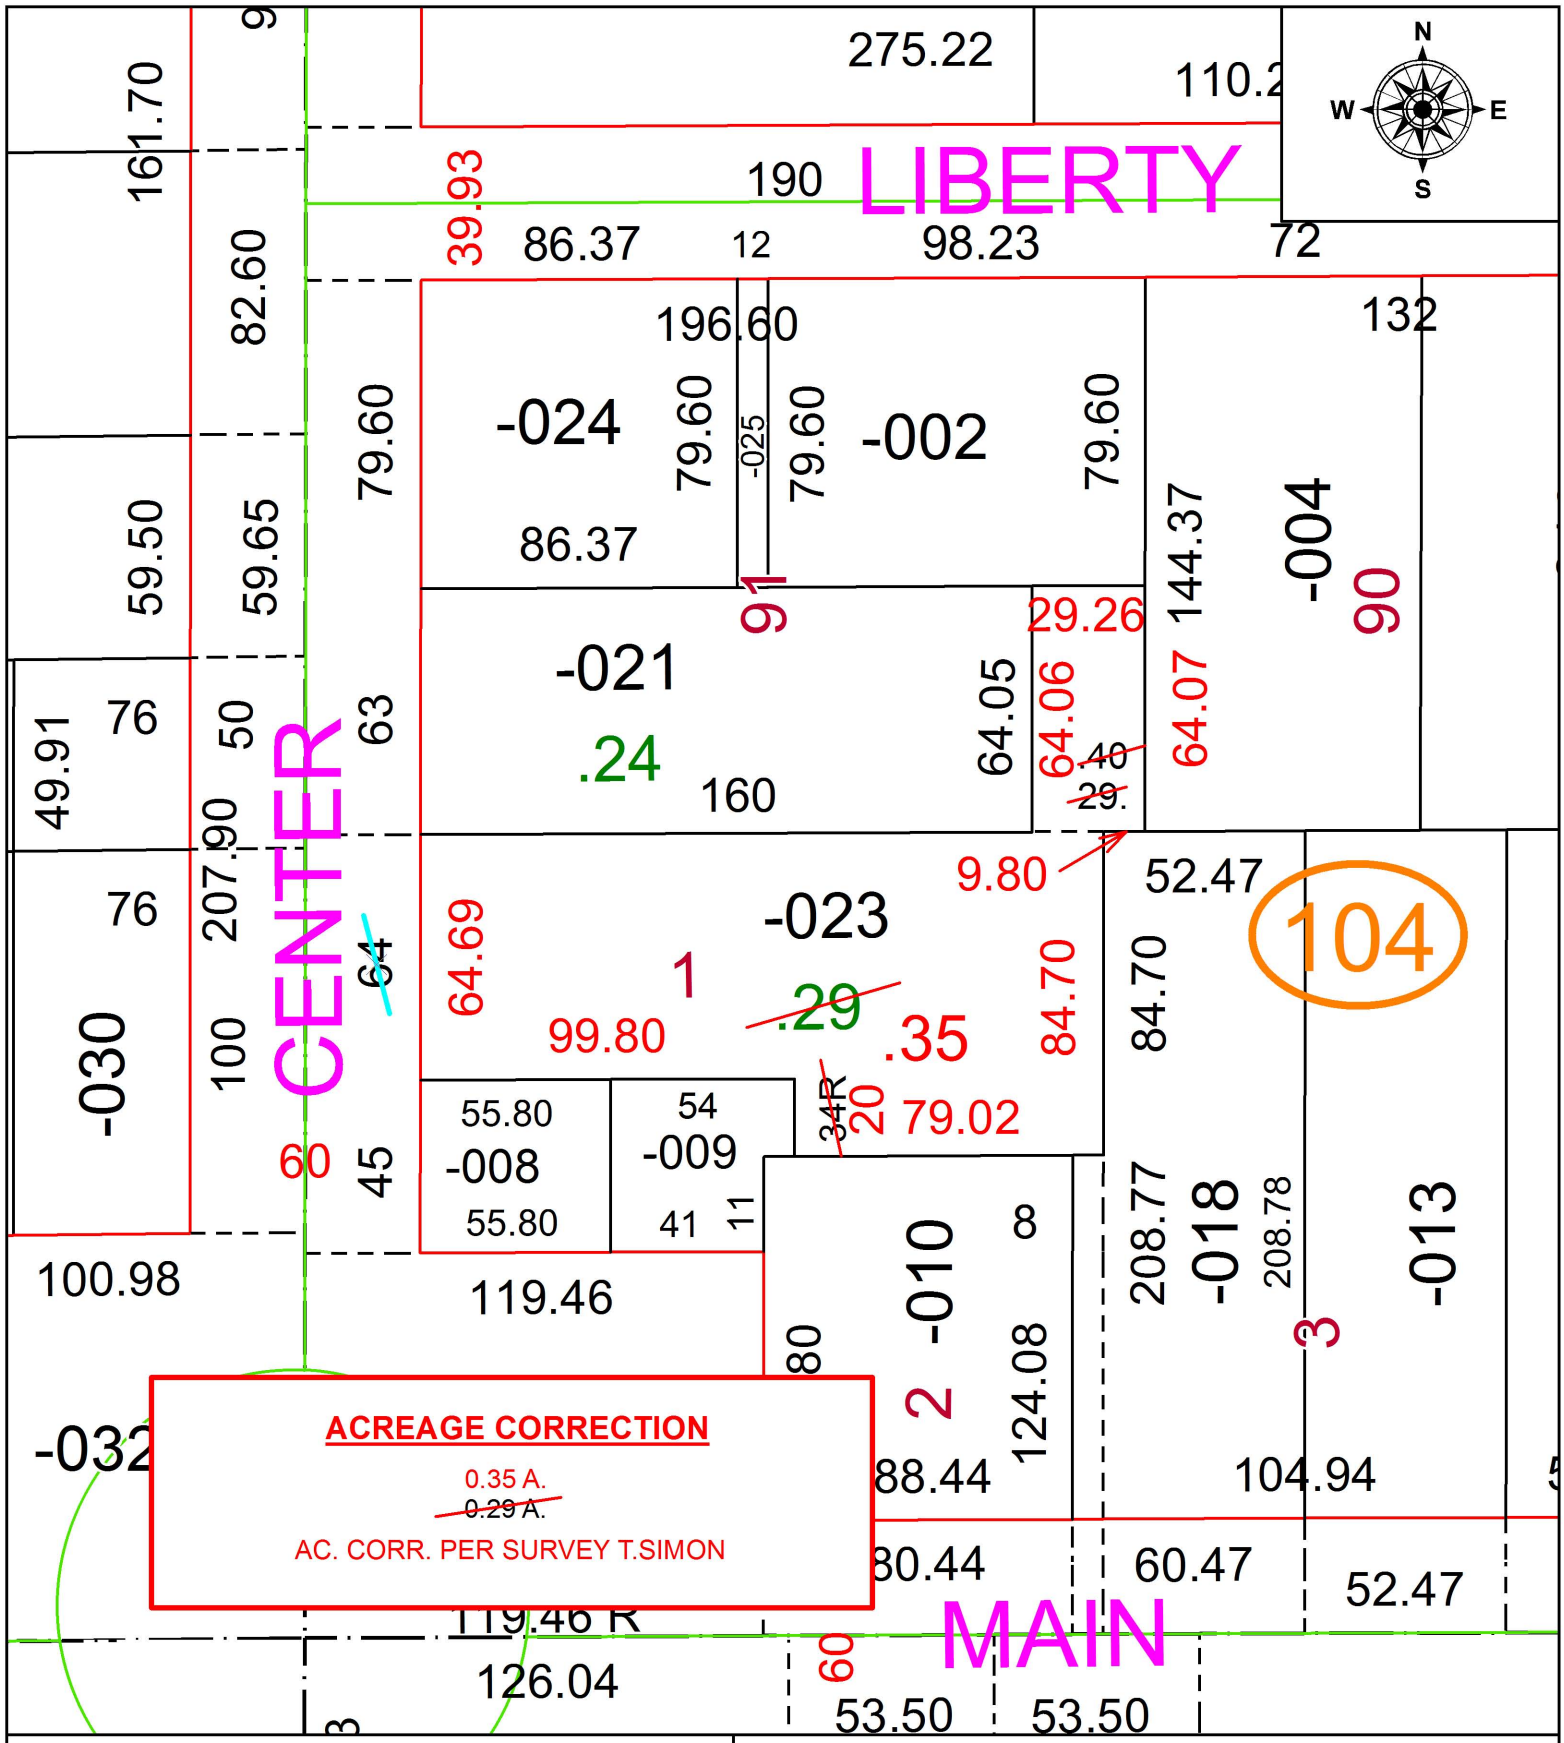


**ACREAGE CORRECTION**

0.35 A.
~~0.29 A.~~

AC. CORR. PER SURVEY T.SIMON

**SPLITS/DEEDS PROCESSED**

LORAIN COUNTY TAX MAP DEPARTMENT
226 MIDDLE AVE. ELYRIA, OH

SURVEYED BY: THOMAS A. SIMON
CLOSURE: 1: 67,146
MAP PAGE(S): 15-00-046-A
APPOVED BY: RRM DATE: 2-25-16
SCALE: 1" = 50 PRIOR INSTRUMENT: 19970505991