PARENT PARCEL: 07-00-028-102-142
CHILD PARCEL: XX-XX-XXX-XXX-XXX
STARTING POINT: CL OF AVON-BELDEN RD. & N.W. CORNER OF BLASER DV 143 PG. 452

16-03407-C

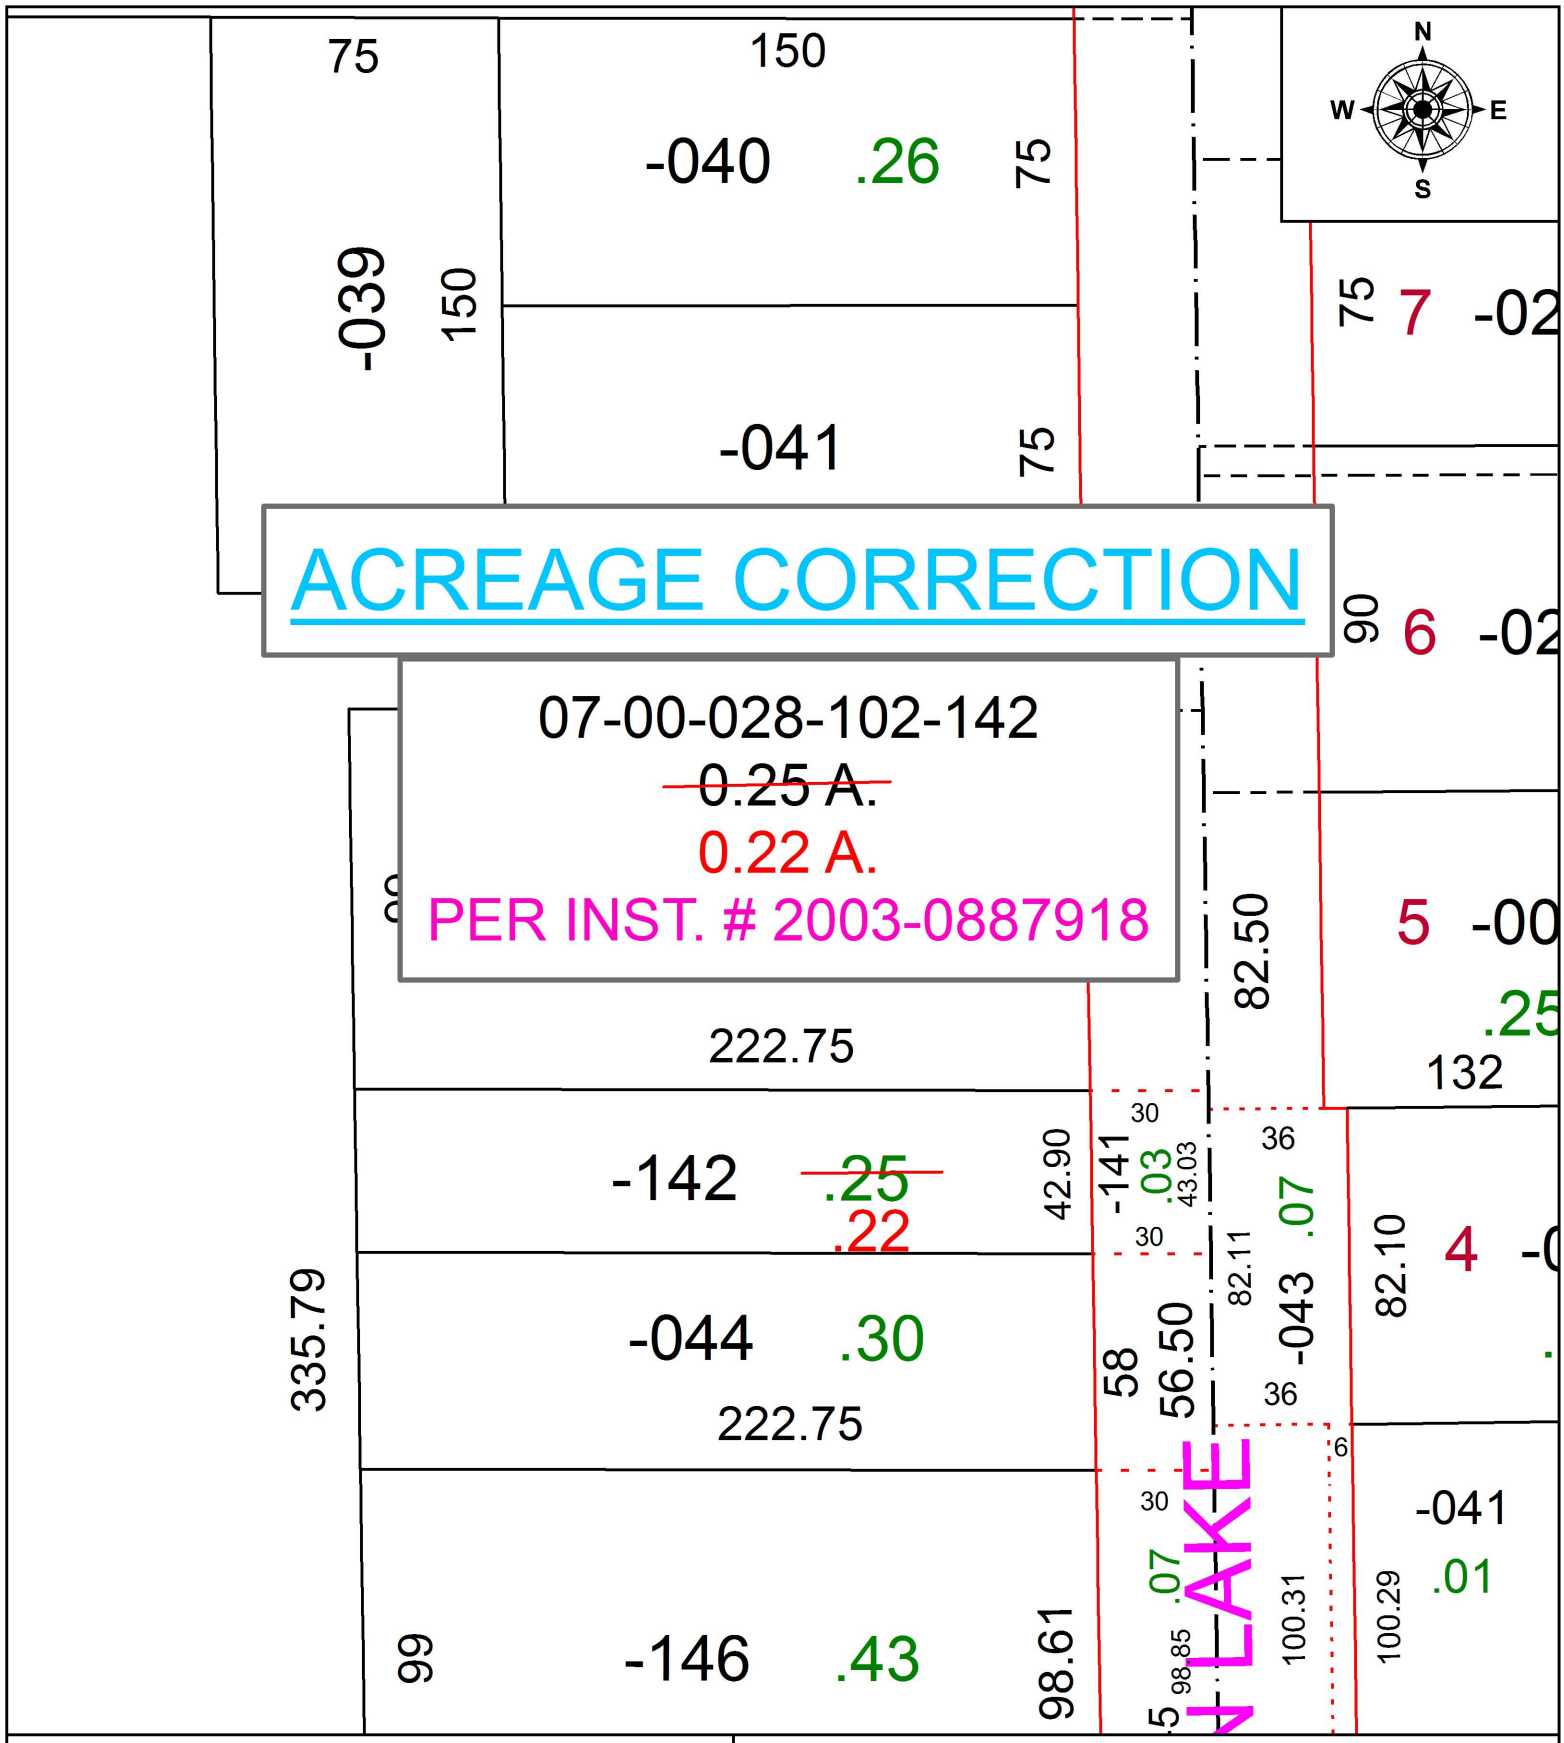

SPLITS/DEEDS PROCESSED
LORAIN COUNTY TAX MAP DEPARTMENT
226 MIDDLE AVE. ELYRIA, OH

SURVEYED BY: NA
CLOSURE: 0.00 : 10,000
MAP PAGE(S): 07-00-028
APPOVED BY: TJS **DATE:** 3/23/16
SCALE: 1" = 200 **PRIOR INSTRUMENT:** DV XXXX/XXXX