PARENT PARCEL: 07-00-008-700-015
CHILD PARCEL: XX-XX-XXX-XXX-XXX
STARTING POINT:

16-03408-C

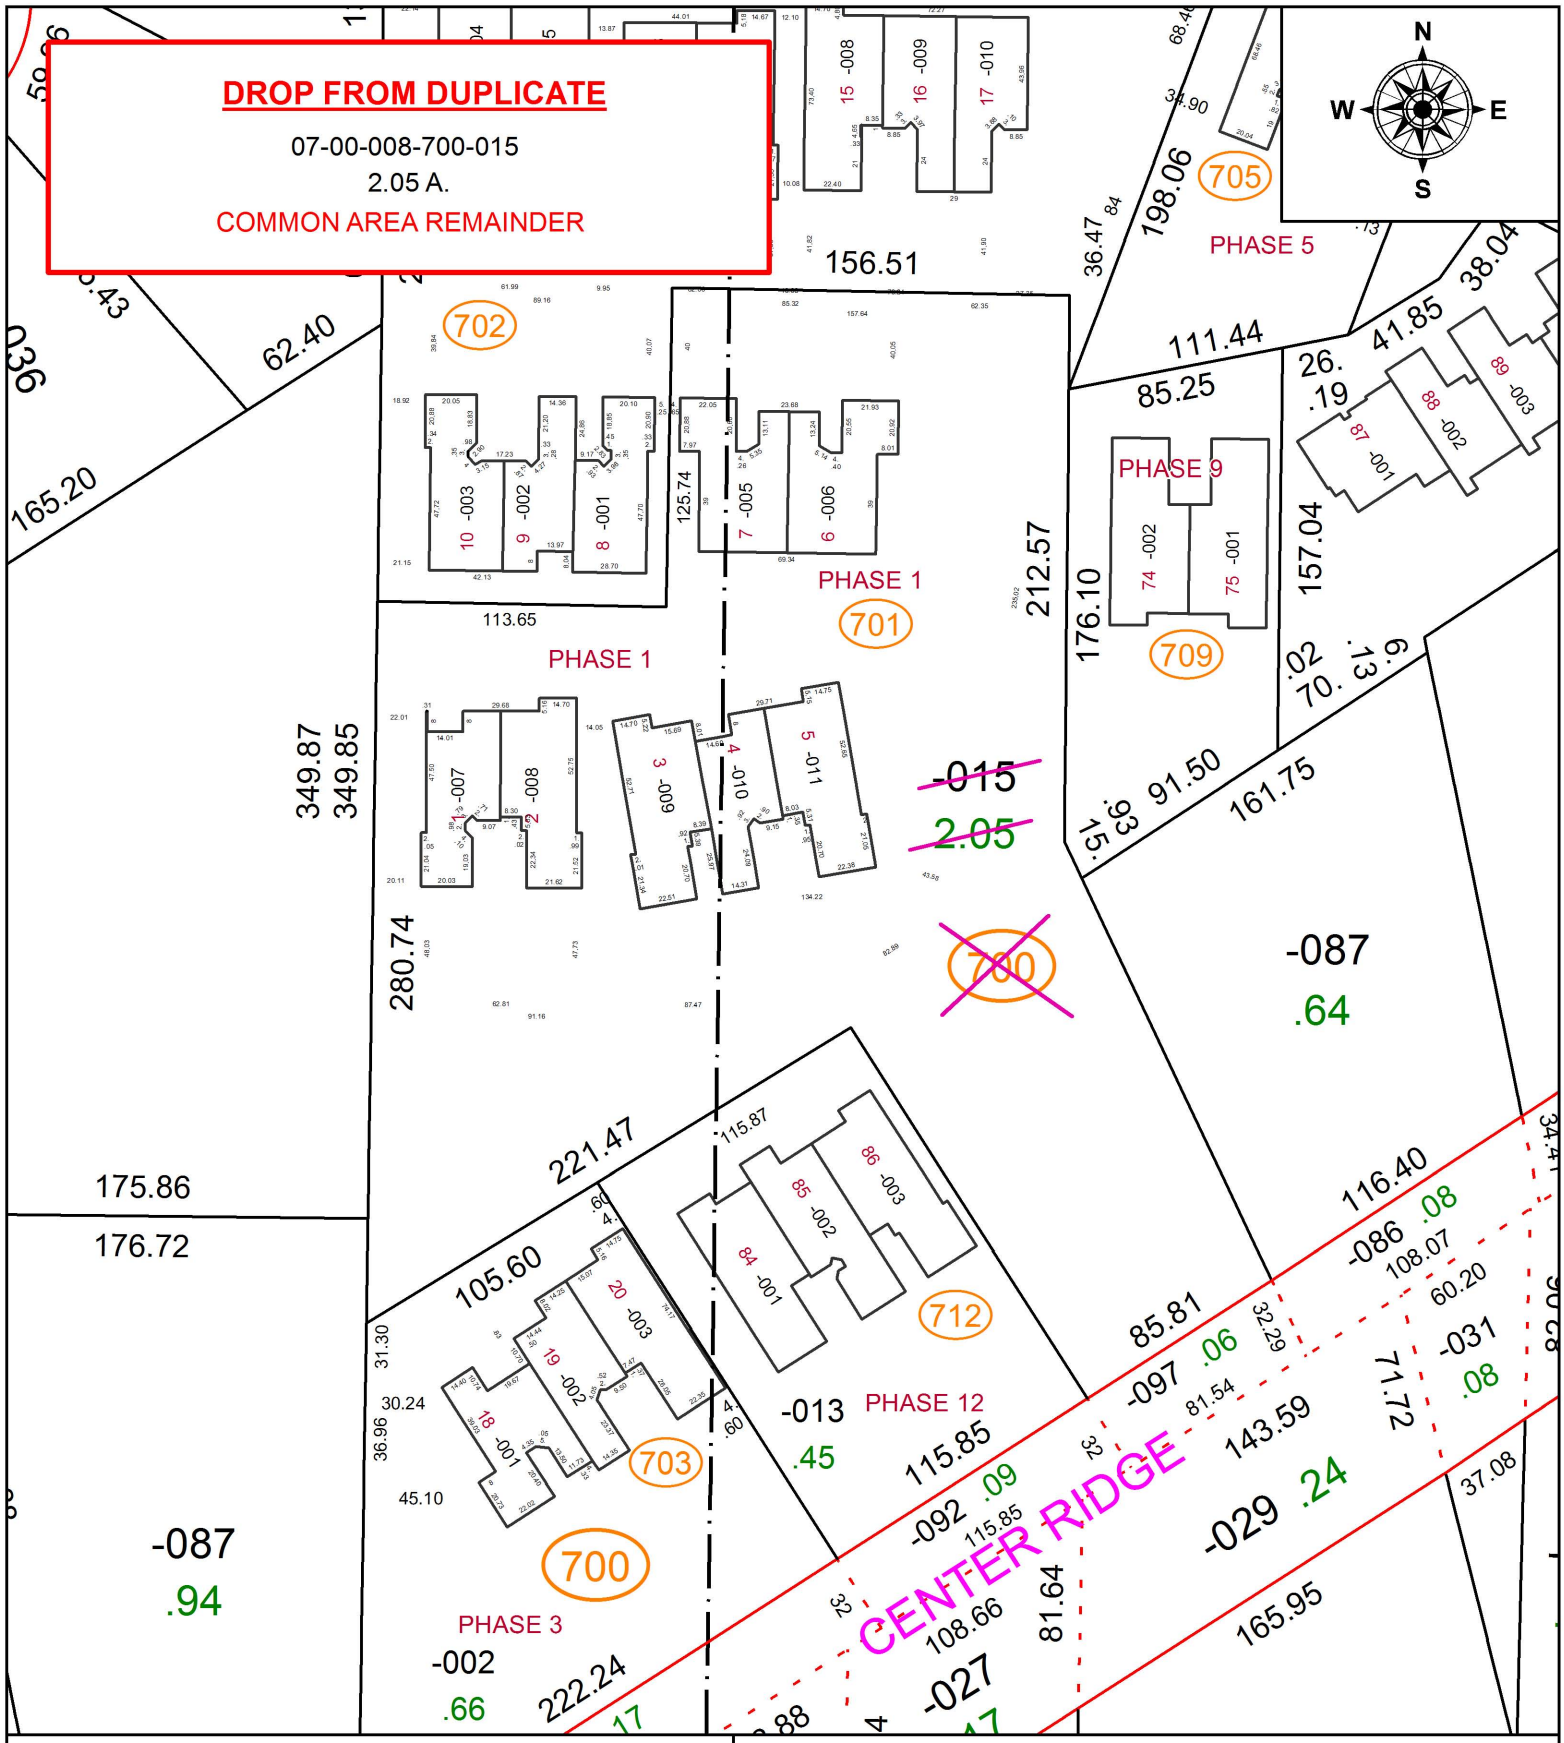

SPLITS/DEEDS PROCESSED
LORAIN COUNTY TAX MAP DEPARTMENT
226 MIDDLE AVE. ELYRIA, OH

SURVEYED BY: N/A
CLOSURE: N/A
MAP PAGE(S): 7-00-008
APPOVED BY: RRM **DATE:** 3-24-16
SCALE: 1" = 75 **PRIOR INSTRUMENT:** N/A