**PARENT PARCEL:** 07-00-017-700-002
**CHILD PARCEL:** XX-XX-XXX-XXX-XXX
**STARTING POINT:**

**16-03410-C**

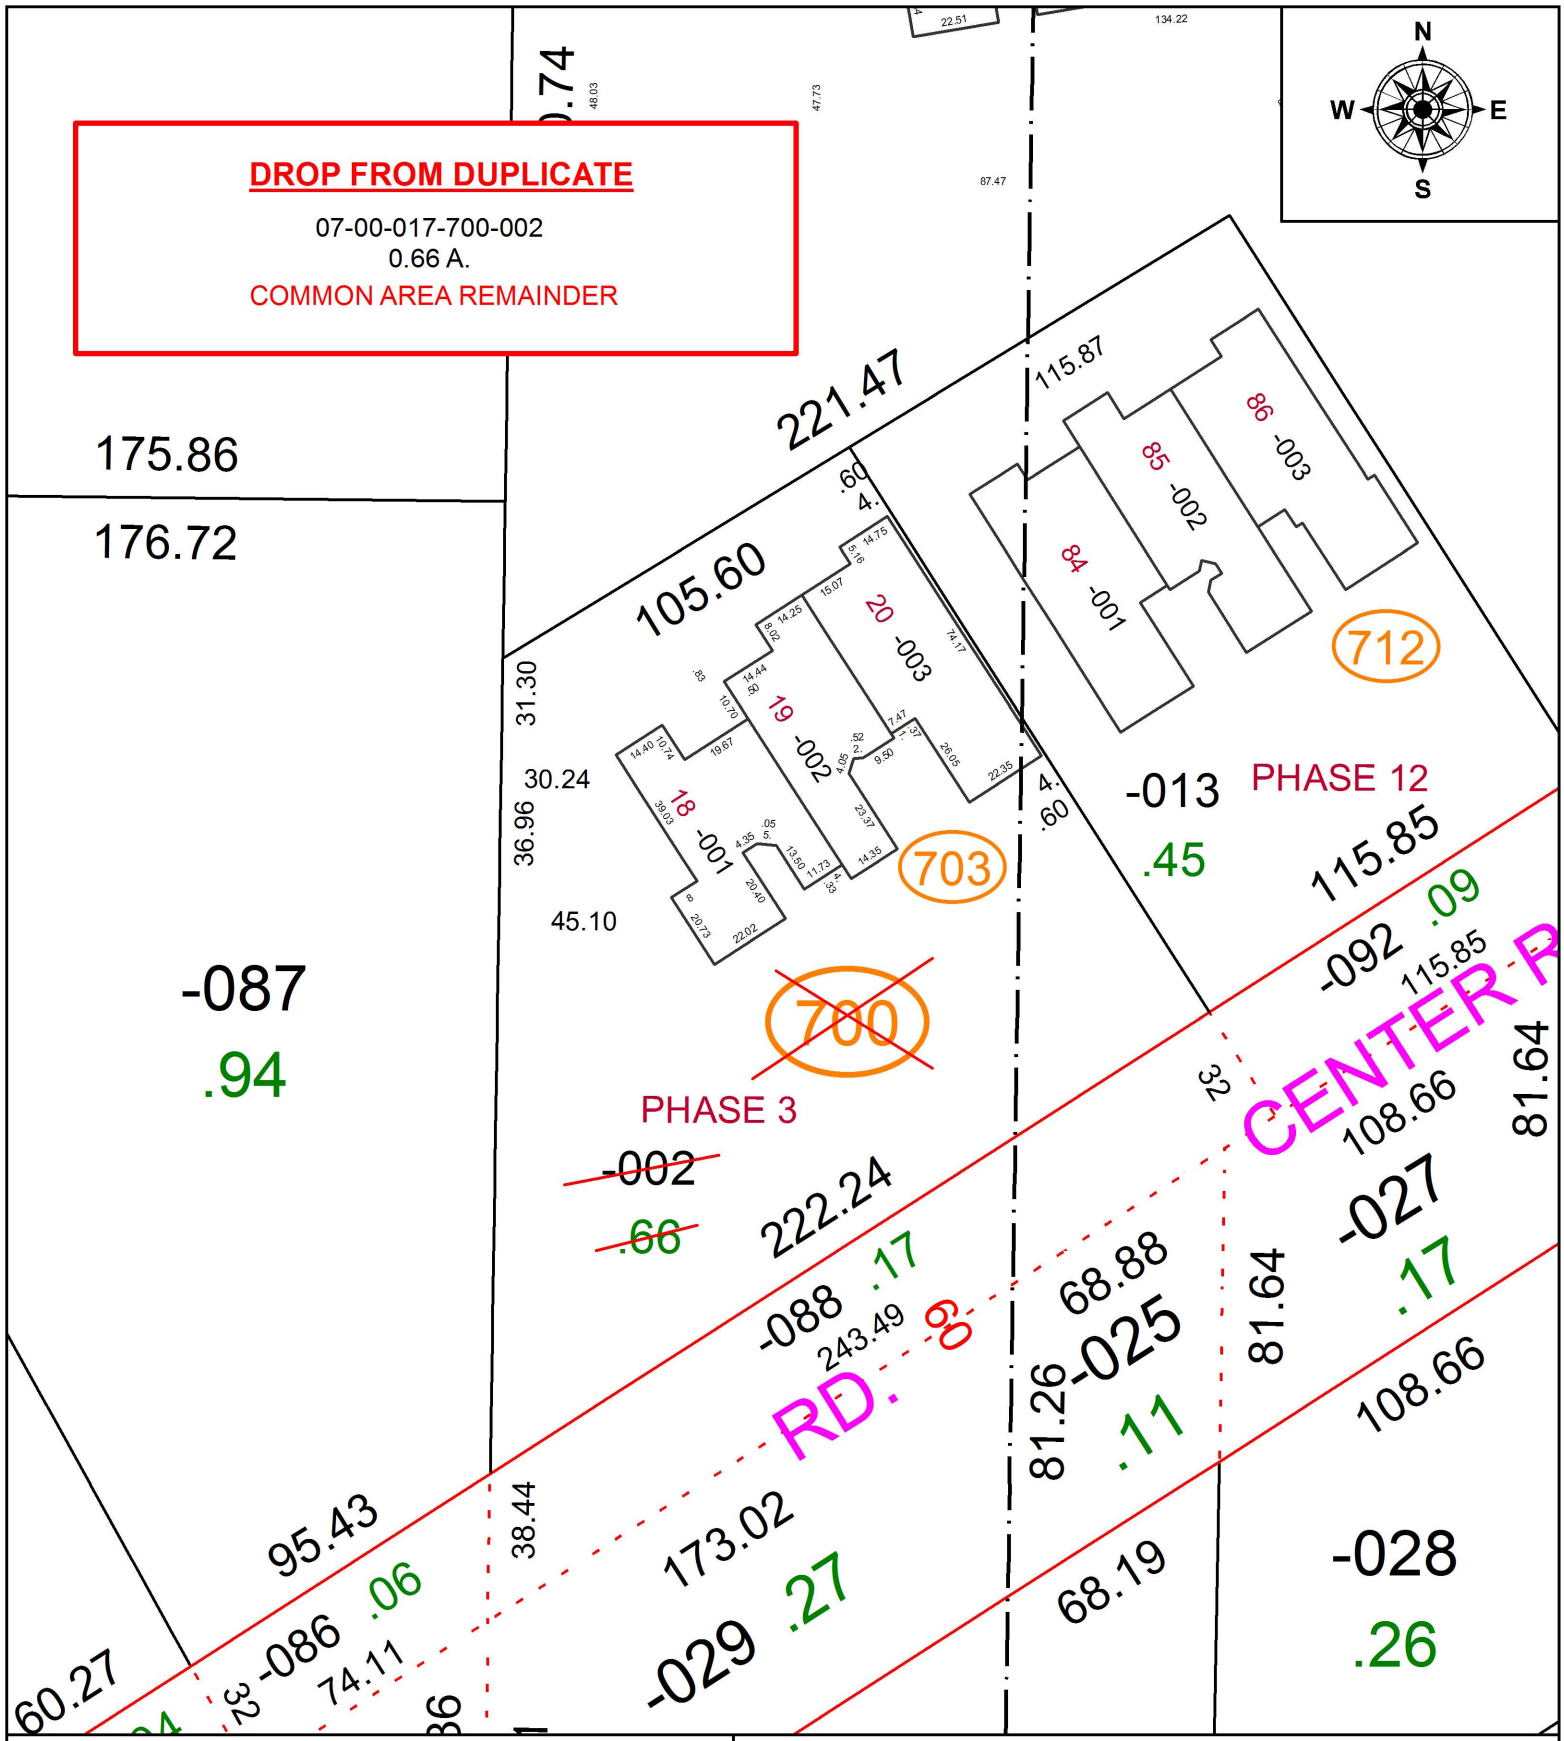


**SPLITS/DEEDS PROCESSED**
LORAIN COUNTY TAX MAP DEPARTMENT
226 MIDDLE AVE. ELYRIA, OH

**SURVEYED BY:** N/A
**CLOSURE:** N/A
**MAP PAGE(S):** 3-00-099-B
**APPOVED BY:** RRM **DATE:** 3-25-16
**SCALE:** 1" = 50 **PRIOR INSTRUMENT:** N/A