**PARENT PARCEL:** 10-00-024-000-197
**CHILD PARCEL:** XX-XX-XXX-XXX-XXX
**STARTING POINT:** INTERSECTION OF C/L OF CARRINGTON DR. AND C/L OF ALEXIS DR.

# 16-03413-C

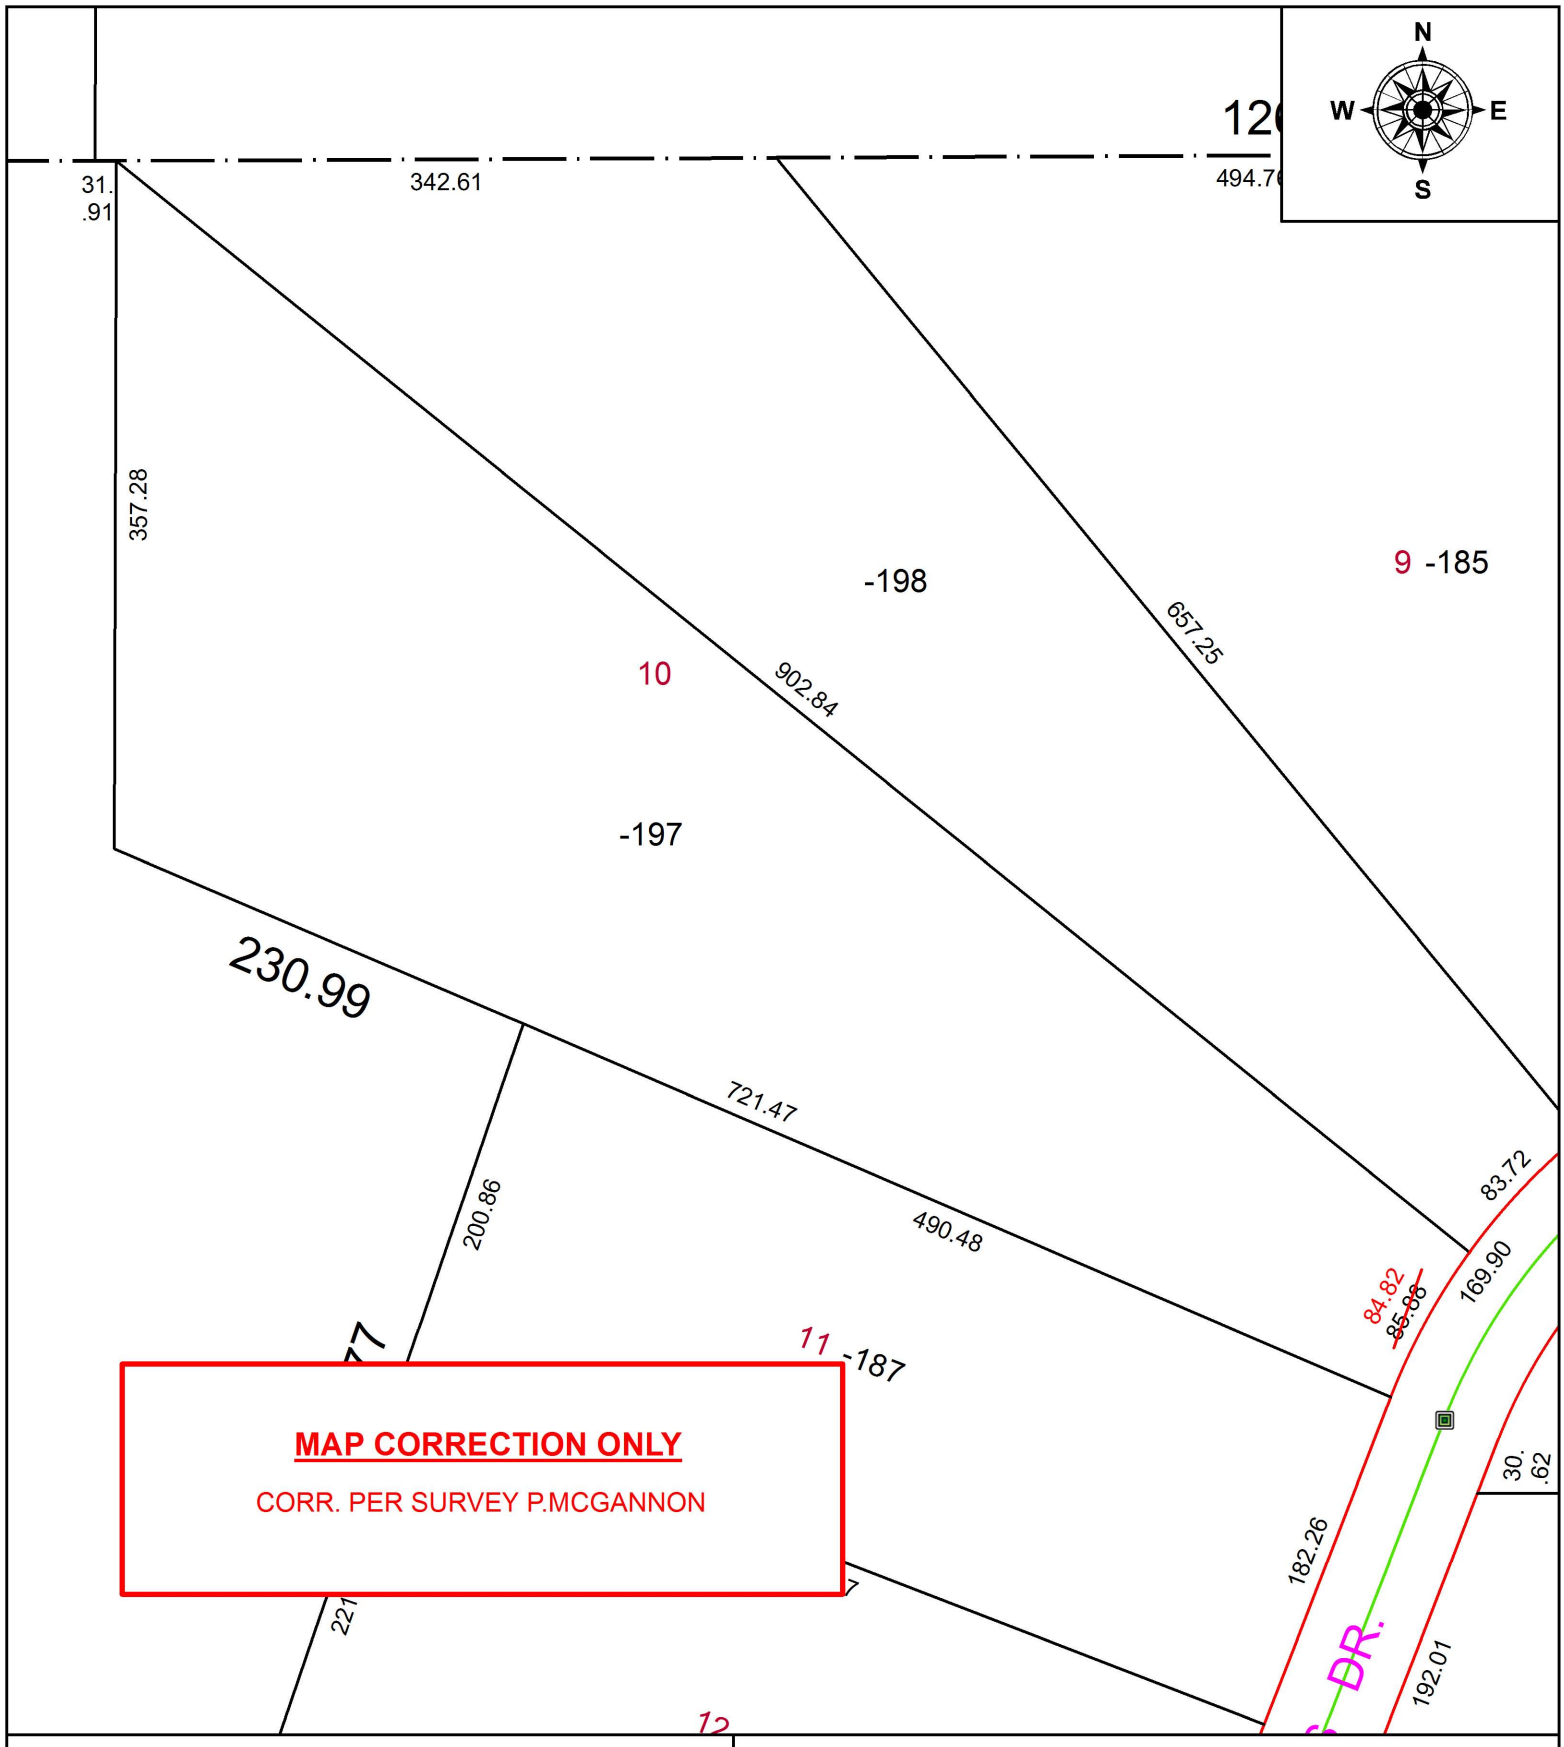


**SPLITS/DEEDS PROCESSED**
LORAIN COUNTY TAX MAP DEPARTMENT
226 MIDDLE AVE. ELYRIA, OH

**SURVEYED BY:** PATRICK A. MCGANNON
**CLOSURE:** 1: 510,402
**MAP PAGE(S):** 10-00-024-B
**APPOVED BY:** RRM **DATE:** 4-6-16
**SCALE:** 1" = 100 **PRIOR INSTRUMENT:** 20130472058