PARENT PARCEL: 11-00-097-000-031, 11-00-096-000-042

CHILD PARCEL: 11-00-097-000-040, -041 11-00-096-000-046, -047

STARTING POINT: CENTERLINE OF GRAFTON RD & CAPEL RD

15-03416

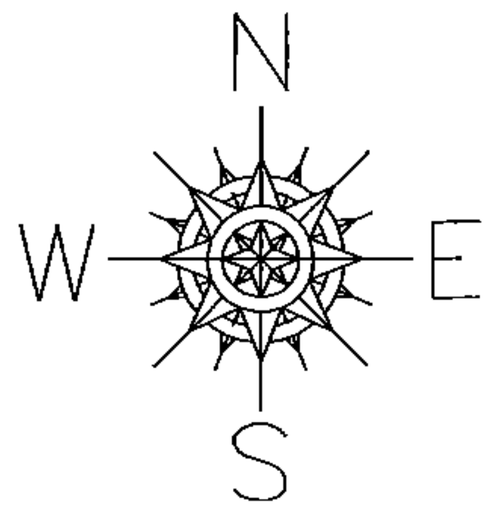

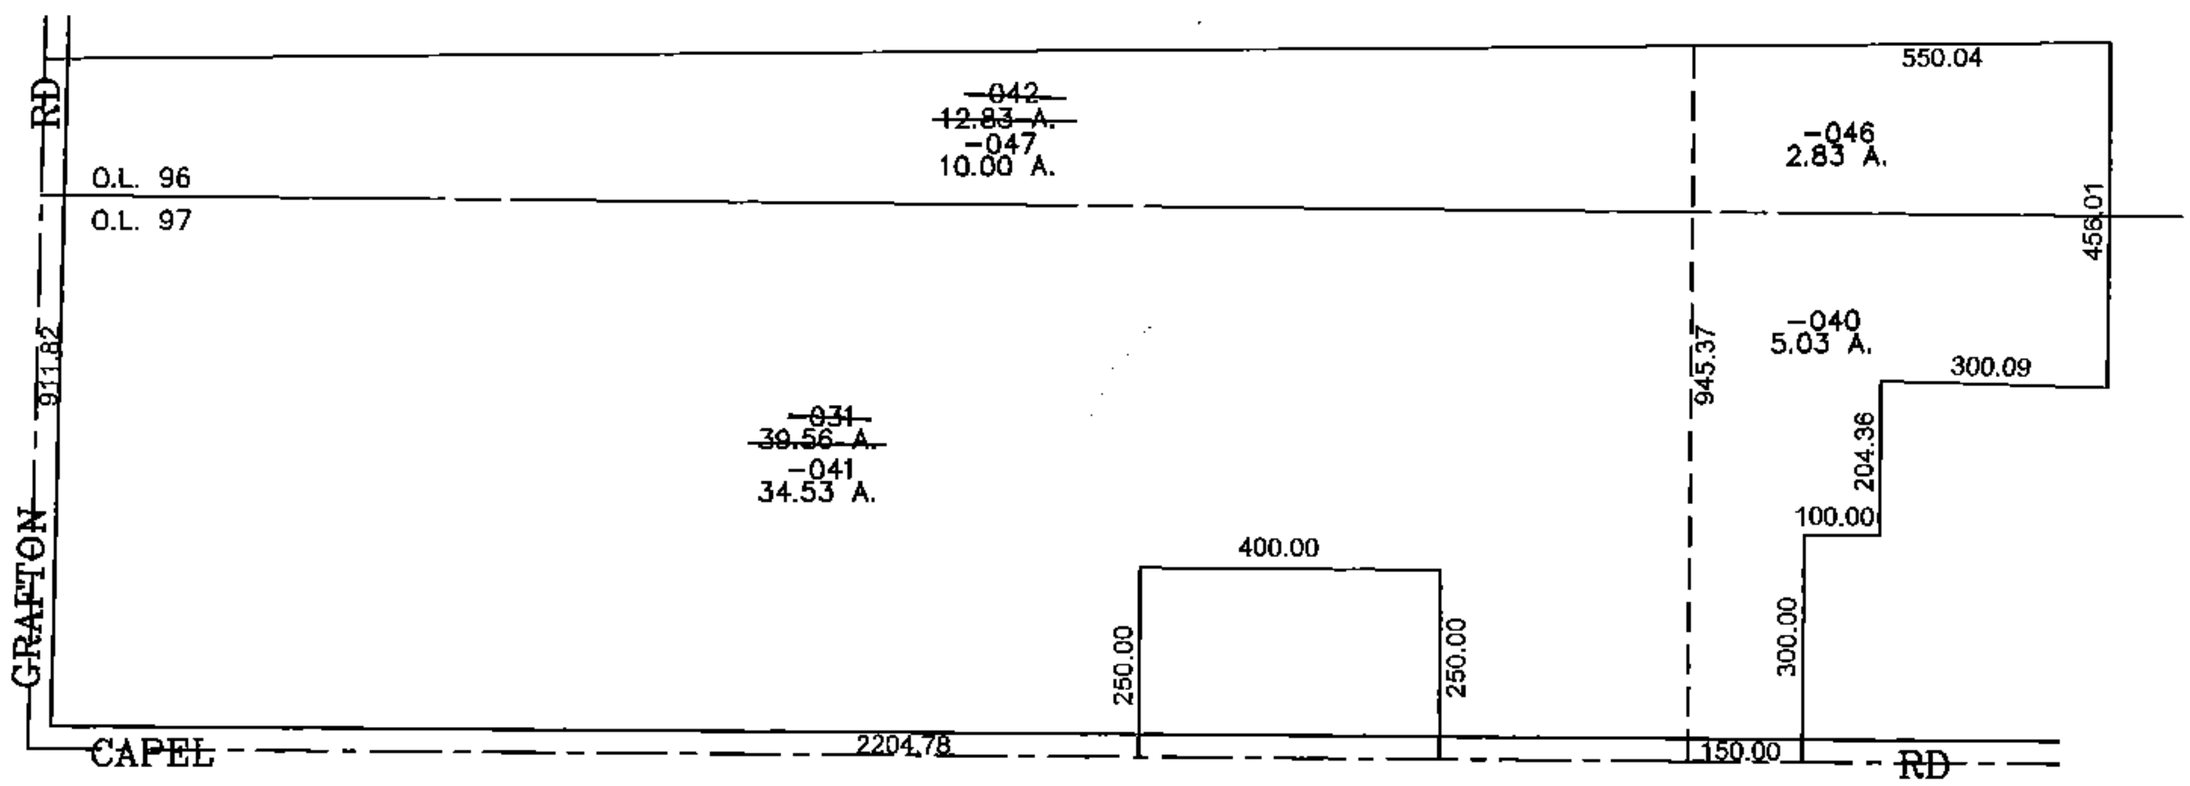

SPLITS/DEEDS PROCESSED

LORAIN COUNTY TAX MAP DEPARTMENT
226 MIDDLE AVE. ELYRIA, OHIO

SURVEYED BY: CHRISTOPHER DEMPSEY

CLOSURE: 0.00 : 10,000

MAP PAGE(S): 11-E NORTH

APPROVED BY: JAH DATE: 9/1/2015

SCALE: 1"= 400 PRIOR INST.: 20120402290