PARENT PARCEL: 02-01-003-114-015
CHILD PARCEL: XX-XX-XXX-XXX-XXX
STARTING POINT: INTERSECTION OF EAST LINE OF F ST. AND NORTH LINE OF 5TH ST.

16-03418-X

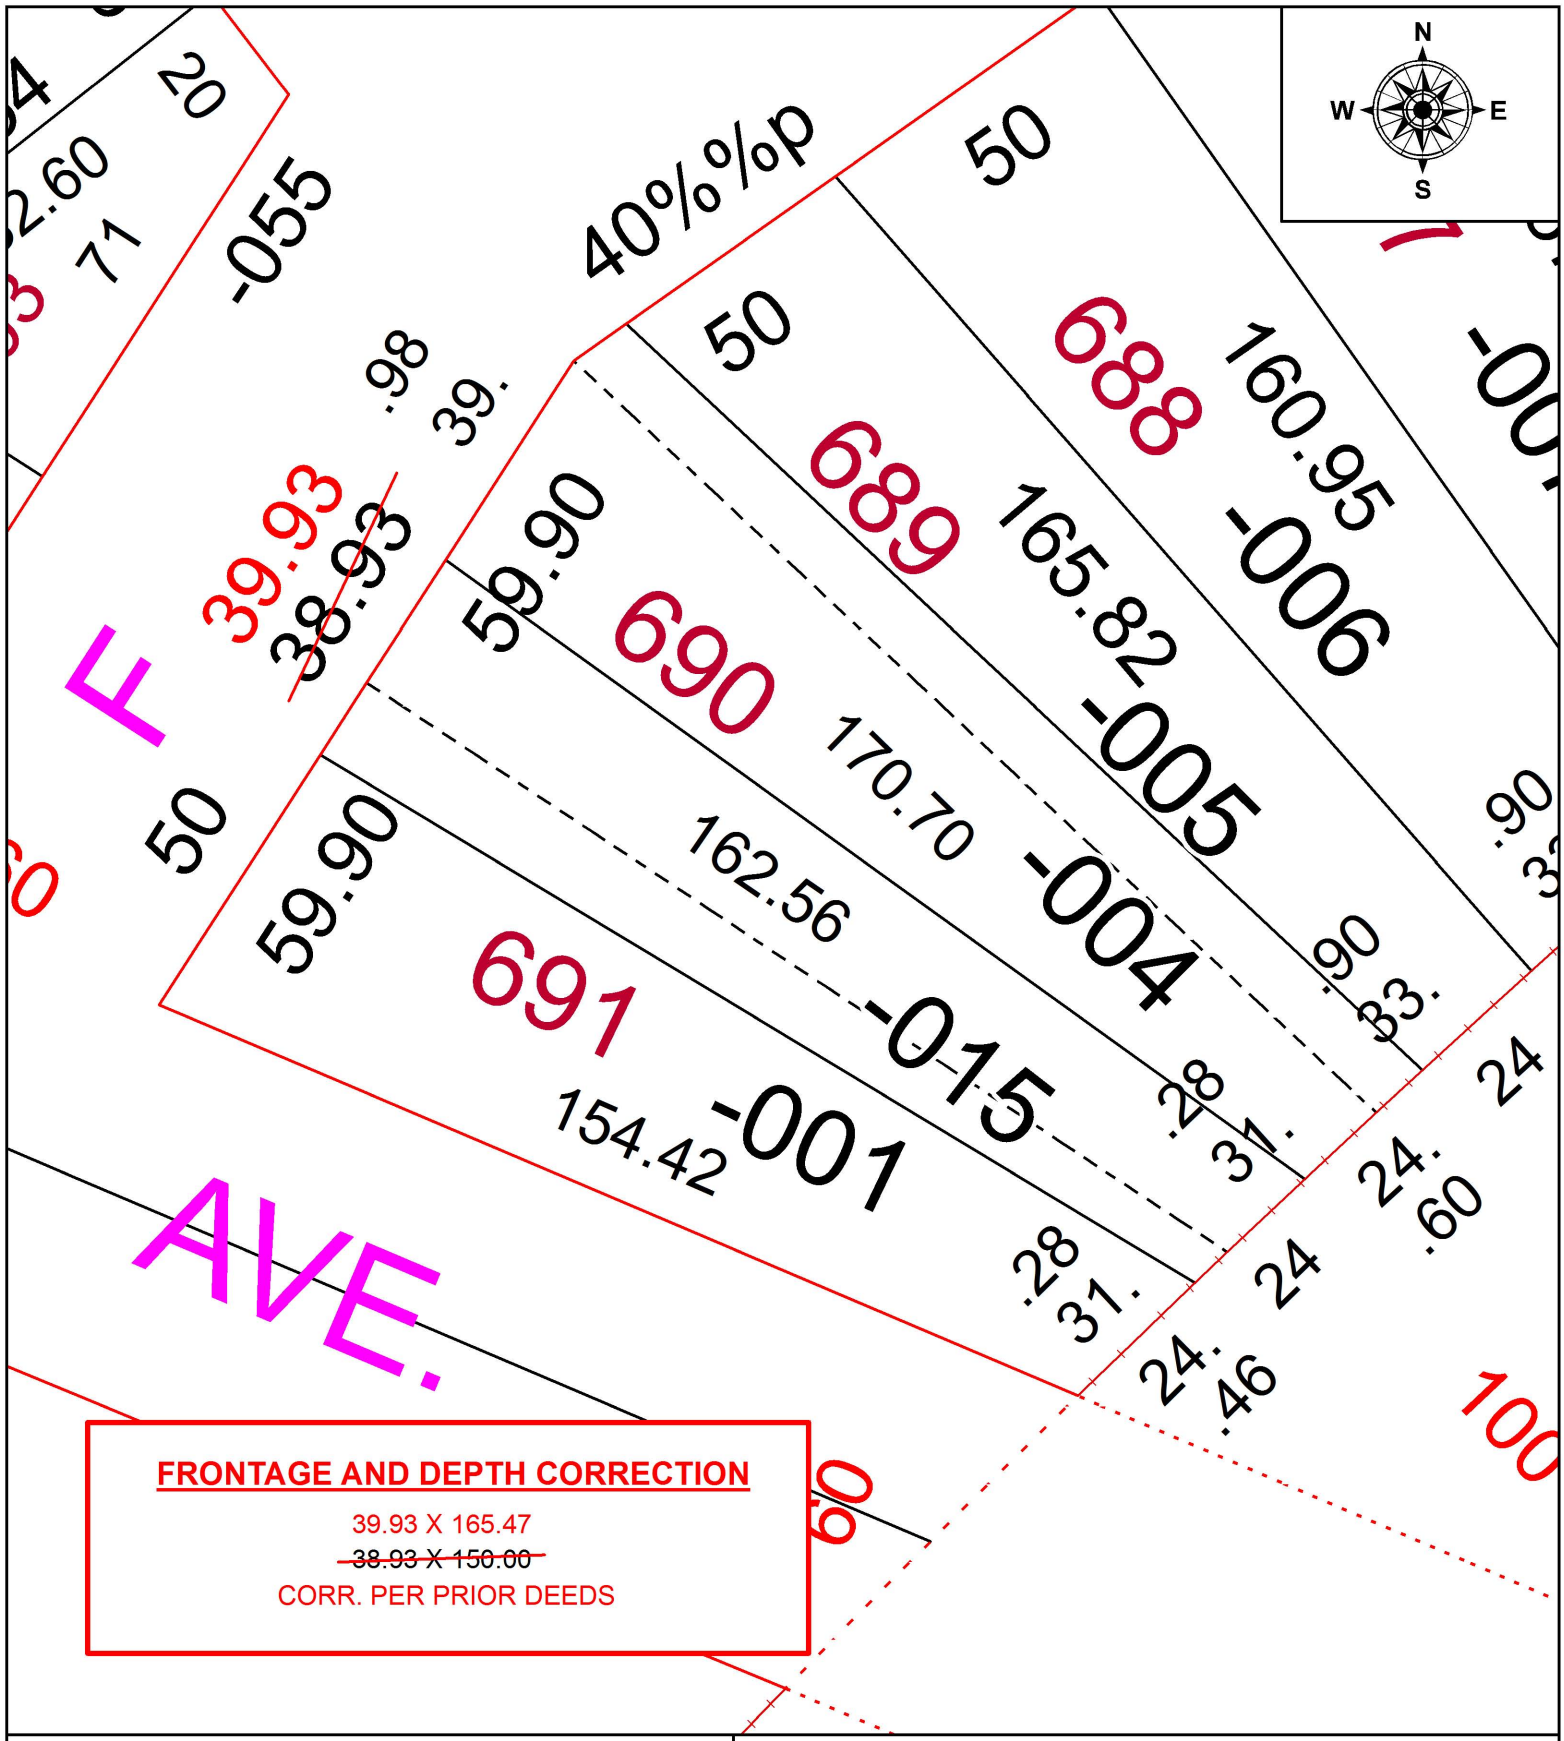

SPLITS/DEEDS PROCESSED
LORAIN COUNTY TAX MAP DEPARTMENT
226 MIDDLE AVE. ELYRIA, OH

SURVEYED BY: N/A
CLOSURE: N/A
MAP PAGE(S): 2-01-003
APPOVED BY: RRM **DATE:** 4-11-16
SCALE: 1" = 30 **PRIOR INSTRUMENT:** 20160580602