PARENT PARCEL: 05-00-047-000-029

CHILD PARCEL: XX-XX-XXX-XXX-XXX

STARTING POINT: NORTHEAST CORNER OF O.L.47

16-03434-A

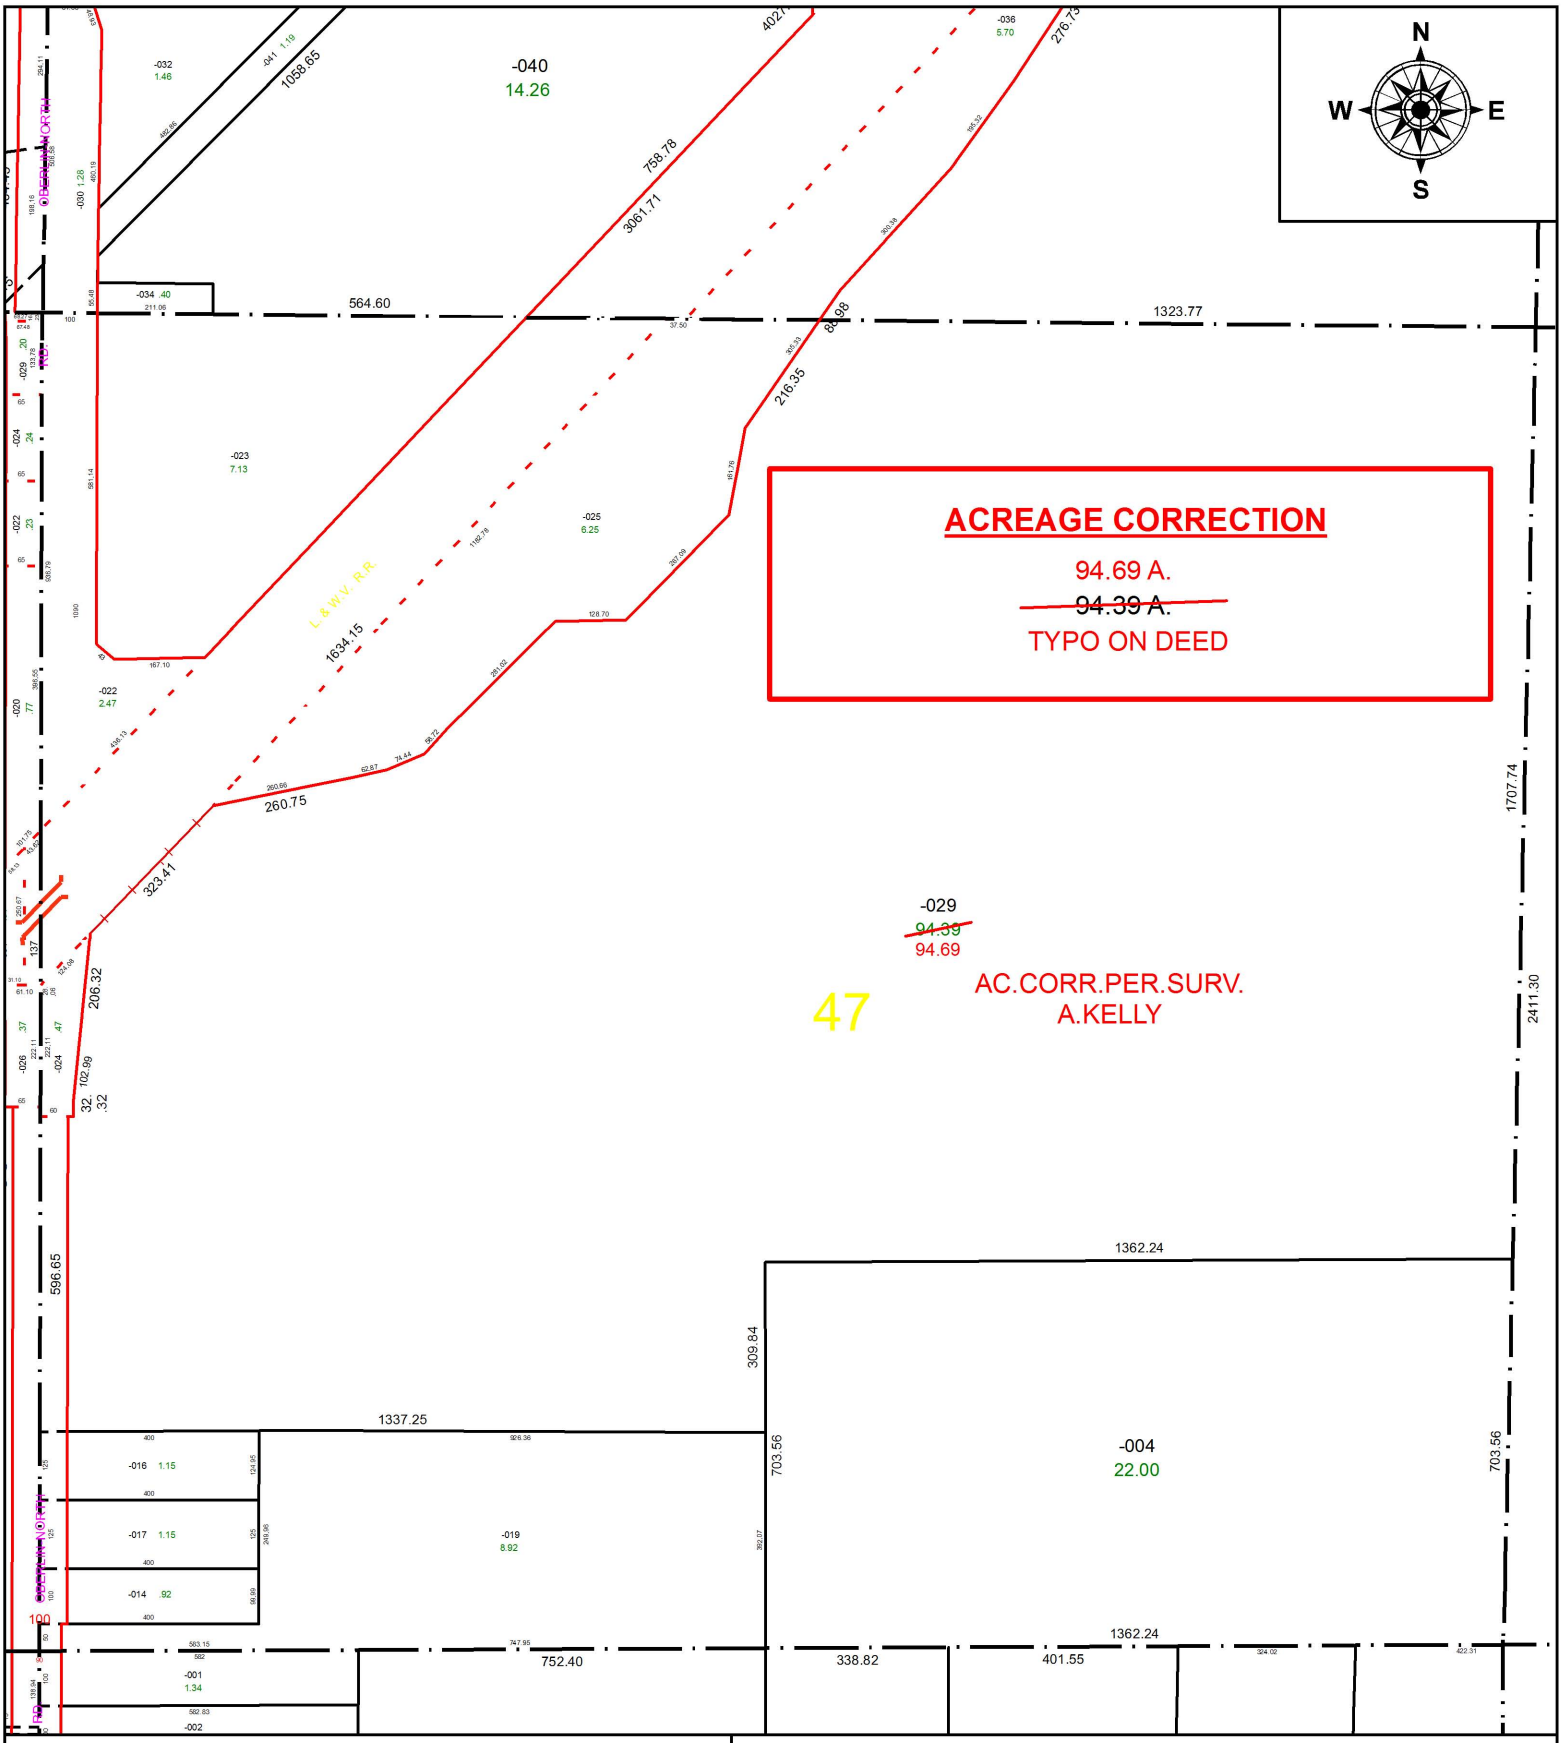

ACREAGE CORRECTION

94.69 A.

~~94.39 A.~~

TYPO ON DEED

SPLITS/DEEDS PROCESSED

LORAIN COUNTY TAX MAP DEPARTMENT
226 MIDDLE AVE. ELYRIA, OH

SURVEYED BY: AMY M. KELLY
CLOSURE: N/A
MAP PAGE(S): 5-00-047
APPOVED BY: RRM **DATE:** 4-21-16
SCALE: 1" = 350 **PRIOR INSTRUMENT:** 20120401186